

*Jamie*  
1/16/96


39°40' LATITUDE 4,650

NORTH

FED. BANK OF BALTIMORE

JOHN W. & SHIRLEY JONES  
30.00 ACRES


JONES

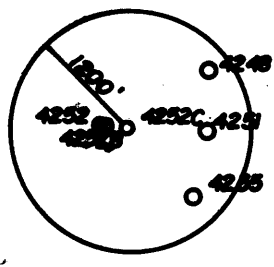

(+) DENOTES LOCATION OF WELL ON UNITED STATES TOPOGRAPHIC MAPS

FILE NO. \_\_\_\_\_  
DRAWING NO. \_\_\_\_\_  
SCALE 1" = 300'  
MINIMUM DEGREE OF ACCURACY 1 IN 5000  
PROVEN SOURCE OF ELEVATION COMPANY SURVEY  
TIED INTO U.S.G.S. NETWORK

I THE UNDERSIGNED, HEREBY CERTIFY THAT THIS PLAT IS CORRECT TO THE BEST OF MY KNOWLEDGE AND BELIEF AND SHOWS ALL THE INFORMATION REQUIRED BY LAW AND THE REGULATIONS ISSUED AND PRESCRIBED BY THE DEPARTMENT OF ENERGY.  
(SIGNED) Paul D. Harbert  
R.P.E. \_\_\_\_\_ L.L.S. 862

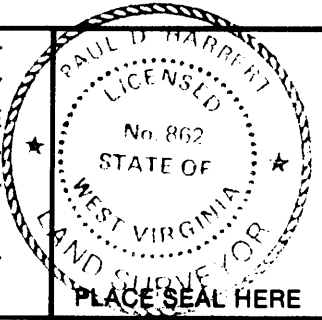

STATE OF WEST VIRGINIA  
DEPARTMENT OF ENERGY  
OIL AND GAS DIVISION



DATE 10-11, 19 94  
OPERATOR'S WELL NO. 4252C  
API WELL NO. \_\_\_\_\_

WELL TYPE: OIL \_\_\_ GAS \_\_\_ LIQUID INJECTION \_\_\_ WASTE DISPOSAL \_\_\_  
(IF "GAS,") PRODUCTION \_\_\_ STORAGE \_\_\_ DEEP \_\_\_ SHALLOW X ABANDONED X  
LOCATION: ELEVATION 1380.57 WATERSHED RANGE RUN  
DISTRICT BATTELLE COUNTY MONONGALIA  
QUADRANGLE WADESTOWN WV-PA  
SURFACE OWNER JOHN W. & SHIRLEY JONES ACREAGE 30.00  
OIL & GAS ROYALTY OWNER \_\_\_\_\_ LEASE ACREAGE \_\_\_\_\_

PROPOSED WORK: DRILL \_\_\_ CONVERT \_\_\_ DRILL DEEPER \_\_\_ REDRILL \_\_\_ FRACTURE OR STIMULATE \_\_\_ PLUG OFF OLD FORMATION \_\_\_ PERFORATE NEW FORMATION \_\_\_ OTHER PHYSICAL CHANGE IN WELL (SPECIFY) \_\_\_\_\_

PLUG AND ABANDON \_\_\_ CLEAN OUT AND REPLUG \_\_\_  
TARGET FORMATION NONE ESTIMATED DEPTH \_\_\_\_\_  
WELL OPERATOR CONSOLIDATION COAL COMPANY DESIGNATED AGENT ROGER E. DUCKWORTH  
ADDRESS PO. BOX 1314 MORGANTOWN, WV 26505 ADDRESS PO. BOX 1314 MORGANTOWN, WV 26505

FORM WW-6 HALLS INC. 068065

COUNTY NAME PERMIT

STATE OF WEST VIRGINIA  
DEPARTMENT OF ENERGY  
OIL AND GAS WELLS DIVISION

AFFIDAVIT OF PLUGGING AND FILLING WELL

AFFIDAVIT SHOULD BE MADE IN TRIPLICATE, one copy mailed to the Division, one copy to be retained by the Well Operator and the third copy (and extra copies if required) should be mailed to each coal operator at their respective addresses.

CONSOLIDATION COAL COMPANY  
Coal Operator or Owner  
P.O. BOX 1314, MORGANTOWN, WV, 26507-1314  
Address

---

Coal Operator or Owner  
Address  
JOHN & SHIRLEY JONES  
Lease or Property Owner  
Address

CONSOLIDATION COAL COMPANY  
Name of Well Operator  
P.O. BOX 1314, MORGANTOWN, WV 26507-1314  
Complete Address

OCTOBER 16 19 96

WELL AND LOCATION  
BATTELLE District  
MONONGALIA County

WELL NO. 4252C

STATE INSPECTOR SUPERVISING PLUGGING JOHN & SHIRLEY JONES Farm  
*Randall Mink*

AFFIDAVIT

STATE OF WEST VIRGINIA,  
County of HARRISON  
G. ANDREW LANG

ss:

and NICKY BYRE *Kevin Wright*

being first duly sworn according to law depose and say that they are experienced in the work of plugging and filling oil and gas wells and were employed by CONSOLIDATION COAL COMPANY, well operator, and participated in the work of plugging and filling the above well, that said work was commenced on the 21ST day of AUGUST, 19 96, and that the well was plugged and filled in the following manner:

Sand or Zone Record Formation	Filling Material	Plugs Used Size & Kind	Casing	
			CSG PULLED	CSG LEFT IN
Clean 9 7/8" to 810' top of 8" hole to 1,626'. Pull 19.04' of it to pull 8" casing. Pull 8" from 1,210' to 1,238'. 8" casing from form 1,238' to 1,388'. Ran coal protection string as follows: 170.39' of 2 3/8" tubing followed by 1,402.57' of 4 1/2" tubing from 1,572.96' back to surface using thixotropic cement. Used 1,000 gallons of mud flush. Latch down plug at 1,374.06'. Float valve at 1,402.57'. Swedge at 1,403.57'. Cement did circulate. Displaced cement to 1,374.06' with water; let set and bailed dry. TOTAL DEPTH: 1,626'.	Reduce hole to 7 7/8". Clean 7 7/8" 10 3/4" casing. Had difficulty getting through casing from 1,210'. Section mill 8" casing cemented from 1,214' to 1,234'. Pulled 8" casing as follows:			
		8 5/8" CASING		
Coal Seams		Description of Monument		
(Name) PITTSBURGH	1,218' to 1,226'	5' OF 4 1/2" CASING with plaque stating Consolidation Coal Co. Well #4252C Permit #47-061-1229-P		

and that the work of plugging and filling said well was completed on the 23RD day of SEPTEMBER, 19 96.

And further deponents G. Andrew Lang  
NOTARY PUBLIC  
STATE OF WEST VIRGINIA  
Charlotte, West Virginia  
Mt. Clara, WV 26408  
My commission expires June 29, 1999

*G. Andrew Lang*  
*Kevin Wright*  
Sworn to and subscribed before me this 16th day of October, 19 96.  
*Charlotte Heater*  
Notary Public

My commission expires: JUNE 29, 1999

47-061-1229P

Permit No.