


1.955
2.12

(+) DENOTES LOCATION OF WELL ON UNITED STATES TOPOGRAPHIC MAPS

FILE NO. _____
 DRAWING NO. _____
 SCALE 1" = 500'
 MINIMUM DEGREE OF ACCURACY 1 IN 5000
 PROVEN SOURCE OF ELEVATION COMPANY SURVEY TIED INTO U.S.G.S. NETWORK

I THE UNDERSIGNED, HEREBY CERTIFY THAT THIS PLAT IS CORRECT TO THE BEST OF MY KNOWLEDGE AND BELIEF AND SHOWS ALL THE INFORMATION REQUIRED BY LAW AND THE REGULATIONS ISSUED AND PRESCRIBED BY THE DEPARTMENT OF ENERGY.
 (SIGNED) Paul D. Harbert
 R.P.E. _____ L.L.S. 862

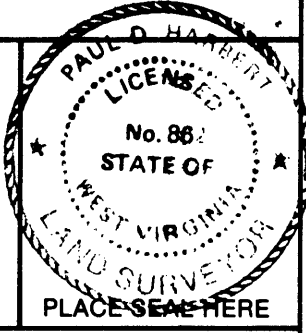

STATE OF WEST VIRGINIA
 DEPARTMENT OF ENERGY
 OIL AND GAS DIVISION

DATE 10-19, 19 94
 OPERATOR'S WELL NO. 4156
 API WELL NO. 47-61-01251-P

WELL TYPE: OIL ___ GAS ___ LIQUID INJECTION ___ WASTE DISPOSAL ___
 (IF "GAS,") PRODUCTION ___ STORAGE ___ DEEP ___ SHALLOW X ABANDONED X

LOCATION: ELEVATION 1191.82 WATER SHED RANGE RUN
 DISTRICT BATTELLE COUNTY MONONGALIA
 QUADRANGLE WADESTOWN WV, PA.

SURFACE OWNER JOHN C. KING ACREAGE 41.74
 OIL & GAS ROYALTY OWNER _____ LEASE ACREAGE _____
 LEASE NO. _____

PROPOSED WORK: DRILL ___ CONVERT ___ DRILL DEEPER ___ REDRILL ___ FRACTURE OR STIMULATE ___ PLUG OFF OLD FORMATION ___ PERFORATE NEW FORMATION ___ OTHER PHYSICAL CHANGE IN WELL (SPECIFY) _____

PLUG AND ABANDON X CLEAN OUT AND REPLUG _____
 TARGET FORMATION NONE ESTIMATED DEPTH _____

WELL OPERATOR CONSOLIDATION COAL CO. DESIGNATED AGENT ROGER E. DUCKWORTH
 ADDRESS P.O. BOX 1314 MORGANTOWN WV. 26505 ADDRESS P.O. BOX 1314 MORGANTOWN W.V. 26505

AUG 29 1996

FORM WW-6 HALLS INC. 068065

COUNTY NAME PERMIT

SEP 24 1997

AFFIDAVIT OF PLUGGING AND FILLING WELL

WV Division of
Environmental Protection

AFFIDAVIT SHOULD BE MADE IN TRIPLICATE, one copy mailed to the Division, one copy to be retained by the Well Operator and the third copy (and extra copies if required) should be mailed to each coal operator at their respective addresses.

CONSOLIDATION COAL COMPANY
Coal Operator or Owner
P.O. BOX 1314, MORGANTOWN, WV 26505
Address

Coal Operator or Owner
Address
SARAH AND L.L. PHILLIPS
Lease or Property Owner
Address

CONSOLIDATION COAL COMPANY
Name of Well Operator
P.O. BOX 1314, MORGANTOWN, WV 26505
Complete Address

OCTOBER 16 19 96

WELL AND LOCATION

BATTELLE District
MONONGALIA County

WELL NO. 4156

SARAH AND L.L. PHILLIPS Farm

STATE INSPECTOR SUPERVISING PLUGGING

AFFIDAVIT

STATE OF WEST VIRGINIA,
County of HARRISON

ss:


G. ANDREW LANG and Kevin Wright

being first duly sworn according to law depose and say that they are experienced in the work of plugging and filling oil and gas wells and were employed by CONSOLIDATION COAL COMPANY, well operator, and participated in the work of plugging and filling the above well, that said work was commenced on the 16th day of August, 19 96, and that the well was plugged and filled in the following manner:

Sand or Zone Record Formation	Filling Material	Plugs Used Size & Kind	Casing	
			C50 PULLED	C50 LEFT IN
Pulled 2" tubing from surface to 356.2'. Cemented from 320' to 350'. Cleaned hole with 11" bit from surface to 392', top of 7" casing. Pulled 7" casing from 392' to 1,462'. Left 7" casing in hole from 1,492 to unknown. Clean 9 7/8" hole 392' to 1,223'. Reduce hole to 7 7/8". Clean 7 7/8" hole from 1,223' to 1,462'. Reduce hole to 6 1/4". Clean 6 1/4" hole from 1,462 to 1,712'. Clean 9 7/8" hole thru protection string as follows: 490.47' of 2" followed by 1,200.60' of 4 1/2" casing. Cement hole from 1,691.07' back to surface using 630 sacks of poz mix and 240 sacks of thixotropic cement. Used 1,000 gallons of mud flush. Latch down plug at 1,168.30'. Float valve at 1,200.60'. Swedge at 1,201.60'. Cement did circulate. Displaced cement to 1,168.30' with water; let set and bailed dry.				
TOTAL DEPTH: 1,712'.				
Coal Seams			Description of Monument	
(Name) PITTSBURGH	1,005' TO 1,013'		5' of 4 1/2" casing with plaque stating Consolidation Coal Company Well #4156	
(Name)			Permit #47-61-01251-P	
(Name)				
(Name)				

and that the work of plugging and filling said well was completed on the 27th day of August, 19 96.

And further deponents saith not.

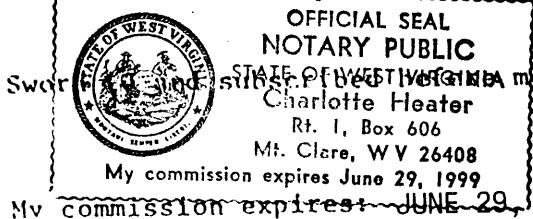

G. Andrew Lang
Kevin Wright
Charlotte Heater
Notary Public

Sworn and signed in presence of me this 16 day of October, 19 96.

OCT 08 1997