


MAY 26 2025



07/11/2025

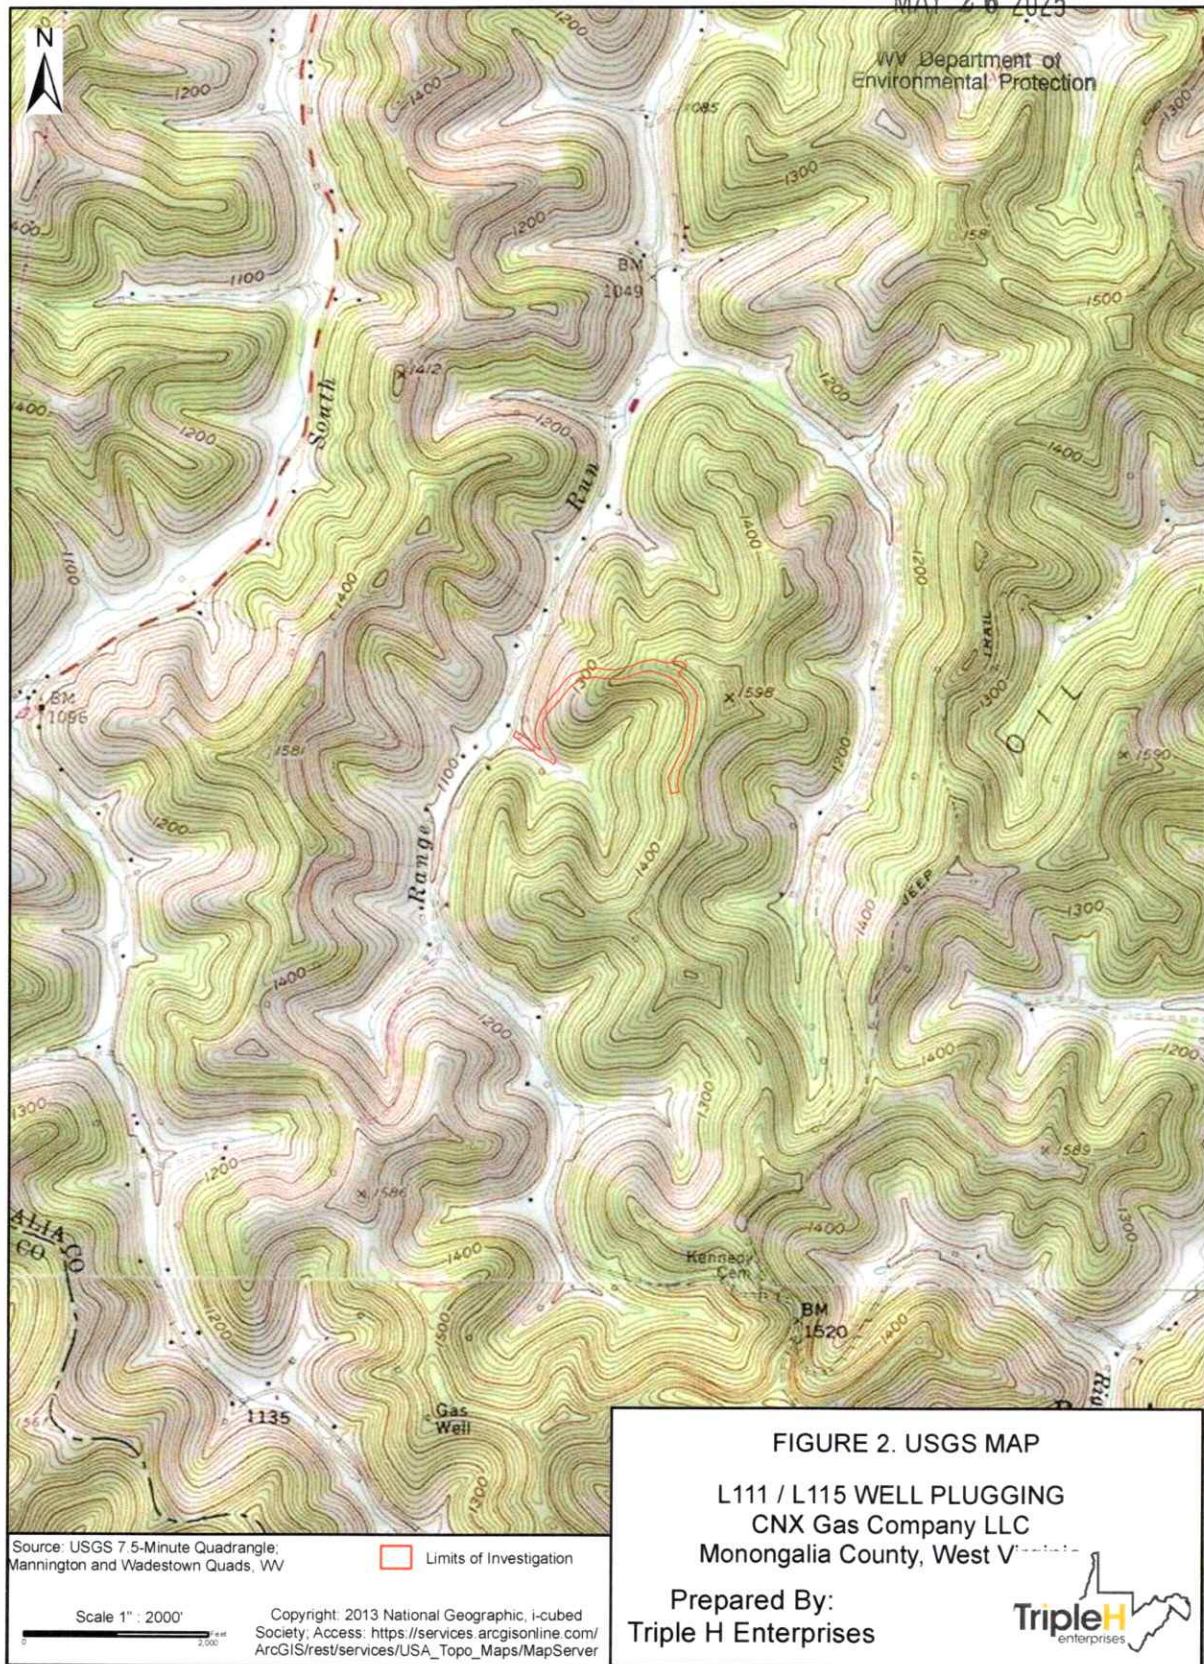

WW-7  
8-30-06

RECEIVED  
Office Of Oil and Gas

MAY 26 2025

WV Department of  
Environmental Protection



West Virginia Department of Environmental Protection  
Office of Oil and Gas

**WELL LOCATION FORM: GPS**

API: 47-061-01452 WELL NO.: L111  
FARM NAME: Phillips, Freda L.  
RESPONSIBLE PARTY NAME: CNX Gas Company LLC  
COUNTY: Monongalia DISTRICT: Battelle  
QUADRANGLE: Wadestown  
SURFACE OWNER: John Jones  
ROYALTY OWNER: \_\_\_\_\_  
UTM GPS NORTHING: 4387985  
UTM GPS EASTING: 556921 GPS ELEVATION: 1452'

The Responsible Party named above has chosen to submit GPS coordinates in lieu of preparing a new well location plat for a plugging permit or assigned API number on the above well. The Office of Oil and Gas will not accept GPS coordinates that do not meet the following requirements:

1. Datum: NAD 1983, Zone: 17 North, Coordinate Units: meters, Altitude: height above mean sea level (MSL) – meters.
2. Accuracy to Datum – 3.05 meters
3. Data Collection Method:

Survey grade GPS \_\_\_\_: Post Processed Differential \_\_\_\_

Real-Time Differential \_\_\_\_

Mapping Grade GPS X: Post Processed Differential X

Real-Time Differential \_\_\_\_

4. **Letter size copy of the topography map showing the well location.**

I the undersigned, hereby certify this data is correct to the best of my knowledge and belief and shows all the information required by law and the regulations issued and prescribed by the Office of Oil and Gas.

Erika Hunt Manager-Permitting 5/7/25  
Signature Title Date

07/11/2025