

3341.7'

(+) DENOTES LOCATION OF WELL ON U.S.G.S. TOPOGRAPHIC MAP

LATITUDE 39 37' 30"

LONGITUDE 80 20' 00"

1902.8'

N

NOAH HAINES  
90.41 AC.  
739/600  
28-5

L-57

TO SAINT LEO  
new road  
18" WO.

KENNETH A. HAINES ET.AL.  
29 AC.  
1085/102

old road  
- 36" CONC CULV.  
- WV. CO. RT. 9

NOAH HAINES  
30.4 AC.  
635/617  
28-5

NOAH HAINES  
1.75 AC.  
635/617  
28-5.1

TIE LINES

A	215 42 24	569.90'
B	200 40 27	882.94'
C	199 00 19	844.60'
D	193 29 37	1116.86'


NOTE :

- 1) CONSOLIDATION COAL COMPANY OWNS THE MINERAL ON THIS TRACT.
- 2) THIS WELL IS AN EXISTING VENTILATION BORE-HOLE BEING CONVERTED TO A CBM GOB WELL.

FILE NO. 02-HH-07  
 DRAWN BY : R.A. KITZMILLER  
 SCALE : 1 : 500'  
 MIN. DEGREE OF ACCURACY 1 / 200'  
 PROVEN SOURCE OF ELEVATION : \_\_\_\_\_  
 \_\_\_\_\_  
 SPOT ELEVATION \_\_\_\_\_

I THE UNDERSIGNED, HEREBY CERTIFY THAT THIS PLAT IS CORRECT TO THE BEST OF MY KNOWLEDGE AND BELIEF AND SHOWS ALL THE INFORMATION REQUIRED BY LAW AND THE REGULATIONS ISSUED AND PRESCRIBED BY THE DIVISION OF ENVIRONMENTAL PROTECTION.

(SIGNED) Robert A. Kitzmiller  
 Professional Surveyor No. 835

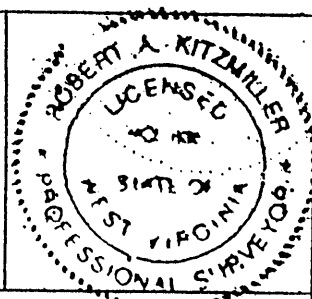

WV. DEPT. OF ENVIRONMENTAL PROTECTION  
 OFFICE OF OIL AND GAS DIVISION  
 1356 HANSFORD STREET  
 CHARLESTON, WV. 25301



DATE FEBRUARY 21, 20 02  
 OPERATOR'S WELL NO. L-57  
 API WELL NO. \_\_\_\_\_  
47 - 061 - 01463P  
 STATE COUNTY PERMIT NO.

WELL TYPE: OIL  GAS  CBM  LIQUID INJECTION  WASTE DISPOSAL

IF "GAS", PRODUCTION  STORAGE  DEEP  SHALLOW

LOCATION: ELEVATION 1356' WATERSHED RANGE RUN OF WEST VIRGINIA FORK OF DUNKARD CREEK  
 DISTRICT BATTELLE COUNTY MONONGALIA  
 QUADRANGLE MANNINGTON NEAREST TOWN WADESTOWN

SURFACE OWNER NOAH & LORRAINE HAINES ACREAGE 90.41 AC.

OIL & GAS ROYALTY OWNER \* See Note LEASE ACREAGE \_\_\_\_\_

LEASE NO. \_\_\_\_\_

PROPOSED WORK: DRILL  CONVERT  DRILL DEEPER  REDRILL  FRACTURE OR STIMULATE   
 PLUG OFF OLD FORMATION  PERFORATE NEW FORMATION   
 OTHER PHYSICAL CHANGE IN WELL (SPECIFY) EXISTING VENTILATION BOREHOLE BEING CONVERTED  
 PLUG AND ABANDON CLEAN OUT AND REPLUG  TO GOB WELL. JAN 24 2002

TARGET FORMATION PITTSBURGH ESTIMATED DEPTH 1094'  
 WELL OPERATOR CNX GAS COMPANY LLC. (NORTH) DESIGNATED AGENT EDWIN L. MERRIFIELD  
 ADDRESS 1800 WASHINGTON ROAD ADDRESS 116 1/2 HUNSAKER STREET  
PITTSBURGH, PA. 15421-1421 FAIRMONT, WV. 26554

PRECISION SURVEYS FORM IV-6

MONO COUNTY PERMIT NO. 1463 P

(LOVERIDGE MINE CBM 389) 6-6

State of West Virginia  
 Department of Environmental Protection  
 Office of Oil and Gas

Well Operator's Report of Well Work

Farm Name: Haines, Noah & Lorraine Operator Well No.: L-57

LOCATION: Elevation: 1356 Quadrangle: Mannington

District: Battelle County: Monongalia  
 Latitude: 1902.6 Feet South of 39 Deg. 37 Min. 30 Sec.  
 Longitude: 3341.7 Feet West of 80 Deg. 20 Min. 00 Sec.

Company: CNX Gas Company LLC (North)

	Casing & Tubing	Used In Drilling	Left In Well	Cement Fill Up Cu. Ft.
Address: 1800 Washington Road Pittsburgh, PA 15241				
Agent: Edwin Merrifield				
Inspector: Steve Mossor				
Date Permit Issued: 1/21/2003				
Date Well Work Commenced: Existing Borehole				
Date Well Work Completed: Converted to well				
Verbal Plugging:				
Date Permission granted on:				
Rotary Cable Rig				
Total Depth (feet): 1094				
Fresh Water Depth (ft.):				
Salt Water Depth (ft.):				
Is coal being mined in area (N/Y)? No				
Coal Depths (ft.): 1084				

OPEN FLOW DATA


Producing formation Pittsburgh Coal Seam Pay zone depth (ft) 1084  
 Gas: Initial open flow 110 MCF/d Oil: Initial open flow 0 Bbl/d  
 Final open flow 110 MCF/d Final open flow 0 Bbl/d  
 Time of open flow between initial and final tests 0 Hours  
 Static rock pressure 1 psig (surface pressure) after - Hours

Second producing formation None Pay zone depth (ft) \_\_\_\_\_  
 Gas: Initial open flow \_\_\_\_\_ MCF/d Oil: Initial open flow \_\_\_\_\_ Bbl/d  
 Final open flow \_\_\_\_\_ MCF/d Final open flow \_\_\_\_\_ Bbl/d  
 Time of open flow between initial and final tests \_\_\_\_\_ Hours  
 Static rock pressure \_\_\_\_\_ psig (surface pressure) after \_\_\_\_\_ Hours

NOTE: ON BACK OF THIS FORM PUT THE FOLLOWING: 1). DETAILS OF PERFORATED INTERVALS, FRACTURING OR STIMULATING, PHYSICAL CHANGE, ETC. 2). THE WELL LOG WHICH IS A SYSTEMATIC DETAILED GEOLOGICAL RECORD OF ALL FORMATIONS INCLUDING COAL ENCOUNTERED BY THE WELLBORE.

Signed: Joseph P. Aman  
 By: Joseph P. Aman  
 Date: September 2, 2004

OCT 15 2004

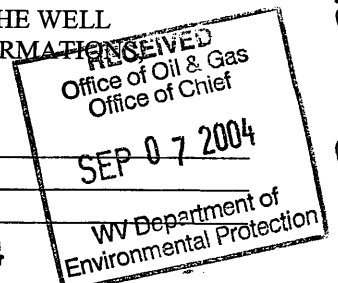

MONO 1463