

WR-38
Rev. 5/08

API # 47-061-01500

STATE OF WEST VIRGINIA
DEPARTMENT OF ENVIRONMENTAL PROTECTION
OFFICE OF OIL AND GAS

AFFIDAVIT OF PLUGGING AND FILLING WELL

AFFIDAVIT SHOULD BE IN TRIPPLICATE, one copy mailed to the Department, one copy to be retained by the Well Operator and the third copy (and extra copies if required) should be mailed to each coal operator at their respective addresses.

Farm name: S. Jusdon Hall Operator Well No.: L1A

LOCATION: Elevation: 1101.48' Quadrangle: Wadestown WV, PA 7.5
District: Battelle County: Monongalia
Latitude: _____ Feet South of 39 Deg. 38 Min. 20.73 Sec.
Longitude: _____ Feet West of 80 Deg. 22 Min. 27.10 Sec.

Well Type: OIL _____ GAS X

Company Consolidation Coal Co Coal Operator 1 Bridge St
or Owner Monongah, WV 26554

Agent David Roddy Coal Operator _____
or Owner _____
Permit Issued Date 11/09/18

AFFIDAVIT

STATE OF WEST VIRGINIA,
County of Monongalia ss:

Dustin W. Bennett and Matthew A. Yearsley being first duly sworn according to law depose and say that they are experienced in the work of plugging and filling oil and gas wells and were employed by the above named well operator, and participated in the work of plugging and filling the above well say that said work was commenced on the 17th day of December, 2018, and the well was plugged and filled in the following manner:

TYPE	FROM	TO	PIPE REMOVED	LEFT
Class A Cement	949'	838'		
Expandable Cement	838'	627'		
Expandable Cement	627'	Surface		
2 7/8" Drill Pipe	Unknown	1052'	503'	Unknown
5 1/2" Casing	627'	Surface	0'	627'

Description of monument: 77" of 7" casing with company name, well #, API #, and date cemented. and that the work of plugging and filling said well was completed on the 2nd day of January, 2019.

And further deponents saith not. [Signature]
Matthew A. Yearsley



Sworn and subscribe before me this 21st day of Jan, 2019

My commission expires: 9-15-22 Carol A Mayle
Notary Public

JAN 29 2019

Affidavit reviewed by the Office of Oil and Gas: Gayne Knitowski Title: Inspector 1/25/2019
WV Department of Environmental Protection

COPY

Plugging Report for MSHA

Well Number: L1A Mine: Marion County Mine

Permit Number: 47-061-01500

Date Clean Out Started: 12/17/2018

Date Well Bore Plugged: 1/2/2019


Pittsburgh Coal Seam: 935 ft. To 941 ft.

Plugs:

From	To	Type of Cement
<u>949'</u>	<u>838'</u>	<u>Class A Cement</u>
<u>838'</u>	<u>627'</u>	<u>Expandable Cement</u>
<u>627'</u>	<u>Surface</u>	<u>Expandable Cement</u>

Casing Remaining in Well Bore

	Top	Bottom	Left	Pulled
Sucker Rods				
2 7/8" Drill Pipe	1052'	Unknown	Unknown	503'
5 1/2" casing	Surface	627'	627'	0'
7" casing				
8 5/8" casing				
13 3/8" casing				
16" casing				
7" Fiberglass				

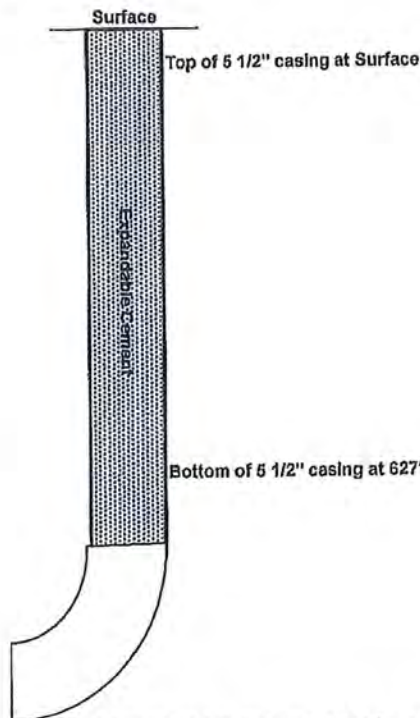

Uncased hole from 627' to L1 production intersection. Left 2 7/8" Drill Pipe from 1052' to 1513'.

Cement:

Expandable 105 sacks
 Class A 15 sacks
 Econofill _____ sacks
 Mud Flush _____ gal
 Other _____
 Est. Top Thix _____ ft
 Did Cement Circ. Yes

Comments:

Caving: Extreme Moderate Normal
 Lost Circulation: Extreme Moderate Normal
 Difficulty in Removing Casing: Extreme Moderate Normal ; Not Apply
 Debris in Well Bore: Wood Steel Other: _____

Surface Elevation (Surveyed) 1101.41
 Bottom of Coal Structure (Map) 166.41
 Difference 935

RECEIVED
 Office of Oil and Gas

JAN 29 2019

WV Department of
 Environmental Protection



Supplemental
02/22/2019

FORM WR-38
(Affidavit of Plugging)

WEST VIRGINIA
DEPARTMENT OF ENVIRONMENTAL PROTECTION
OIL AND GAS WELLS DIVISION

AFFIDAVIT OF PLUGGING AND FILLING WELL

AFFIDAVIT SHOULD BE MADE IN TRIPLICATE, one copy mailed to the Division, one copy to be retained by the Well Operator and the third copy (and extra copies if required) should be mailed to each coal operator at their respective addresses.

CONSOLIDATION COAL CO.
Coal Operator or Owner
1 BRIDGE STREET MONONGAH, WV 26554
Address
CONSOLIDATION COAL CO.
Coal Operator or Owner
1 BRIDGE STREET MONONGAH, WV 26554
Address
CONSOL MINING COMPANY LLC.
Lease or Property Owner
1000 Consol Energy Drive Canonsburg, PA 15317
Address

CONSOLIDATION COAL CO.
Name of Well Operator
1 BRIDGE STREET MONONGAH, WV 26554
Complete Address
WADESTOWN WV, PA 7.6
Well Location
BATTELLE
District
MONONGALIA
County
L1A
Well No.
S. JUDSON HALL
Farm

STATE INSPECTOR SUPERVISING PLUGGING Jayne Kuitowski 1/25/2019

AFFIDAVIT

STATE OF WEST VIRGINIA,
County of MONONGALIA ss:
DUSTIN W. BENNET and MATTHEW A. YEARSLEY being first duly sworn according to law depose and say that they are experienced in the work of plugging and filling oil and gas wells and were employed by Consolidation Coal Company well operator, and participated in the work of plugging and filling the above well, that said work was commenced on the 17th day of December, 2018 and that the well was plugged in the following manner:

Sand or Zone Record Formation	Filling Material	Casing/Tubing Size	Casing Pulled	Casing Left In
Removed 503' of 2 7/8" drill pipe from 549' to 1052' Cleaned a 4 3/4" hole from surface to 949'. Tagged solid plug at 949'. Left 627' of 5 1/2" casing in hole from surface to 627'. Attempted to remove 5 1/2" casing by pulling 150% of string weight. All attempts were unsuccessful. Set bottom hole plug from 949' to 838' with 15 sacks of Class A cement.		2 7/8" Drill Pipe 5 1/2" Casing	503' 0'	Unknown 627'
Cemented hole from 838' back to the surface as follows: From 838' to 627' with 53 sacks of Expandable cement. From 627' to surface with 52 sacks of Expandable cement. Cement did circulate at the surface.				
Coal Seams	Description of Monument			
<u>Pittsburgh</u>	<u>(935' - 941')</u> 77" of 7" casing w/ company name, well number, permit number and date cemented stated on 7" casing. Well marker will be attached to cement plug at ground level.			

... and that the work of plugging and filling said well was completed on the 2nd day of January, 2019

And further deponents saith not.

Dustin W. Bennett
Dustin W. Bennett
Matthew A. Yearsley
Matthew A. Yearsley


Sworn to and subscribed before me this 21st day of Jan 2019

RECEIVED
Office of Oil and Gas

Carol A. Mayh
Notary Public

JAN 29 2019

My commission expires

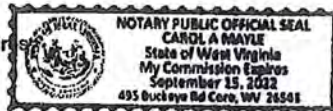

Permit No. 47-061-01500
Well No. L1A
Latitude: 39° 38' 20.73"N
Longitude: 80° 22' 27.10"W

WV Department of
Environmental Protection

COPY