

LATITUDE 39° 40' 00"

05 21 88

LONGITUDE

75
+

7'5 OGIS topo location

7.5' loc $\frac{2.515}{1.45W}$

15' loc $\frac{2.515}{3.67W}$
(calc.)

Company _____

Farm _____

Quad Blacksville

County Monongahela


District Clay

WELL LOCATION MAP

File No. 061-69A

now 061-1609

Map showing the location of Well No. 1 of the
 Hunt Oil Co. of Newark Ohio, to be abandoned in the
 Cobby-Brown Farm, containing the Dorcas Springs
 located in City District, Mineralia County,
 West Virginia.

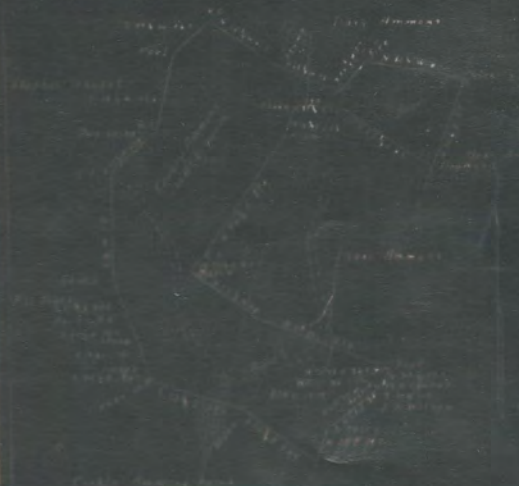

EXHIBIT

I, the undersigned hereby certify that this map is correct
 and shows all the information in the best of my knowledge
 and belief, known and by the Oil and Gas Survey of the State
 of West Virginia.

W. H. [Signature]

Approved before me a Notary Public
 in and for Mineralia County, West Virginia,
 this 20th day of June, 1910.

My Commission Expires
 August 25th, 1911.

W. H. [Signature]
 Notary Public

WELL RECORD

 Form No. 100-22

 60 of the Well 100

Company The Pure Oil Company
 Address Box 100 - Newark, N.J.
 Name Barley Avenue Area 100
 Location Barley Avenue
 Well No. 1 Date 1927
 Depth 100 County Essex
 The well is owned by Barley Avenue No. 1
Barley Avenue No. 1
 Should be owned by Barley Avenue No. 1
Barley Avenue No. 1
 Drilling commenced January 17, 1927
 Drilling completed January 17, 1927
 Date shut 1/17/27 Depth of shut 100
 Open flow 100 Water to 100
100 Water to 100
 Flow 100 Oil to 100
 Oil to 100
 Gas to 100
 Gas to 100
 Gas to 100
 Gas to 100

Depth	Oil	Water	Gas	Pressure
0				
10				End of Well
20				
30				
40				
50				
60				
70				
80				
90				
100				

Depth	Oil	Water	Gas	Pressure	Temp	Remarks
0						
10						
20						
30						
40						
50						
60						
70						
80						
90						
100						

The Pure Oil Company
 Box 581
 Newark, Ohio Address

COMPLETION DATA SHEET
 NO. 2
 FORMATION RECORD

Well No. 1 Corbly #2000

Assignment File #28

Name	Color	Character	Oil, Gas or Water	Top	Bottom	Thickness	Total Depth	Remarks
Bluff Sand				646	721			
Fairview Coal				721	725			
Maplewood Coal				986	991			
Pittsburgh Coal				1078	1088			
Little Dunkard				1418	1428			
Big Dunkard				1574	1588			
Salt Sand				1866	1866			
Hamon Sand				2226	2261			
Little Lane				2296	2310			
Pencil Cove				2314	2321			
Big Lane				2321	2376			
Big Injun				2376	2516			
Firth				2468	2508			
Total Depth				2516				

Well was shut-in at _____ feet; well was shut at _____ feet

Fresh water at _____ feet; Fresh water at _____ feet

Well was _____
 producing _____
 gas-oil _____

July 21, 1928
 Date

THE PURE OIL COMPANY
 Approved by *W. L. Miller*
 Director, Supervisor

NOTE: All bottom descriptions must be noted as indicated above and all log-calls and all well logs made must be recorded under their proper geological names in the district as well as any local names commonly used in the district for such names.

The Hum Oil Co. _____ Company
Box 581,
Newark, Ohio _____ Address

COMPLETION DATA SHEET
NO. 2
FORMATION RECORD

Well No. 1 Corley Adams

Abandonment File 528

Name	Color	Character	Oil, Gas or Water	Top	Bottom	Thickness	Total Depth	Remarks
Stuff Sand				646	721			
Fairview Coal				721	753			
Hopkinton Coal				985	991			
Pittsburgh Coal				1079	1385			
Little Sandstone				1418	1428			

Well was not shut at _____ feet; well was shut at _____ feet

Well was shut at _____ feet; fresh water at _____ feet

Well was _____
_____ day

July 21, 1928
Date

THE HUM OIL CO.
Approved: *[Signature]*
Division Superintendent

NOTE: All bottom formations must be noted as indicated above and all bar-codes and oil and gas sample must be recorded under their proper geological names in the column as well as any local names commonly used in the district for each stratum.

WEST VIRGINIA DEPARTMENT OF MINES

OIL AND GAS DIVISION

PRELIMINARY DATA SHEET NO. 1

Amendment

File No. 25Well No. 1

The Pure Oil Company, of Box 551, Newark, Ohio
on the Carley Ammon Farm

containing 157 acres. Location
Clay District, in Monongalia County, West Virginia

The surface of the above tract is owned in fee by Carley Ammon Heise
of Harrison, W. Va. address, and the mineral rights are owned by
Delta Coal & Coke Co. of Baltimore, Md.

The oil and gas privileges are held under lease by the above named company, and this well is drilled under permit
No. _____ issued by the West Virginia Department of Mines, Oil and Gas Division

Drilled Jan. 17, 1928 100

Elevation of surface at top of well, _____ Static
Barometric.

The number of feet of the different sized casings used in the well.

_____ feet	_____ also.	Wood conductor.
<u>2280</u> feet <u>8 5/8"</u> also, cap. <u>2280</u> feet <u>8 5/16"</u> steel cap.		
<u>1280</u> feet <u>10"</u> also, cap. _____ feet _____ steel cap.		
_____ feet _____ also, cap. _____ feet _____ steel cap.		
_____ packer of _____ also, set at _____		
_____ packer of _____ also, set at _____		
_____ in casing perforated at _____ feet to _____ feet.		
_____ in casing perforated at _____ feet to _____ feet.		
Coal was encountered at <u>721</u> feet; thickness <u>48</u> inches, and at <u>808</u>		
feet; thickness <u>20</u> inches; and at <u>1070</u> feet; thickness <u>24</u> inches.		

Lithom was used as follows: (Give details)

July 21, 1928 Date

Approved _____ THE PURE OIL COMPANY, Owner

By Frank Miller
Division Superintendent

FILE NO. 25

**AFFIDAVIT IN TRIPLICATE TO TIME AND MANNER OF
PLUGGING AND FILLING WELL.**

(Enacted by Chapter 8, Article 4, Chapter 82 of the Code)

WEST VIRGINIA DEPARTMENT OF MINES

OIL AND GAS DIVISION

FILE NO. 25

<u>Boris Seal & Sons Co.</u> <small>SOLE OPERATOR OR OWNER</small>	<u>The Penn Oil Company</u> <small>SOLE OPERATOR OR OWNER</small>
<u>Baltimore, Md.</u> <small>ADDRESS</small>	<u>Mount, Ohio</u> <small>ADDRESS</small>
 <small>SOLE OPERATOR OR OWNER</small>	<u>January 18, 1928</u> <small>DATE</small>
 <small>ADDRESS</small>	<u>WELL AND LOCATION</u>
<u>Curtley Ammons Mine</u> <small>SOLE OPERATOR OR OWNER</small>	<u>Clay</u> <small>DISTRICT</small>
<u>Marion, W. Va.</u> <small>ADDRESS</small>	<u>Wetzel</u> <small>COUNTY</small>
	<u>Well No. 2</u> <small>WELL NO.</small>
	<u>Clayton Ammons</u> <small>PERSON</small>

AGREEMENT TO BE MADE BY OPERATOR AND OWNER TO BE MADE BY OPERATOR AND TO THE DEPARTMENT, AND AGENT TO BE APPOINTED BY THE DEPT. OF MINES AND TO THE STATE AND LOCAL OFFICES OF MINES, TO BE SO MADE TO THE DEPT. OF MINES AND TO THE STATE AND LOCAL OFFICES OF MINES.

AFFIDAVIT

STATE OF WEST VIRGINIA,

County of Wetzel

Joseph S. York and Wm. A. Trumbull
being first duly sworn according to law depone and say that they are experienced in the work of plugging and filling oil and gas wells and were employed by The Penn Oil Company, well owner, and participated in the work of plugging and filling the above well, that said work was commenced on the 18th day of November, 1928, and that the well was plugged and filled in the following manner:

Manner in which said well plugged

Filled hole from bottom 2250' to 2200' with non-porous material, set lead wood plug 2200' - 2250'; Filled 2 3/4" casing, filled with non-porous material 2200' - 2250'; set wood plug 2200' - 2250'; Cemented 2200' to 2250' - casing big hole sand; Filled with non-porous material to 2200' - 2250' above Stone Sand; set wood plug 2200' - 2250'; Cemented 2200' - 2250' - casing Stone Sand; Filled with non-porous material to 2200' - 2250' above Gate Sand; set wood plug 2200' - 2250'; Cemented 2200' - 2250' - casing Gate Sand; Filled with non-porous material to 2200'; Filled 2 3/4" casing from 2200' - casing top of casing well cement; Filled with non-porous material to 2200' - 2250' above Little Indian Sand; Cemented 2200' to 2250' - casing Little and Big Indian Sand; Filled with non-porous material to 2200', 2" pipe Pittsburgh Coal; Cemented 2200' - 2250' - 2" above Pittsburgh Coal; Filled with sand to 2200' - 2250' below Huntington Coal; Cemented 2200' - 2250' - casing Huntington Coal; Filled with sand to 2200', 2" below Fairview Coal; Cemented 2200' to 2250' - 2" above Fairview Coal; Filled with non-porous material to surface.

Description of cement:

Injected cement made of concrete 10'45'20'

All work done in volumetric manner

AND HAVE SUBSCRIBED SWORN AS TO CORRECT AND ACCURATE STATE THE PROCEEDINGS OF DEPT. OF MINES AND TO THE STATE AND LOCAL OFFICES OF MINES.

and that the work of plugging and filling said well was completed on the 19th day of January, 1928.

And further deponents with out

Joseph S. York
Wm. A. Trumbull
L. J. Kelly

Sworn to and subscribed before me this 19 day of January, 1928

My Commission expires:

Oct. 1, 1928

*11/24/28
Henry 2000035*