


SCALE BAR: 1"=60'



LEGEND

- PROPERTY LINES
- PROJECT AREA
- EXISTING DISTURBED AREA
- EENS CONTROLS
- EDGE OF UPGRADED ROAD
- TOPSOIL-TIMBER STOCKPILE
- ORANGE SAFETY FENCE

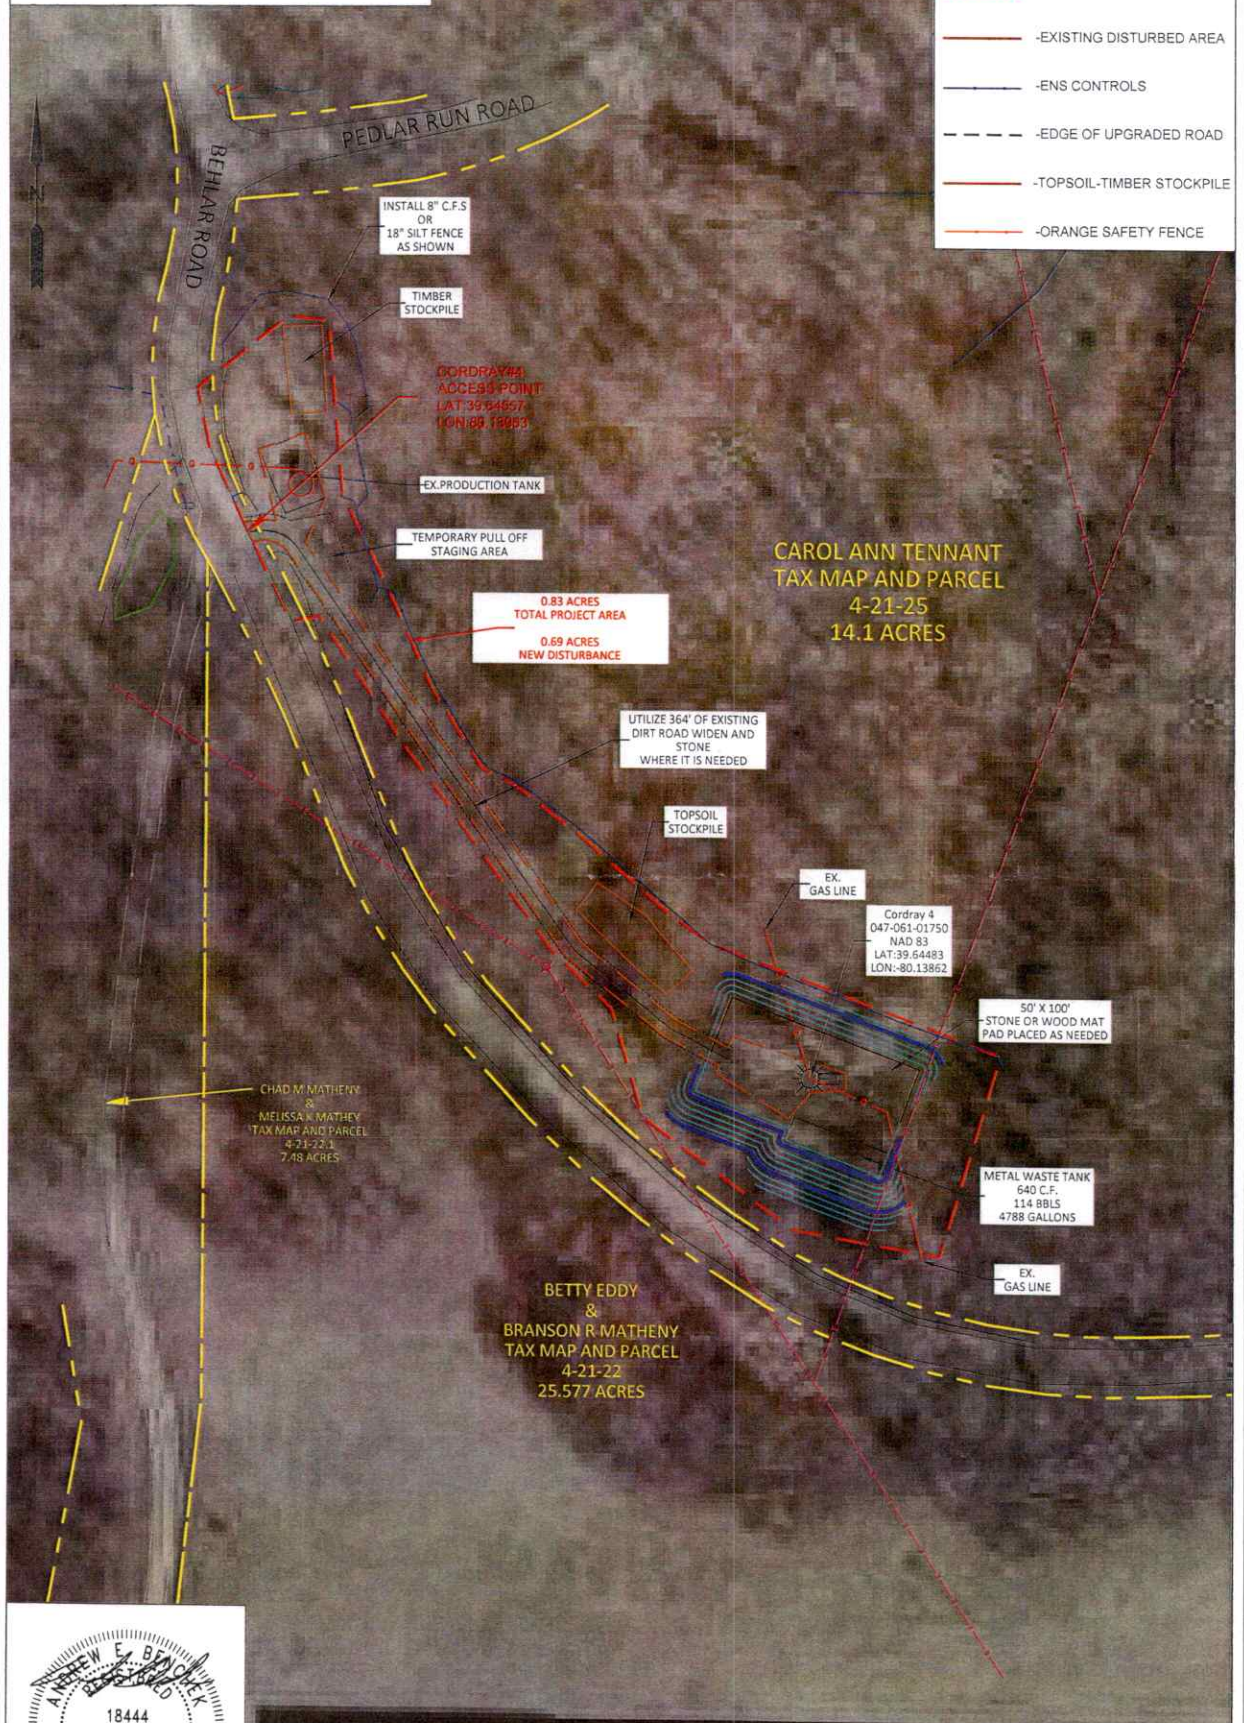

DATE:
JULY 2025

CORDRAY NO.4
SHALLOW WELL
47-061-01750

CLAY DISTRICT,
MONONGALIA
COUNTY, WV


WW-8 REC PLAN
CORDRAY NO.4

THIS DOCUMENT WAS PREPARED BY:
BOORD, BENCHEK AND ASSOC., INC.
FOR: NORTHEAST NATURAL ENERGY LLC

BOORD, BENCHEK and ASSOC., INC.
Engineering, Surveying, Construction,
and Mining Services

Southpointe, Project No. 2025-000000000000

08/15/2025

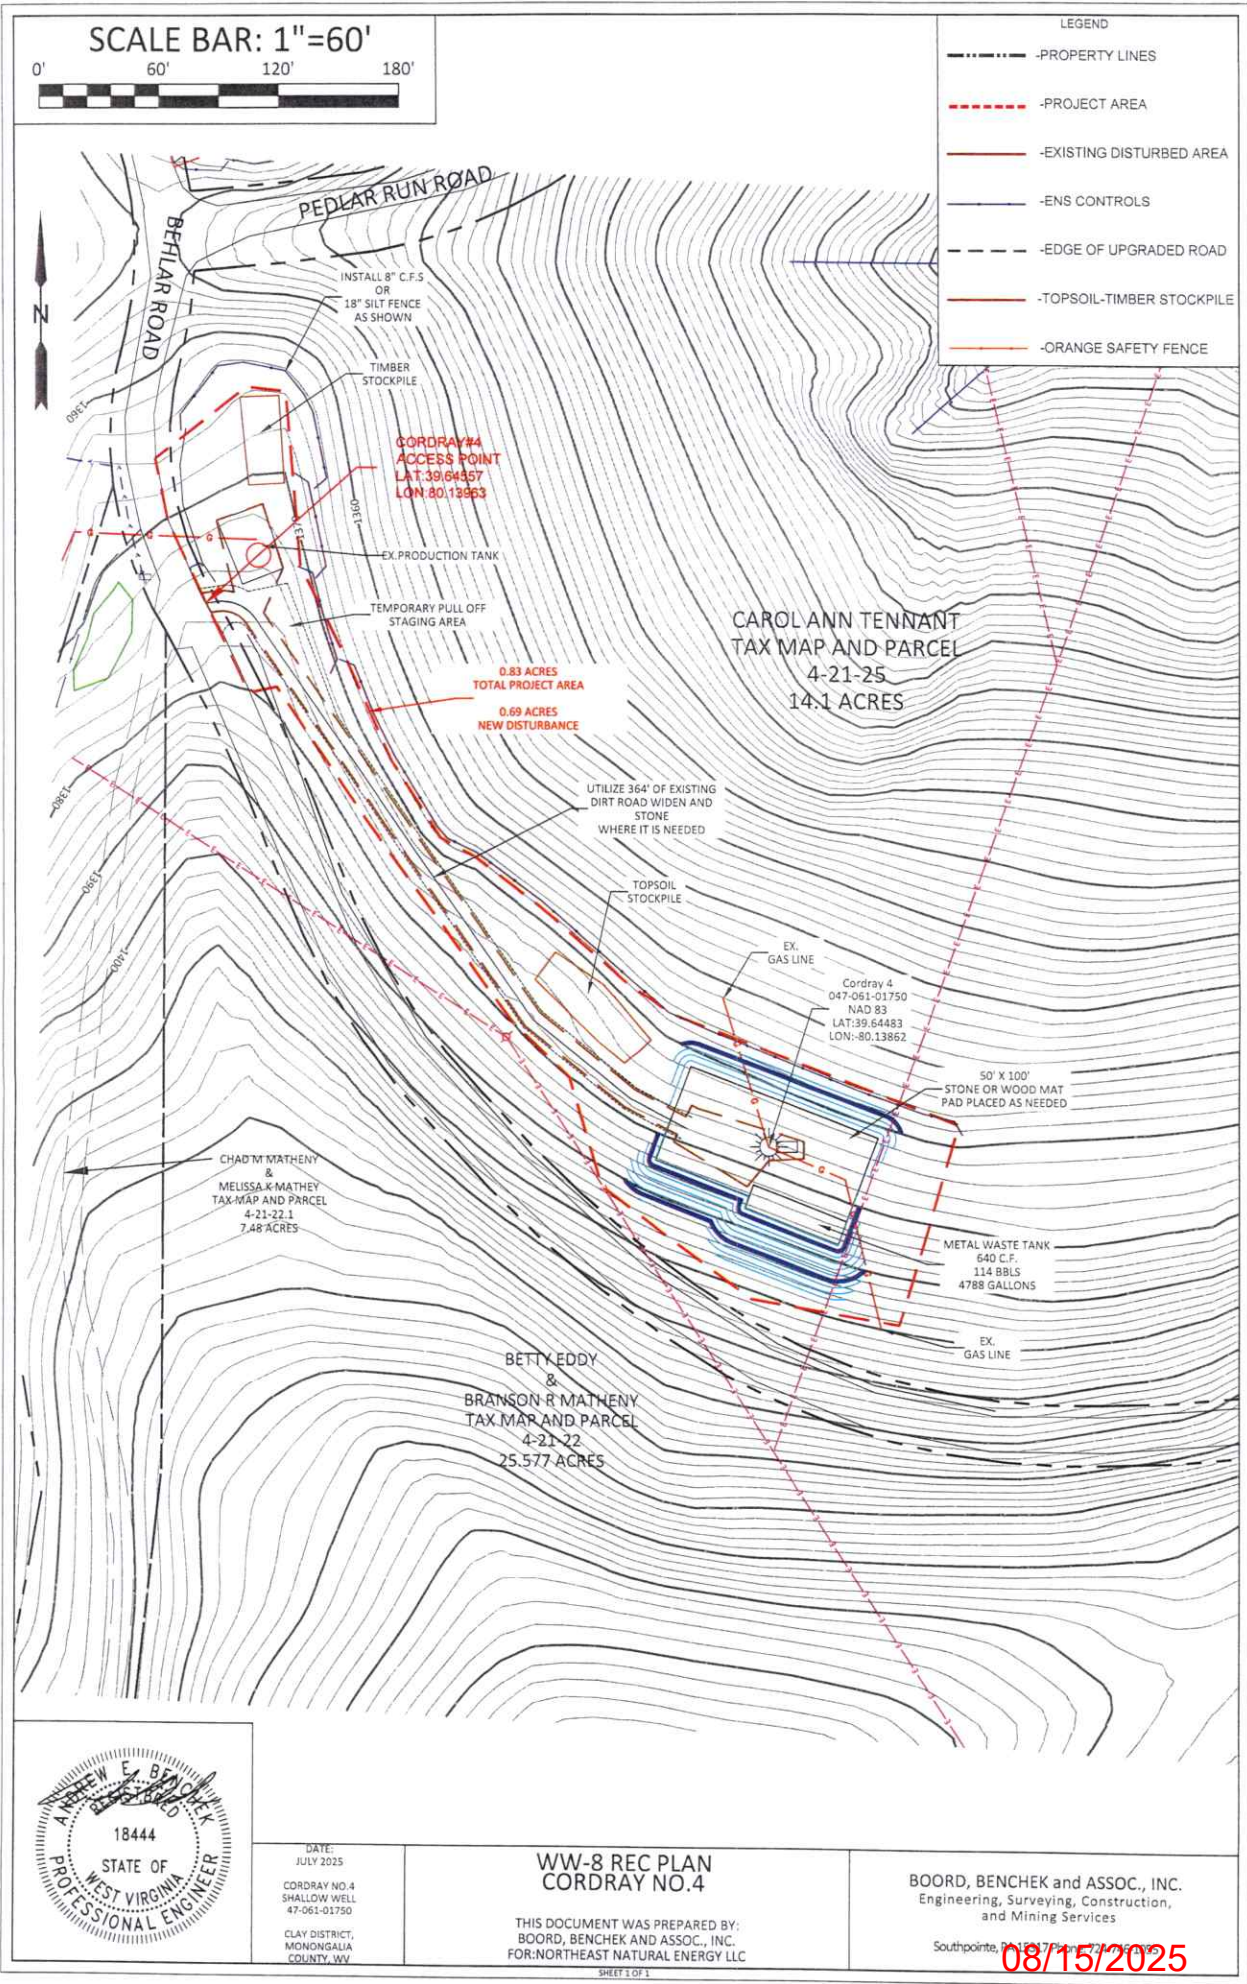


DATE:
JULY 2025
CORDRAY NO.4
SHALLOW WELL
47-061-01750
CLAY DISTRICT,
MONONGALIA
COUNTY, WV

**WW-8 REC PLAN
CORDRAY NO.4**

THIS DOCUMENT WAS PREPARED BY:
BOORD, BENCHEK AND ASSOC., INC.
FOR: NORTHEAST NATURAL ENERGY LLC

BOORD, BENCHEK and ASSOC., INC.
Engineering, Surveying, Construction,
and Mining Services

Southpointe, PA 15127
08/15/2025

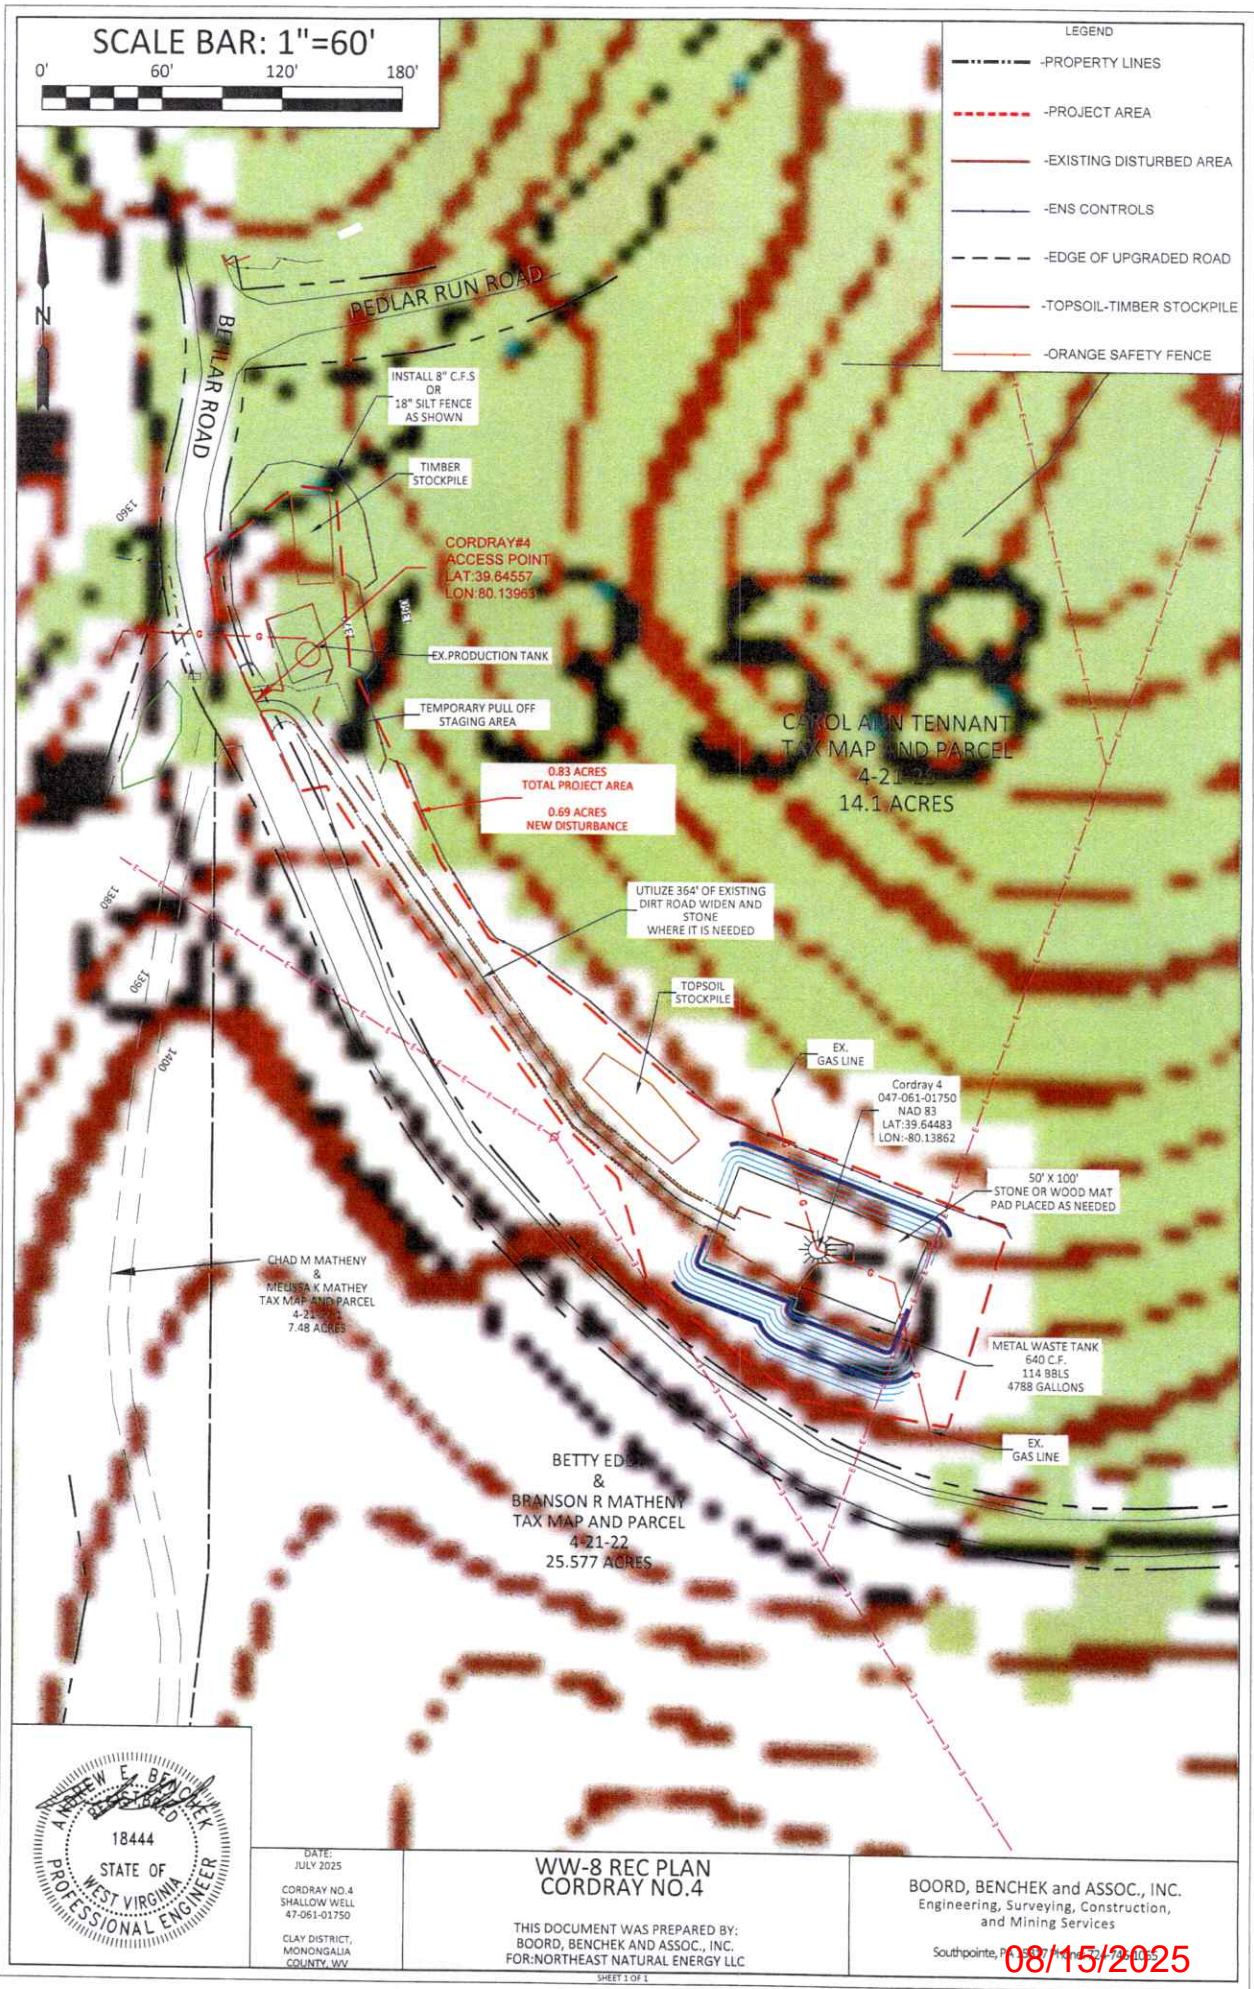

WW-7
8-30-06

RECEIVED
Office of Oil and Gas

JUL 22 2025

WV Department of
Environmental Protection



West Virginia Department of Environmental Protection
Office of Oil and Gas

WELL LOCATION FORM: GPS

API: 47-061-01750 WELL NO.: Cordray 4

FARM NAME: Cordray

RESPONSIBLE PARTY NAME: NNE Resources LLC

COUNTY: Monongalia DISTRICT: Clay

QUADRANGLE: Blacksville

SURFACE OWNER: Carol A. Tennant

ROYALTY OWNER: Jack Cordray, et al

UTM GPS NORTHING: 4388692.726

UTM GPS EASTING: 573891.26 GPS ELEVATION: 1380'

The Responsible Party named above has chosen to submit GPS coordinates in lieu of preparing a new well location plat for a plugging permit or assigned API number on the above well. The Office of Oil and Gas will not accept GPS coordinates that do not meet the following requirements:

1. Datum: NAD 1983, Zone: 17 North, Coordinate Units: meters, Altitude: height above mean sea level (MSL) – meters.
2. Accuracy to Datum – 3.05 meters
3. Data Collection Method:

Survey grade GPS ☒ : Post Processed Differential _____

Real-Time Differential ☒ _____

Mapping Grade GPS _____ : Post Processed Differential _____

Real-Time Differential _____

4. Letter size copy of the topography map showing the well location.

I the undersigned, hereby certify this data is correct to the best of my knowledge and belief and shows all the information required by law and the regulations issued and prescribed by the Office of Oil and Gas.

Holl Me
Signature

Regulatory Manager
Title

7-8-25
Date

08/15/2025