

NOTE: It is the purpose and intention of this plat to represent the true and correct location of the surface or mineral parcels depicted thereon. The location of the boundary lines, as shown, are based on recorded descriptions. Field evidence found a prior map position, unless otherwise noted.

Well is located on topo map 2,153 feet south of Latitude: 39° 40' 00"

Well is located on topo map 7,277 feet west of Longitude: 80° 05' 00"

WELL LOCATION
UTM 17-NAD83
N:4390493.76
E:576433.19
NAD83 WV NORTH
N:423391.538
E:1797058.182
LAT:39°39'39.01"
LON:80°06'32.31"

OIL & GAS WELLS WITHIN 1200 FT.

REFERENCE NOT TO SCALE

MARK A. AND MICHAEL E. STOCKMAN
ROSE MARY NAGY
MARY LOUISE & BERNARD L. DUELLEY ET AL

WELL D. MYERS #3

WV DIVISION OF NATURAL RESOURCES
PUBLIC LAND CORPORATION

WV DIVISION OF NATURAL RESOURCES
PUBLIC LAND CORPORATION

TM/PA 4-15/21
DB/PG 1277/260
117 AC±

MARGARET R. PINGS

WV DIVISION OF NATURAL RESOURCES
PUBLIC LAND CORPORATION

MARVIN G. COPLAND

Blue Mountain Inc.
11023 MASON DIXON HIGHWAY
BURTON, WV 26562
PHONE: (304) 682-6486

FILE #: D. MYERS #3
DRAWING #: D. MYERS #3
SCALE: 1" = 500'
MINIMUM DEGREE OF ACCURACY: 1/2500
PROVEN SOURCE OF ELEVATION: U.S.G.S. MONUMENT THOMAS 1498.81'

(THE UNDERSIGNED, HEREBY CERTIFY THAT THIS PLAT IS CORRECT TO THE BEST OF MY KNOWLEDGE AND BELIEF AND SHOWS ALL THE INFORMATION REQUIRED BY LAW AND THE REGULATIONS ISSUED AND PRESCRIBED BY THE DEPARTMENT OF ENVIRONMENTAL PROTECTION.

Signed: **PRELIMINARY**
R.P.E.: _____ L.L.S. P.S. No. 2000

GEORGE A. SELLER
LICENSED
No. 2000
STATE OF WEST VIRGINIA
PROFESSIONAL SURVEYOR

RECEIVED
Office of Oil and Gas
JUL 17 2025
Department of Environmental Protection

PLACE SEAL HERE

DATE: JUNE 7, 2016
OPERATOR'S WELL #: D. MYERS #3
API WELL # 47 61 71857
STATE COUNTY PERMIT

WELL Type: ☐ Oil ☐ Waste Disposal ☐ Production ☐ Deep
☒ Gas ☐ Liquid Injection ☒ Storage ☒ Shallow

WATERSHED: DUNKARD CREEK ELEVATION: 1291.02'

COUNTY/DISTRICT: MONONGALIA/CLAY QUADRANGLE: OSAGE, WV-PA 7.5'

SURFACE OWNER: WV DIVISION OF NATURAL RESOURCES PUBLIC LAND CORPORATION ACREAGE: 117±


OIL & GAS ROYALTY OWNER: _____ ACREAGE: _____

DRILL ☐ CONVERT ☐ DRILL DEEPER ☐ REDRILL ☐ FRACTURE OR STIMULATE ☐
PLUG OFF OLD FORMATION ☐ PERFORATE NEW FORMATION ☐ PLUG & ABANDON ☒
CLEAN OUT & REPLUG ☐ OTHER CHANGE ☐ (SPECIFY): _____

TARGET FORMATION: _____ ESTIMATED DEPTH: _____

WELL OPERATOR: NOUMENON CORPORATION DESIGNATED AGENT: _____
Address: 11023 MASON DIXON HIGHWAY Address: _____
City: BURTON State: WV Zip Code: 26562 City: _____ State: _____ Zip Code: _____

08/29/2025

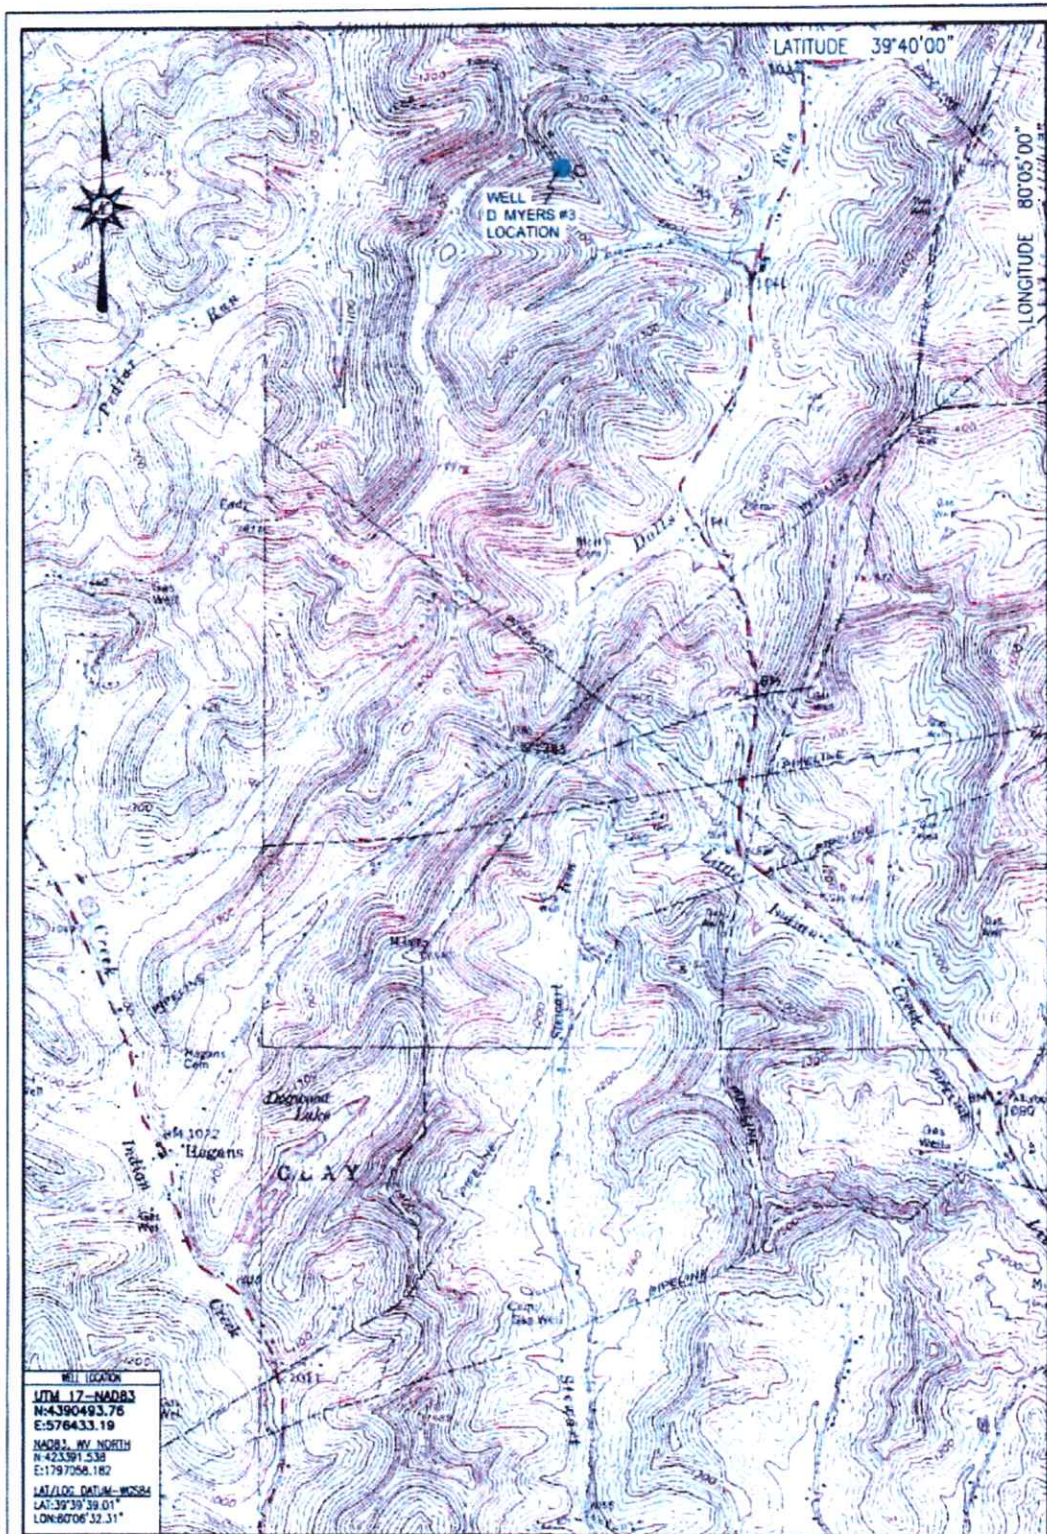

LOCATION MAP
JUNE 7, 2016

Received
Office of Oil & Gas

Blue Mountain Inc.
11023 MASON DIXON HIGHWAY
BURTON, WV 26582
PHONE: (304) 662-6486

D. MYERS #3
OSAGE QUADRANGLE
WEST VIRGINIA

SCALE 1" = 2000'
0' 2000' 4000' 6000'

BLUE MOUNTAIN ENGINEERING

08/29/2025

WW-7
8-30-06



West Virginia Department of Environmental Protection
Office of Oil and Gas
WELL LOCATION FORM: GPS

API: 47-061-01772 WELL NO.: 3

FARM NAME: D. MYERS

RESPONSIBLE PARTY NAME: NOUMENON CORPORATION

COUNTY: MONONGALIA DISTRICT: CLAY

QUADRANGLE: OSAGE, WV-PA 7.5'

SURFACE OWNER: WV BUREAU OF COMMERCE C/O DIV. OF NATURAL RESOURCES

ROYALTY OWNER: _____

UTM GPS NORTHING: 4390493.76

UTM GPS EASTING: 576433.19 GPS ELEVATION: 1291.02

The Responsible Party named above has chosen to submit GPS coordinates in lieu of preparing a new well location plat for a plugging permit or assigned API number on the above well. The Office of Oil and Gas will not accept GPS coordinates that do not meet the following requirements:

1. Datum: NAD 1983, Zone: 17 North, Coordinate Units: meters, Altitude: height above mean sea level (MSL) – meters.
2. Accuracy to Datum – 3.05 meters
3. Data Collection Method:

Survey grade GPS ____: Post Processed Differential ____

Real-Time Differential ____

Mapping Grade GPS X: Post Processed Differential ____

Real-Time Differential ____

4. **Letter size copy of the topography map showing the well location.**

I the undersigned, hereby certify this data is correct to the best of my knowledge and belief and shows all the information required by law and the regulations issued and prescribed by the Office of Oil and Gas.


Signature

PRESIDENT

Title

6-13-25

Date

RECEIVED
Office Of Oil and Gas
JUL 17 2025
WV Department of
Environmental Protection

08/29/2025