

Well is located on topo map 2,045 feet south of Latitude: 39° 40' 00"

Well is located on topo map 9,356 feet west of Longitude: 80° 05' 00"

OIL & GAS WELLS
WITHIN 1200 FT.

REFERENCE NOT TO SCALE

MARK V. & BETTY EDDY

CHRISTOPHER PAUL EDDY, ET AL.

HICKORY SLUMP

ROSE MARY NAGY, ET AL.
TM/PA 4-15/8
DB/PG E379/535
75.97 ACRES

ROSE MARY NAGY, ET AL.

RONALD C. & PAMELA K. EDDY

MARK & BETTY EDDY

RONALD C. & PAMELA K. EDDY

WELL W.E. BOWEN #4

STATE OF WEST VIRGINIA
BUREAU OF COMMERCE

MARGARET R. PINGS

NOTE:
It is not the purpose or intention of this plat to represent surveyed local use of the surface or mineral interests depicted herein. The local use of the boundary lines, as shown, are based on recent field descriptions, field evidence found and/or tax map positions, unless otherwise noted.

Blue Mountain Inc.
11023 MASON DIXON HIGHWAY
BURTON, WV 25562
PHONE: (304) 662-6466

WELL LOCATION
UTM 17-NAD83
N:4390511.60
E:575781.54
NAD83, WV NORTH
N:423465.81
E:1794920.92
LAT/LONG DATUM-NAD83
LAT:39°39'39.80"
LON:80°06'59.65"

I, THE UNDERSIGNED, HEREBY CERTIFY THAT THIS
PLAT IS CORRECT TO THE BEST OF MY KNOWLEDGE AND
BELIEF AND SHOWS ALL THE INFORMATION REQUIRED BY
LAW AND THE REGULATIONS ISSUED AND PRESCRIBED BY
THE DEPARTMENT OF ENVIRONMENTAL PROTECTION.

Signed: **PRELIMINARY**

R.P.E.: _____ L.L.S.: P.S. No. 2000

PLACE SEAL HERE

GEORGE A. SIX
LICENSED
No. 2000
STATE OF
WEST VIRGINIA
PROFESSIONAL SURVEYOR

FILE #: W.E. BOWEN #4
DRAWING #: W.E. BOWEN #4
SCALE: 1" = 500'
MINIMUM DEGREE
OF ACCURACY: 1/2500
PROVEN SOURCE
OF ELEVATION: U.S.C.S. MONUMENT
THOMAS 1498.81'

(+) DENOTES LOCATION OF WELL ON
UNITED STATES TOPOGRAPHIC MAPS
WVDEP
OFFICE OF OIL & GAS
601 57TH STREET
CHARLESTON, WV 25304

DATE: JANUARY 3, 2017
OPERATOR'S WELL #: W.E. BOWEN #4
API WELL #: 47 61 71859
STATE COUNTY PERMIT

Well Type: ☐ Oil ☐ Waste Disposal ☐ Production ☐ Deep
☒ Gas ☐ Liquid Injection ☒ Storage ☒ Shallow

WATERSHED: DUNKARD CREEK ELEVATION: 1231.80

COUNTY/DISTRICT: MONONGALIA/CLAY QUADRANGLE: OSAGE, WV-PA 7.5'

SURFACE OWNER: ROSE MARY NAGY, ET AL. ACREAGE: 75.97


OIL & GAS ROYALTY OWNER: ACREAGE: _____

DRILL ☐ CONVERT ☐ DRILL DEEPER ☐ REDRILL ☐ FRACTURE OR STIMULANT TREATMENT ☐ PLUG OFF OLD FORMATION ☐ PERFORATE NEW FORMATION ☐ PLUG & ABANDON ☒ CLEAN OUT & REPLUG ☐ OTHER CHANGE ☐ (SPECIFY): _____

TARGET FORMATION: _____ ESTIMATED DEPTH: _____

WELL OPERATOR: NOUMENON CORPORATION DESIGNATED AGENT: _____
Address: 11023 MASON DIXON HIGHWAY Address: 11023 MASON DIXON HIGHWAY
City: BURTON State: WV Zip Code: 25562 City: BURTON State: WV Zip Code: 25562

08/29/2025

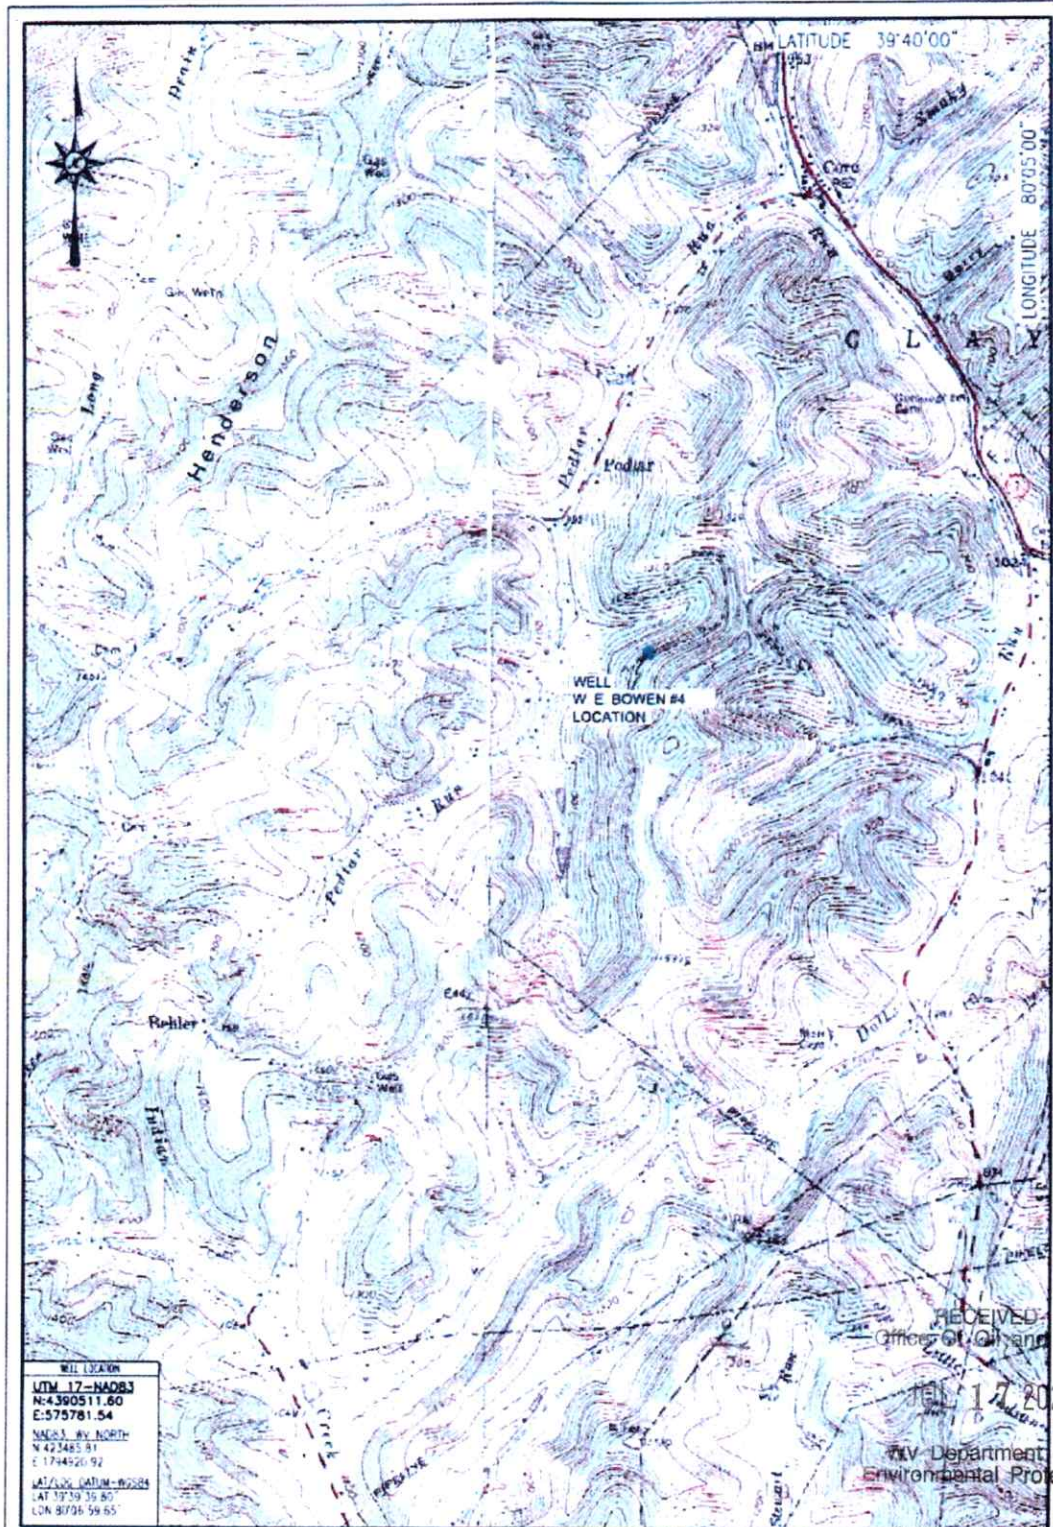

WELL LOCATION
UTM 17-NA083
N:4390511.60
E:575781.54
NAD83, WY NORTH
N 423485.91
E 1744520.92
WGS84 DATUM-WGS84
LAT 39°39'35.80"
LON 80°05'59.65"

RECEIVED
Office of Oil and Gas
JAN 17 2025
WV Department of
Environmental Protection


Blue Mountain Inc.
11023 MASON DIXON HIGHWAY
BURTON, WV 26562
PHONE: (304) 662-6486

W.E. BOWEN #4
OSAGE QUADRANGLE
WEST VIRGINIA

LOCATION MAP
JANUARY 3, 2017

Office of Oil & Gas

SCALE 1" = 2000'
0' 2000' 4000' 6000'

BLUE MOUNTAIN ENGINEERING

08/29/2025

WW-7
8-30-06



West Virginia Department of Environmental Protection
Office of Oil and Gas
WELL LOCATION FORM: GPS

API: 47-061-01774 WELL NO.: 4

FARM NAME: W.E. BOWEN

RESPONSIBLE PARTY NAME: NOUMENON CORPORATION

COUNTY: MONONGALIA DISTRICT: CLAY

QUADRANGLE: OSAGE, WV-PA 7.5'

SURFACE OWNER: CHRISTOPHER PAUL EDDY

ROYALTY OWNER: _____

UTM GPS NORTHING: 4390511.60

UTM GPS EASTING: 575781.54 GPS ELEVATION: 1231.86'

The Responsible Party named above has chosen to submit GPS coordinates in lieu of preparing a new well location plat for a plugging permit or assigned API number on the above well. The Office of Oil and Gas will not accept GPS coordinates that do not meet the following requirements:

1. Datum: NAD 1983, Zone: 17 North, Coordinate Units: meters, Altitude: height above mean sea level (MSL) – meters.
2. Accuracy to Datum – 3.05 meters
3. Data Collection Method:

Survey grade GPS ____: Post Processed Differential ____

Real-Time Differential ____

Mapping Grade GPS X: Post Processed Differential ____

Real-Time Differential ____

RECEIVED
Office Of Oil and Gas

JUL 17 2025

WV Department of
Environmental Protection

4. **Letter size copy of the topography map showing the well location.**

I the undersigned, hereby certify this data is correct to the best of my knowledge and belief and shows all the information required by law and the regulations issued and prescribed by the Office of Oil and Gas.


Signature

PRESIDENT

Title

6-13-25

Date

08/29/2025