

Well is located on topo map 5.463 feet west of Longitude: 80° 05' 00"

WELL LOCATION
UTM 17-NAD83
N: 4389430.05
E: 578978.97
NAD83, WV NORTH
N: 419871.33
E: 1798790.71
LAT/LG: DATUM=NAD83
LAT: 39° 39' 04.33"
LONG: 80° 06' 09.85"

STATE OF WEST VIRGINIA,
BUREAU OF COMMERCE

STATE OF WEST VIRGINIA,
BUREAU OF COMMERCE

STATE OF WEST VIRGINIA,
BUREAU OF COMMERCE

STATE OF WEST VIRGINIA,
BUREAU OF COMMERCE

RICHARD W. &
ELIZABETH B. BERGEN

CENTER FENCE POST

N 85° 50' 45" W
2012.63'

WELL
J.C. & R. MORRIS #1

S 77° 50' 20" W
1807.34'

MICHAEL R.
MORRIS

HAROLD M. SWIGER
C/O WILLARD R. &
WILMA L. SWIGER

STONE

DONNA N. &
ROBERT ALLEN WRIGHT

CONSOLIDATION COAL
COMPANY

OIL & GAS WELLS
WITHIN 1200 FT.

J.C. & R. MORRIS

REFERENCE NOT TO SCALE

NOTE:
It is not the purpose or intention of this plat to represent surveyed locations of the surface or mineral interests depicted thereon. The location of the boundary lines, as shown, are based on record case descriptions. Field evidence found and/or taken upon inspection, unless otherwise noted.

Blue Mountain Inc.
11023 MASON DIXON HIGHWAY
BURTON, WV 26602
PHONE: (304) 662-9486

FILE #: J.C. & R. MORRIS #1
DRAWING #: J.C. & R. MORRIS #1
SCALE: 1" = 500'
MINIMUM DEGREE OF ACCURACY: 1/2500
PROVEN SOURCE OF ELEVATION: U.S.G.S. MONUMENT THOMAS 1498.81'

(THE UNDERSIGNED, HEREBY CERTIFY THAT THIS PLAT IS CORRECT TO THE BEST OF MY KNOWLEDGE AND BELIEF AND SHOWS ALL THE INFORMATION REQUIRED BY LAW AND THE REGULATIONS ISSUED AND PRESCRIBED BY THE DEPARTMENT OF ENVIRONMENTAL PROTECTION.)

Signed: _____
R.P.E.: _____ L.L.S.: P.S. No. 2000

DATE: JANUARY 3, 2017
OPERATOR'S WELL #: J.C. & R. MORRIS #1
API WELL #: 47 61
STATE COUNTY PERMIT

WATERSHIED: DUNKARD CREEK ELEVATION: 1204.45'
COUNTY/DISTRICT: MONONGALIA/CLAY QUADRANGLE: OSAGE, WV-PA 7.5'
SURFACE OWNER: STATE OF WEST VIRGINIA, BUREAU OF COMMERCE ACREAGE: 120.95±
OIL & GAS ROYALTY OWNER: ACREAGE:


DRILL ☐ CONVERT ☐ DRILL DEEPER ☐ REDRILL ☐ FRACTURE OR STIMULATE ☐
PLUG OFF OLD FORMATION ☐ PERFORATE NEW FORMATION ☐ PLUG & ABANDON ☒
CLEAN OUT & REPLUG ☐ OTHER CHANGE ☐ (SPECIFY)

TARGET FORMATION: ESTIMATED DEPTH:

WELL OPERATOR: NOUMEN CORPORATION
Address: 2801 SOUTH MAIN STREET
City: State: Zip Code: 26044

DESIGNATED AGENT: KERRY L. HARRIS
Address: 1000 MARKET STREET, SUITE 100
City: State: Zip Code: 26044

RECEIVED
Office of Oil & Gas Environment
JUN 14 2017

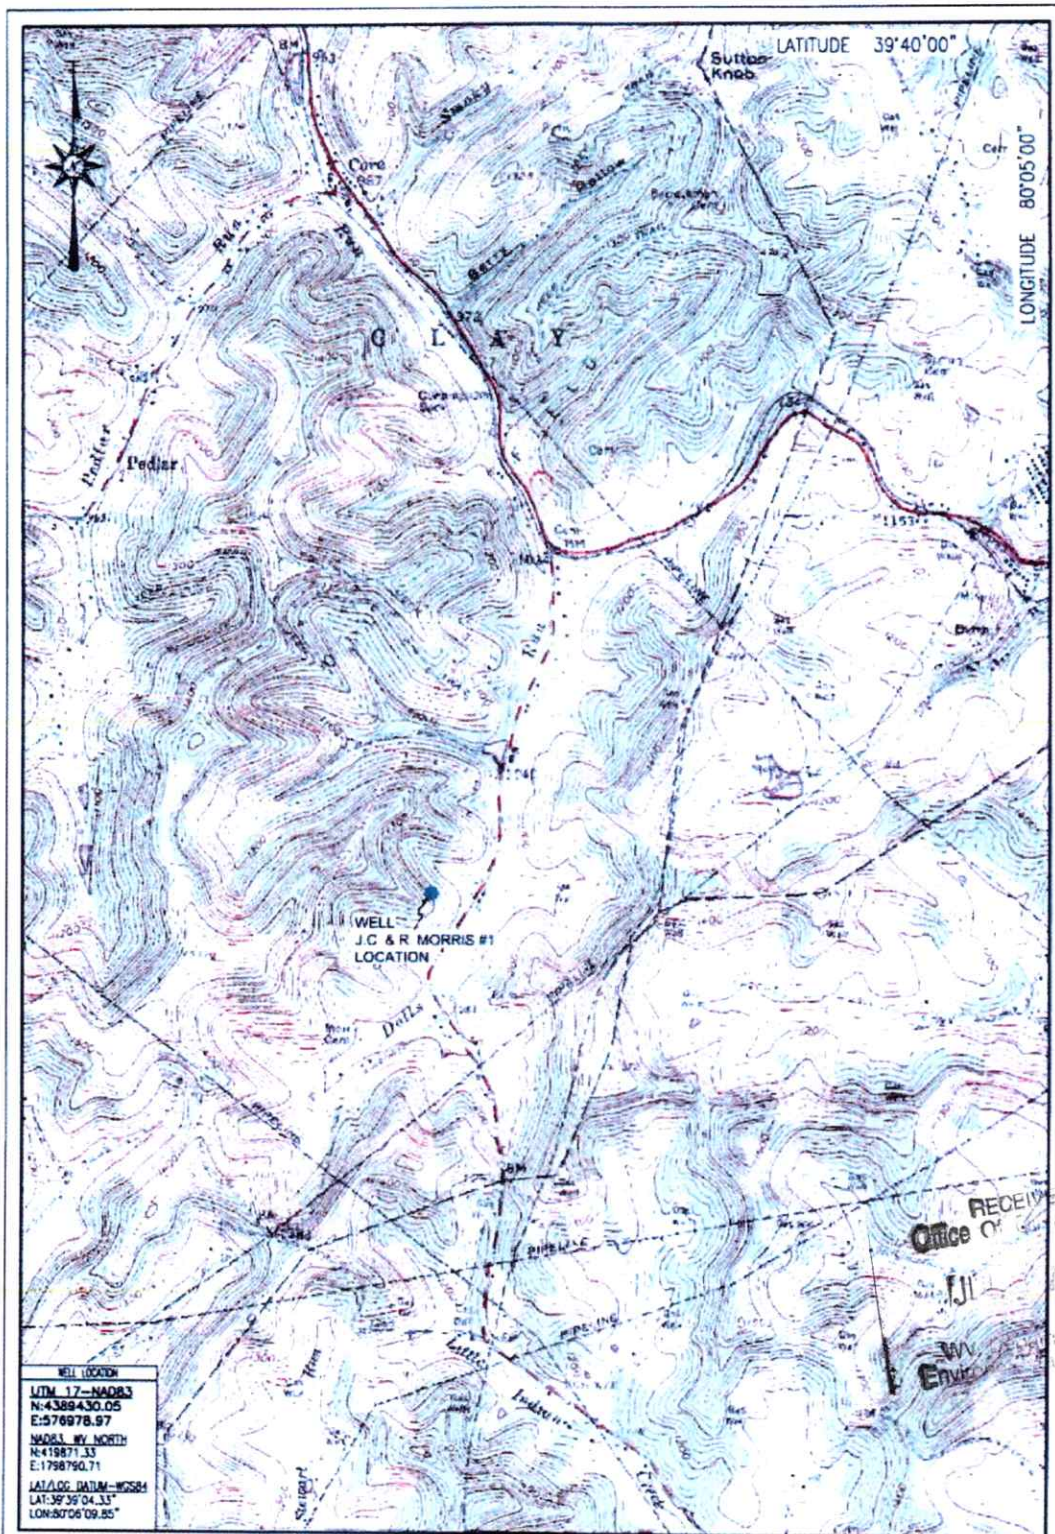

Blue Mountain Inc.
 11023 MASON DIXON HIGHWAY
 BURTON, WV 25862
 PHONE: (304) 662-6486

J.C. & R. MORRIS #1
 OSAGE QUADRANGLE
 WEST VIRGINIA

LOCATION MAP
 JANUARY 3, 2017

Received
 Office of Oil & Gas

SCALE 1" = 2000'
 0' 2000' 4000' 6000'

BLUE MOUNTAIN ENGINEERING

08/29/2025

WW-7
8-30-06



West Virginia Department of Environmental Protection
Office of Oil and Gas
WELL LOCATION FORM: GPS

API: 47-061-01777 WELL NO.: 1

FARM NAME: J.C.&R. MORRIS #1

RESPONSIBLE PARTY NAME: NOUMENON CORPORATION

COUNTY: MONONGALIA DISTRICT: CLAY

QUADRANGLE: OSAGE, WV-PA 7.5'

SURFACE OWNER: WV BUREAU OF COMMERCE C/O DIV. OF NATURAL RESOURCES

ROYALTY OWNER: _____

UTM GPS NORTHING: 4389430.05

UTM GPS EASTING: 576978.97 GPS ELEVATION: 1204.45

The Responsible Party named above has chosen to submit GPS coordinates in lieu of preparing a new well location plat for a plugging permit or assigned API number on the above well. The Office of Oil and Gas will not accept GPS coordinates that do not meet the following requirements:

1. Datum: NAD 1983, Zone: 17 North, Coordinate Units: meters, Altitude: height above mean sea level (MSL) – meters.
2. Accuracy to Datum – 3.05 meters
3. Data Collection Method:

Survey grade GPS ____: Post Processed Differential ____

Real-Time Differential ____

Mapping Grade GPS X: Post Processed Differential ____

Real-Time Differential ____

4. **Letter size copy of the topography map showing the well location.**

I the undersigned, hereby certify this data is correct to the best of my knowledge and belief and shows all the information required by law and the regulations issued and prescribed by the Office of Oil and Gas.


Signature

PRESIDENT

Title

6.13.25

Date

RECEIVED
Office Of Oil and Gas

JUL 17 2025

WV Department of
Environmental Protection

08/29/2025