


FILE #: NNE15
 DRAWING #: 2943
 SCALE: PLAT: 1" = 1600'
 TCK: 1" = 2000'
 MINIMUM DEGREE OF ACCURACY: 1/200
 PROVEN SOURCE OF ELEVATION: SUBMETER MAPPING GRADE GPS

I, THE UNDERSIGNED, HEREBY CERTIFY THAT THIS PLAT IS CORRECT TO THE BEST OF MY KNOWLEDGE AND BELIEF AND SHOWS ALL THE INFORMATION REQUIRED BY LAW AND THE REGULATIONS ISSUED AND PRESCRIBED BY THE DEPARTMENT OF ENVIRONMENTAL PROTECTION.
 Signed: *[Signature]*
 L.L.S. #2124 : Ernest J. Benchek III

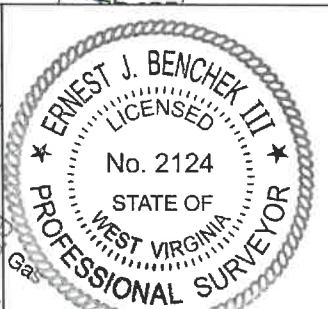

(+) DENOTES LOCATION OF WELL ON UNITED STATES TOPOGRAPHIC MAPS WVDEP
 OFFICE OF OIL & GAS
 601 57TH STREET
 CHARLESTON, WV 25304

Well Type: Oil Waste Diposal Production Deep
 Gas Liquid Injection Storage Shallow

WATERSHED: DUNKARD CREEK
 COUNTY/DISTRICT: MONONGALIA / CLAY
 SURFACE OWNER: JERRY L. YOST ET AL
 OIL & GAS ROYALTY OWNER: NNE LLC, et al
 LEASE NUMBERS:

DATE: APRIL 15, 2021
 OPERATOR'S WELL #: CUMMINS 2H AS-DRILLED
 API WELL #: 47 61 01828
 STATE COUNTY PERMIT
 AS-BUILT ELEVATION: 1,358.80'
 QUADRANGLE: BLACKSVILLE
 ACREAGE: 81.472 +/-
 ACREAGE: 674.928 +/-

DRILL CONVERT DRILL DEEPER REDRILL FRACTURE OR STIMULATE
 PLUG OFF FORMATION PERFORATE NEW FORMATION PLUG & ABANDON
 CLEAN OUT & REPLUG OTHER CHANGE (SPECIFY):

TARGET FORMATION: MARCELLUS
 DRILLED DEPTH: TVD: 8,177' TMD: 17,271'
 WELL OPERATOR: NORTHEAST NATURAL ENERGY LLC
 ADDRESS: 707 VIRGINIA STREET EAST, SUITE 1200
 CITY: CHARLESTON STATE: WV ZIP CODE: 25301
 DESIGNATED AGENT: JOHN ADAMS
 ADDRESS: 707 VIRGINIA STREET EAST, SUITE 1200
 CITY: CHARLESTON STATE: WV ZIP CODE: 25301

08/13/2021

PROPERTY OWNER INDEX	
4-17-71	JERRY L. YOST ET AL
4-17-72	JERRY L YOST
4-17-68	LEONARD MICHAEL YOHO
4-17-66	MELVIN LUTHER EDDY ET AL
4-17-67	LISA D & STEVEN E WHITE
4-10-75	RICKY N & DOUGLAS N WILSON
4-10-75.8	DOUGLAS N WILSON
4-10-46.5	EDWARD & AVA MARIE TENNANT
4-10-46.2	EDWARD & AVA MARIE TENNANT
4-10-46	JOHN BELL & STEPHANIE WILSON
4-10-47.5	ROBERT JOE TENNANT
4-10-47.3	ROBERT JOE TENNANT
4-10-47.7	WILLIAM G & MARY L TENNANT
4-10-47.4	WILLIAM G & MARY L TENNANT
4-10-49	BILLY JO & JANET EDDY
4-10-39.3	JOSHUA BLAINE & NOAH BLAINE LEMLEY
4-10-47	ROBERT JOE TENNANT
4-10-39.1	WILLIE B & WENDY LEMLEY
4-10-39	MARY LOU VERBOSKY
4-10-38	JASON G STOUT
4-10-50.2	JASON G STOUT
4-10-39.2	ERIC & SARA VERBOSKY
4-10-36.2	JASON G STOUT
4-10-36	JASON G STOUT

LEASE INDEX			
A	WV-061-003499-001	J	WV-061-003693-002
B	WV-061-004599-060	K	WV-061-003693-002
C	WV-061-00127-001-LA	L	WV-061-004387-087
D	WV-061-003023-014	M	WV-061-004387-092
E	WV-061-001620-008	N	WV-061-004387-092
F	WV-061-003837-008	O	WV-061-004387-087
G	WV-061-003255-001	P	WV-061-005332-001
H	WV-061-003255-001	Q	WV-061-005332-001
I	WV-061-003255-001	R	WV-061-005332-001
		S	WV-061-005332-001

08/13/2021

FILE #: NEE15
DRAWING #: 2943
SCALE: N/A

DATE: APRIL 15, 2021
OPERATOR'S WELL #: CUMMINS 2H
API WELL #: 47 61
STATE COUNTY PERMIT