


FILE #: NEE14
 DRAWING #: 2948
 SCALE: PLAT: 1" = 2200' TICK MARK: 1" = 2000'
 MINIMUM DEGREE OF ACCURACY: 1/200
 PROVEN SOURCE OF ELEVATION: SUBMETER MAPPING GRADE GPS

I, THE UNDERSIGNED, HEREBY CERTIFY THAT THIS PLAT IS CORRECT TO THE BEST OF MY KNOWLEDGE AND BELIEF AND SHOWS ALL THE INFORMATION REQUIRED BY LAW AND THE REGULATIONS ISSUED AND PRESCRIBED BY THE DEPARTMENT OF ENVIRONMENTAL PROTECTION.
 Signed: *[Signature]*
 L.L.S. #2124 : Ernest J. Benchek III

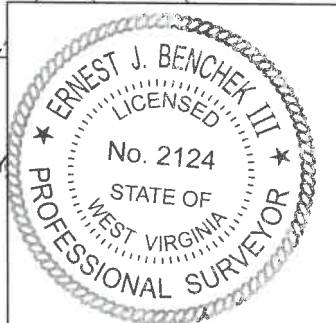

(+) DENOTES LOCATION OF WELL ON UNITED STATES TOPOGRAPHIC MAPS
 WVDEP
 OFFICE OF OIL & GAS
 601 57TH STREET
 CHARLESTON, WV 25304
 Well Type: Oil Waste Diposal Production Deep Gas Liquid Injection Storage Shallow
 WATERSHED: DUNKARD CREEK
 COUNTY/DISTRICT: MONONGALIA / CLAY
 SURFACE OWNER: PATRICIA A. BUNNER
 OIL & GAS ROYALTY OWNER: PATRICIA BUNNER, et al
 LEASE NUMBERS:

DATE: MARCH 11, 2022
 OPERATOR'S WELL #: BUNNER 2H
 API WELL #: 47 61 01868
 STATE COUNTY PERMIT
 AS-BUILT
 ELEVATION: 1277.25'
 QUADRANGLE: BLACKSVILLE, WV
 ACREAGE: 94.72 +/-
 ACREAGE: 758.708 + **09/02/2022**

DRILL CONVERT DRILL DEEPER REDRILL FRACTURE OR STIMULATE
 PLUG OFF FORMATION PERFORATE NEW FORMATION PLUG & ABANDON
 CLEAN OUT & REPLUG OTHER CHANGE (SPECIFY):
 TARGET FORMATION: MARCELLUS
 WELL OPERATOR: NORTHEAST NATURAL ENERGY LLC
 ADDRESS: 707 VIRGINIA STREET EAST, SUITE 1200
 CITY: CHARLESTON STATE: WV ZIP CODE: 25301
 DRILLED DEPTH: TVD: 8,116' TMD: 24,286'
 DESIGNATED AGENT: JOHN ADAMS
 ADDRESS: 707 VIRGINIA STREET EAST, SUITE 1200
 CITY: CHARLESTON STATE: WV ZIP CODE: 25301

PROPERTY OWNER INDEX	
4-18-32	PATRICIA A. BUNNER
4-18-34	GORDON PROPERTIES LLC
4-17-12	FREDDIE W. EDDY II & SALLY L. EDDY
4-17-13	HARRY D. HAMILTON (LIFE - FRANCES H. HAMILTON)
4-17-15.4	DANIEL S. & KIMBERLY S. BRUMMAGE
4-17-15.1	ADAM WILLIAMS TRUST
4-17-15.5	DANIEL S. & KIMBERLY S. BRUMMAGE
4-17-14.1	CAROL A. HALLER
4-17-22.1	JACK R. & JUDY ROGERS
4-17-15	DANIEL S. & KIMBERLY S. BRUMMAGE
4-17-22	GARY D. YOST, KELLI D. WILSON & LORRI E. KUHN
4-17-20.2	GARY & JANET SHRIVER
4-17A-9.1	GARY D. YOST (LIFE - ELLEN RUTH YOST)
4-17A-10	GARY D. YOST, KELLI D. WILSON & LORRI E. KUHN
4-17-23	GARY D. YOST, KELLI D. WILSON & LORRI E. KUHN
4-17-53	MARY D. & WILLIAM L. & LINDSAY J. & GEOGIE E. TENNANT
4-20-11.1	M3 APPALACHIA GATHERING LLC
4-20-11	HERBERT EARL HAMILTON
4-20-25.1	RONALD W & SHELIA A COSNER (DD- SHERRY COSNER-MARENTAY)
4-20-58.4	BONNIE JOANN RONK
4-20-58.9	JOSHUA & SAMUEL A HOLMES
4-20-58	BRIAN KYLE LEMLEY
4-20-55	UNITED STATES OF AMERICA
4-20-52.1	MARION A & ODRA R MITCHELL
4-20-53	UNITED STATES OF AMERICA
4-20-54	DOROTHY WEST ESTATE ET AL
4-25-15	PEGGY SUE & WARREN FLOYD CHINNICK
4-25-15.2	ZACHARY B & DELLA M JOHNSON

LEASE INDEX			
A	WV-061-004154-001	K	WV-061-003539-003
B	WV-061-000683-120	L	WV-061-001052-002
C	WV-061-004249-001	M	WV-061-0005714-001
D	WV-061-003298-001	N	WV-061-005416-001
E	WV-061-005270-037	O	WV-061-005551-002
F	WV-061-003325-011	P	WV-061-004555-004
G	WV-061-003325-011	Q	WV-061-004235-008
H	WV-061-003325-011	R	WV-061-004235-008
I	WV-061-005195-002	S	WV-061-004504-001
J	WV-061-003261-001		

09/02/2022

FILE #: <u>NEE14</u>	DATE: <u>MARCH 11, 2022</u>
DRAWING #: <u>2948</u>	OPERATOR'S WELL #: <u>BUNNER 2H</u>
SCALE: <u>N/A</u>	API WELL #: <u>47</u> <u>61</u> <u>01868</u> STATE COUNTY PERMIT