


FILE #: NEE14
 DRAWING #: 2947
 SCALE: PLAT: 1" = 2200'
 TICK MARK: 1" = 2000'
 MINIMUM DEGREE OF ACCURACY: 1/200
 PROVEN SOURCE OF ELEVATION: SUBMETER MAPPING GRADE GPS

I, THE UNDERSIGNED, HEREBY CERTIFY THAT THIS PLAT IS CORRECT TO THE BEST OF MY KNOWLEDGE AND BELIEF AND SHOWS ALL THE INFORMATION REQUIRED BY LAW AND THE REGULATIONS ISSUED AND PRESCRIBED BY THE DEPARTMENT OF ENVIRONMENTAL PROTECTION.
 Signed: *[Signature]*
 L.L.S. #2124 : Ernest J. Benchek III

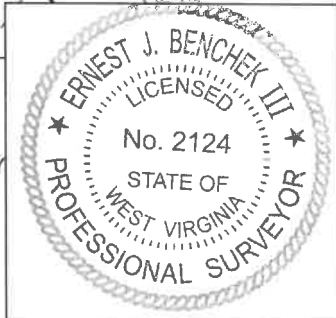

(+) DENOTES LOCATION OF WELL ON UNITED STATES TOPOGRAPHIC MAPS
 WVDEP
 OFFICE OF OIL & GAS
 601 57TH STREET
 CHARLESTON, WV 25304

Well Type: Oil Waste Diposal Production Deep
 Gas Liquid Injection Storage Shallow

WATERSHED: DUNKARD CREEK

COUNTY/DISTRICT: MONONGALIA / CLAY

SURFACE OWNER: PATRICIA A. BUNNER

OIL & GAS ROYALTY OWNER: PATRICIA BUNNER, et al

LEASE NUMBERS:

DATE: MARCH 11, 2022

OPERATOR'S WELL #: BUNNER 8H

API WELL #: 47 STATE 61 COUNTY 01870 PERMIT

AS-BUILT
 ELEVATION: 1277.25'

QUADRANGLE: BLACKSVILLE, WV

ACREAGE: 94.72 +/-

ACREAGE: 915.251 **09/02/2022**

DRILL CONVERT DRILL DEEPER REDRILL FRACTURE OR STIMULATE
 PLUG OFF FORMATION PERFORATE NEW FORMATION PLUG & ABANDON
 CLEAN OUT & REPLUG OTHER CHANGE (SPECIFY):

TARGET FORMATION: MARCELLUS

WELL OPERATOR: NORTHEAST NATURAL ENERGY LLC
 ADDRESS: 707 VIRGINIA STREET EAST, SUITE 1200
 CITY: CHARLESTON STATE: WV ZIP CODE: 25301

DRILLED DEPTH: TVD: 8,101' TMD: 25,173'
 DESIGNATED AGENT: JOHN ADAMS
 ADDRESS: 707 VIRGINIA STREET EAST, SUITE 1200
 CITY: CHARLESTON STATE: WV ZIP CODE: 25301

PROPERTY OWNER INDEX	
4-18-32	PATRICIA A. BUNNER
4-18-30	PRUDENCE G BERRY
4-18-31	ROBERT ELDON & PRUDENCE BERRY; GAIL & DEBRA JEAN JONES
4-18-29.1	BILLY VON DEVINE
4-18-34	GORDON PROPERTIES LLC
4-17-15	DANIEL S. & KIMBERLY S. BRUMMAGE
4-17-16.3	YOST HIRITAGE INC
4-17-16.5	DOUGLAS J. & CHERAL A. SKINNER
4-17-19.5	ROGER & LISA YOST
4-17-19.3	ROGER & LISA YOST
4-17-19.2	ROSE MALOTT
4-17-19.4	ROGER & LISA YOST
4-17-19	ROGER & LISA YOST
4-17-19.1	CNX LAND LLC
4-17-53	MARY D. & WILLIAM L. & LINDSAY J. & GEOGIE E. TENNANT
4-17-20	BRIAN E. & MELISSA L. EDDY
4-20-10	KAREN D. & KEVIN S. OWENS ET AL (LIFE - KAREN D. OWENS)
4-20-11.1	M3 APPALACHIA GATHERING LLC
4-20-8	JANICE WILSON
4-20-11	HERBERT EARL HAMILTON
4-20-31	RICHARD CHRISTOPHER TENNANT
4-20-25.1	RONALD W & SHELIA A COSNER
4-20-58.2	DEREK D & MIMI J WILLIAMS
4-20-25	DEREK D & MIMI J WILLIAMS
4-20-49	BRIAN KYLE LEMLEY
4-20-54	DOROTHY WEST ESTATE ET AL
4-20-50	WILLIAM FRANKLIN BOGGESS
4-20-53	UNITED STATES OF AMERICA
4-25-15	PEGGY SUE & WARREN FLOYD CHINNICK
4-25-15.2	ZACHARY B & DELLA M JOHNSON
4-25-15.1	ZACHARY B & DELLA M JOHNSON
4-25-15.3	JOSEPH JOHNSON
4-25-09	DOROTHY WEST ESTATE ET AL
4-25-52	DOROTHY WEST ESTATE ET AL

LEASE INDEX			
A	WV-061-004154-001	P	WV-061-005714-001
B	WV-061-005368-015	Q	WV-061-005416-001
C	WV-061-005378-013	R	WV-061-005716-001
D	WV-061-005639-001	S	WV-061-005717-001
E	WV-061-000175-000	T	WV-061-004555-004
F	WV-061-000683-120	U	WV-061-005715-001
G	WV-061-003325-011	V	WV-061-005551-002
H	WV-061-001051-001	W	WV-061-004235-026
I	WV-061-003260-001	X	WV-061-005757-001
J	WV-061-003323-001	Y	WV-061-004235-015
K	WV-061-003539-003	Z	WV-061-004504-001
L	WV-061-003299-013	AA	WV-061-004504-001
M	WV-061-003747-001		
N	WV-061-001052-002		
O	WV-061-003862-001		

09/02/2022

FILE #: NEE14

DRAWING #: 2947

SCALE: N/A

DATE: MARCH 11, 2022

OPERATOR'S WELL #: BUNNER 8H

API WELL #: 47 61 01870
STATE COUNTY PERMIT