


FILE #: NNE14
 DRAWING #: 2963
 SCALE: PLAT: 1" = 2000'
 TICK: 1" = 2000'
 MINIMUM DEGREE OF ACCURACY: 1/200
 PROVEN SOURCE OF ELEVATION: SUBMETER MAPPING GRADE GPS

I, THE UNDERSIGNED, HEREBY CERTIFY THAT THIS PLAT IS CORRECT TO THE BEST OF MY KNOWLEDGE AND BELIEF AND SHOWS ALL THE INFORMATION REQUIRED BY LAW AND THE REGULATIONS ISSUED AND PRESCRIBED BY THE DEPARTMENT OF ENVIRONMENTAL PROTECTION.
 Signed: *[Signature]*
 L.L.S. #2124 : Ernest J. Benchek III

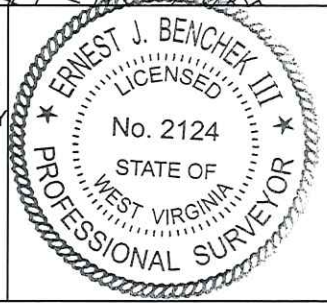

(+) DENOTES LOCATION OF WELL ON UNITED STATES TOPOGRAPHIC MAPS
 WVDEP
 OFFICE OF OIL & GAS
 601 57TH STREET
 CHARLESTON, WV 25304

DATE: SEPTEMBER 28, 2023
 OPERATOR'S WELL #: McCLELLAN 2H AS-DRILLED
 API WELL #: 47 61
 STATE COUNTY PERMIT
 AS-BUILT ELEVATION: 1,411.7'

Well Type: Oil Waste Dipsal Production Deep
 Gas Liquid Injection Storage Shallow

WATERSHED: UPPER MONONGAHELA
 COUNTY/DISTRICT: MONONGALIA / BATTELLE
 SURFACE OWNER: KLONDIKE REAL ESTATE PARTNERSHIP
 OIL & GAS ROYALTY OWNER: Barbara June Sutton, et al
 LEASE NUMBERS:

QUADRANGLE: MANNINGTON
 ACREAGE: 440.44 +/-
 ACREAGE: 129.4 +/-

DRILL CONVERT DRILL DEEPER REDRILL FRACTURE OR STIMULATE
 PLUG OFF FORMATION PERFORATE NEW FORMATION PLUG & ABANDON
 CLEAN OUT & REPLUG OTHER CHANGE (SPECIFY):

TARGET FORMATION: MARCELLUS
 DRILLED DEPTH: TVD: 8,136' TMD: 20,210'
 WELL OPERATOR: NORTHEAST NATURAL ENERGY LLC
 ADDRESS: 707 VIRGINIA STREET EAST, SUITE 1200
 CITY: CHARLESTON STATE: WV ZIP CODE: 25301
 DESIGNATED AGENT: JOHN ADAMS
 ADDRESS: 707 VIRGINIA STREET EAST, SUITE 1200
 CITY: CHARLESTON STATE: WV ZIP CODE: 25301

10/06/2023

| PROPERTY OWNER INDEX | |
|----------------------|---|
| 1-26-7 | KLONDIKE REAL ESTATE PARTNERSHIP |
| 1-26-15 | KELSI L. & PRESTON K. WILSON |
| 1-26-17 | KELSI L. & PRESTON K. WILSON |
| 1-26-18 | CHARLENE CHAPMAN & DALE REISING |
| 16-1-1 | CONSOLIDATION COAL COMPANY |
| 16-1-8 | CONSOLIDATION COAL COMPANY |
| 16-1-11 | MARSHA E. & BRADLEY D. WOLFE |
| 16-1-9 | ZACHARY R. & JACQUELINE E. PHILLIPS |
| 1-26-6 | ROBERT G, SIMON, HAROLD & DANIEL SANTEE EST ET AL |
| 16-2-32 | DOROTHY GRIEGER |
| 16-2-31 | CONSOLIDATION COAL COMPANY |
| 16-3-50 | DONALD & PATRICIA PYLES |
| 16-3-42 | SHIRLEY L MOORE |
| 16-3-45 | JOEY DAWN & GILLESPIE |
| 16-3-46 | JOEY DAWN & GILLESPIE |
| 16-3-46.1 | JOHN & DONNA HLUSKO |
| 16-3-47 | RONALD D & JOANN PARRISH |

| LEASE INDEX | | | |
|-------------|-------------------|---|-------------------|
| A | WV-061-004172-011 | I | WV-049-005482-001 |
| B | WV-061-004173-066 | J | WV-049-800042-001 |
| C | WV-061-005241-001 | K | WV-049-004233-047 |
| D | WV-061-004560-050 | L | WV-049-800042-001 |
| E | WV-061-004793-039 | M | WV-049-005804-001 |
| F | WV-061-005509-006 | N | WV-049-005664-003 |
| G | WV-049-004839-001 | O | WV-049-005664-003 |
| H | WV-049-005482-001 | P | WV-049-005693-003 |
| | | Q | WV-049-005236-000 |

10/06/2023

FILE #: NEE14

DRAWING #: 2963

SCALE: N/A

DATE: SEPTEMBER 28, 2023

OPERATOR'S WELL #: McCLELLAN 2H

API WELL #: 47 61
STATE COUNTY PERMIT