

FILE #: NNE14
 DRAWING #: 2964
 SCALE: PLAT: 1" = 2000'
 TICK: 1" = 2000'


MINIMUM DEGREE OF ACCURACY: 1/200

PROVEN SOURCE OF ELEVATION: SUBMETER MAPPING GRADE GPS

I, THE UNDERSIGNED, HEREBY CERTIFY THAT THIS PLAT IS CORRECT TO THE BEST OF MY KNOWLEDGE AND BELIEF AND SHOWS ALL THE INFORMATION REQUIRED BY LAW AND THE REGULATIONS ISSUED AND PRESCRIBED BY THE DEPARTMENT OF ENVIRONMENTAL PROTECTION.

Signed: *[Signature]*

L.L.S. #2124 : Ernest J. Benchek III

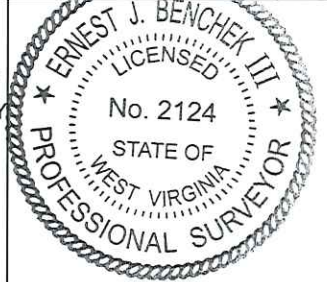

(+) DENOTES LOCATION OF WELL ON UNITED STATES TOPOGRAPHIC MAPS

WVDEP
 OFFICE OF OIL & GAS
 601 57TH STREET
 CHARLESTON, WV 25304

Well Type: Oil Waste Diposal Production Deep
 Gas Liquid Injection Storage Shallow

WATERSHED: UPPER MONONGAHELA

COUNTY/DISTRICT: MONONGALIA / BATTELLE

SURFACE OWNER: KLONDIKE REAL ESTATE PARTNERSHIP

OIL & GAS ROYALTY OWNER: Barbara June Sutton, et al

LEASE NUMBERS:

DRILL CONVERT DRILL DEEPER REDRILL FRACTURE OR STIMULATE
 PLUG OFF FORMATION PERFORATE NEW FORMATION PLUG & ABANDON
 CLEAN OUT & REPLUG OTHER CHANGE (SPECIFY):

TARGET FORMATION: MARCELLUS

WELL OPERATOR: NORTHEAST NATURAL ENERGY LLC

ADDRESS: 707 VIRGINIA STREET EAST, SUITE 1200

CITY: CHARLESTON STATE: WV ZIP CODE: 25301

DATE: SEPTEMBER 28, 2023

OPERATOR'S WELL #: McCLELLAN 4H AS-DRILLED

API WELL #: 47 61
 STATE COUNTY PERMIT

AS-BUILT ELEVATION: 1,411.7'

QUADRANGLE: MANNINGTON

ACREAGE: 609.66 +/-

ACREAGE: 129.4 +/-

10/06/2023

PROPERTY OWNER INDEX	
1-26-7	KLONDIKE REAL ESTATE PARTNERSHIP
1-26-14	KEVIN D. & MARLA J. AMMONS
1-26-15	KELSI L. & PRESTON K. WILSON
1-26-14.2	KEVIN D. & MARLA J. AMMONS
1-26-21.4	DONALD R. & JUDY A. PETHTEL
1-26-15.1	MICHAEL TODD WRIGHT
1-26-21.3	DONALD R. & JUDY A. PETHTEL
1-26-22.1	GARY A. & TAMMY L. NICHOLSON
1-26-21.2	JERRY & JANICE SUE FLUHARTY
1-26-21.1	BETTY LOU FLUHARTY
1-26-22	RANDY L. & TRINA R. TENNANT
1-26-24	STEVEN T. & MISTY R. NICHOLSON
1-26-25	SUSAN TENNANT & DELAS STUZEN
1-26-26	SUSAN TENNANT & DELAS STUZEN
1-26-27.2	BREDNA HARDESTY & FRANK HENSEY
1-26-27	MICHAEL J. GLENN
1-26-9	GARY A & TAMMY L NICHOLSON
1-26-18	CHARLENE CHAPMAN & DALE REISING
1-26-23	RANDY L & TRINA R TENNANT
16-2-37	REKAB LLC
16-2-32	DOROTHY GRIEGER
16-1-12	DOUGLAS M. JONES
16-1-11	MARSHA E. & BRADLEY D. WOLFE
16-1-11.1	MARSHA E. & BRADLEY D. WOLFE
16-1-9.1	ONEITA A. OPYOKE
16-1-9.2	VIRGINIA T. HULL
16-1-9	ZACHARY R. & JACQUELINE E. PHILLIPS
16-1-10	ZACHARY R. & JACQUELINE E. PHILLIPS
16-2-26	L. B. UNDERWOOD EST
16-2-27	B. A. & L. A. AMMONS
16-2-35	REKAB LLC
16-2-28	CONSOLIDATION COAL COMPANY
16-2-28.1	CONSOLIDATION COAL COMPANY
16-2-35.2	JOHN & SHARON TIANO
16-2-36.2	LACK LOWE
16-4-7	JACK E. & ROWENA LOWE
16-4-32	JACK E. & ROWENA LOWE
16-4-6	ROBERT D. & NORMA J. HOOD
16-2-36	SANDRA & MICHAEL LAYMAN
16-4-5	BETHANY L RETTON
16-4-9	MARILYN S CHISLER
16-4-10	MARILYN S CHISLER
16-4-13	STEPHEN L CHISLER
16-4-14.2	STANLEY T HAUGHT Jr & RHONA L HAUGHT
16-4-13.1	BDW MANAGEMENT INC
16-4-14.1	FAIRVIEW FURNACE & SHEET METAL INC
16-4-16	SHARON K HOUGHTON DELMAS
16-4-17	TIMOTHY L OR SHERRY L GUMP
16-4-18	NORMA J & ROBERT L YOST
16-4-4	JAMES L & CATHY A HARTZELL
16-4-20	GARRET L KELLEY
16-4-19	DELORES L WHITE
16-4-15.2	BENNETT E. & CATHIE S. HAUGHT

LEASE INDEX	
A	WV-061-004172-011
B	WV-061-000146-001
	WV-061-005656-003
C	WV-061-004381-001
D	WV-061-004381-002
E	WV-061-005241-001
F	WV-061-004793-039
G	WV-061-004381-001
H	WV-061-004560-050
I	WV-061-004793-039
J	WV-061-005120-001
K	WV-061-004560-050
L	WV-061-005106-001
M	WV-061-005106-001
N	WV-061-005106-001
O	WV-061-004734-001
P	WV-061-004793-039
Q	WV-061-005509-006
R	WV-049-004233-047
S	WV-061-000146-001
T	WV-049-005251-000
U	WV-049-005680-000
V	WV-049-005680-000

10/06/2023

FILE #: NEE14

DRAWING #: 2964

SCALE: N/A

DATE: SEPTEMBER 28, 2023

OPERATOR'S WELL #: McCLELLAN 4H

API WELL #: 47 61
STATE COUNTY PERMIT