


FILE #: NNE14  
 DRAWING #: 2998  
 SCALE: PLAT: 1" = 2000'  
TICK: 1" = 2000'  
 MINIMUM DEGREE OF ACCURACY: 1/200  
 PROVEN SOURCE OF ELEVATION: SUBMETER MAPPING GRADE GPS

I, THE UNDERSIGNED, HEREBY CERTIFY THAT THIS PLAT IS CORRECT TO THE BEST OF MY KNOWLEDGE AND BELIEF AND SHOWS ALL THE INFORMATION REQUIRED BY LAW AND THE REGULATIONS ISSUED AND PRESCRIBED BY THE DEPARTMENT OF ENVIRONMENTAL PROTECTION.  
 Signed: [Signature]  
 L.L.S. #2124 : Ernest J. Benchek III

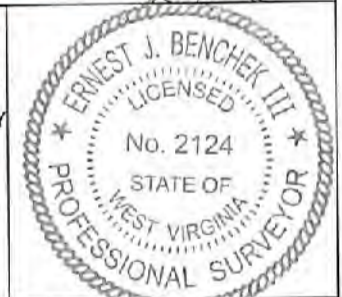

(+) DENOTES LOCATION OF WELL ON UNITED STATES TOPOGRAPHIC MAPS  
 WYDEP  
 OFFICE OF OIL & GAS  
 601 57TH STREET  
 CHARLESTON, WV 25304

Well Type:  Oil  Waste Disposal  Production  Deep  
 Gas  Liquid Injection  Storage  Shallow

WATERSHED: UPPER MONONGAHELA  
 COUNTY/DISTRICT: MONONGALIA / BATTELLE  
 SURFACE OWNER: KLONDIKE REAL ESTATE PARTNERSHIP  
 OIL & GAS ROYALTY OWNER: Barbara June Sutton, et al  
 LEASE NUMBERS: \_\_\_\_\_

DATE: MAY 24, 2022  
 OPERATOR'S WELL #: McCLELLAN 11H  
 API WELL #: 47 61 01898 140D  
 STATE COUNTY PERMIT  
 AS-BUILT ELEVATION: 1,411.7'

QUADRANGLE: MANNINGTON  
 ACREAGE: 1,306.3 +/-  
 ACREAGE: 129.4 + 06/24/2022

TARGET FORMATION: MARCELLUS  
 WELL OPERATOR: NORTHEAST NATURAL ENERGY LLC  
 ADDRESS: 707 VIRGINIA STREET EAST, SUITE 1200  
 CITY: CHARLESTON STATE: WV ZIP CODE: 25301

DRILL  CONVERT  DRILL DEEPER  REDRILL  FRACTURE OR STIMULATE   
 PLUG OFF FORMATION  PERFORATE NEW FORMATION  PLUG & ABANDON   
 CLEAN OUT & REPLUG  OTHER CHANGE  (SPECIFY): \_\_\_\_\_

ESTIMATED DEPTH: TVD: 8,001' TMD: 25,516'  
 DESIGNATED AGENT: JOHN ADAMS  
 ADDRESS: 707 VIRGINIA STREET EAST, SUITE 1200  
 CITY: CHARLESTON STATE: WV ZIP CODE: 25301

PROPERTY OWNER INDEX	
1-26-7	KLONDIKE REAL ESTATE PARTNERSHIP
1-26-6	ROBERT G SANTEE ESTATE
1-26-5	CONSOL MINING COMPANY LLC
1-24-7	CNX LAND LLC
1-23-33	CONSOL MINING COMPANY LLC
1-26-1	CONSOL MINING COMPANY LLC
1-24-6	ALLEGHENY FORESTLANDS LLC
1-24-5	THERESA TUTTLE & FRANCIS GREGORY SWISHER
1-23-10.5	JAMES N STILES III & AMANDA LYNN STILES
1-23-10.4	DONALD & JANICE WHITE
1-23-10.6	CONSOL MINING COMPANY LLC
1-23-9.2	MICHAEL A & KAREN J HORNYAK
1-23-8	TOMMY JR & JENNIFER R EDDY
1-23-7	KEVIN J & DEBORAH K RIFFLE
1-23-9	BOBBY J LISTON
1-18-43	BETTY J MARTINO
1-18-42.2	RAYMOND & MARY BENNER
1-18-42.4	JAMES IAN & CARLA JEAN SHEETS
1-18-41	NOVA (HENDERSON) SHEETS
1-18-42	RAYMOND & MARY BENNER
1-18-40	THOMAS E & SHIRLEY S WALKER

LEASE INDEX			
A	WV-061-004172-011	I	WV-061-004369-001
B	WV-061-004173-066	J	WV-061-004369-001
C	WV-061-005769-001	K	WV-061-004369-001
D	WV-061-004002-005	L	WV-061-005769-001
E	WV-061-005769-001	M	WV-061-005769-001
F	WV-061-005718-001	N	WV-061-005769-001
G	WV-061-005933-001	O	WV-061-004310-007
H	WV-061-004808-001	P	WV-061-005400-003
		Q	WV-061-004355-007

06/24/2022

FILE #: NEE14

DRAWING #: 2998

SCALE: N/A

DATE: MAY 24, 2022

OPERATOR'S WELL #: McCLELLAN 11H

API WELL #: 47 61 **01284 MD**  
STATE COUNTY PERMIT