


FILE #: NEE14
DRAWING #: 3075
SCALE: PLAT: 1" = 2200'
TICK MARK: 1" = 2000'
MINIMUM DEGREE OF ACCURACY: 1/200
PROVEN SOURCE OF ELEVATION: SUBMETER MAPPING GRADE GPS

I, THE UNDERSIGNED, HEREBY CERTIFY THAT THIS PLAT IS CORRECT TO THE BEST OF MY KNOWLEDGE AND BELIEF AND SHOWS ALL THE INFORMATION REQUIRED BY LAW AND THE REGULATIONS ISSUED AND PRESCRIBED BY THE DEPARTMENT OF ENVIRONMENTAL PROTECTION.
Signed: *[Signature]*
L.L.S. #2124 : Ernest J. Benchek III

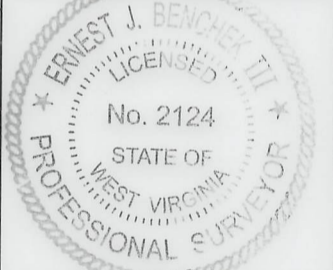

(+) DENOTES LOCATION OF WELL ON UNITED STATES TOPOGRAPHIC MAPS WYDEP
OFFICE OF OIL & GAS
601 57TH STREET
CHARLESTON, WV 25304
Well Type: Oil Waste Diposal Production Deep
 Gas Liquid Injection Storage Shallow
WATERSHED: DUNKARD CREEK
COUNTY/DISTRICT: MONONGALIA / CLAY
SURFACE OWNER: PATRICIA A. BUNNER
OIL & GAS ROYALTY OWNER: PATRICIA BUNNER, et al
LEASE NUMBERS:

DATE: JANUARY 10, 2024
OPERATOR'S WELL #: BUNNER 3H SIDE TRACK
API WELL #: 47 61 01907 WR-35
STATE COUNTY PERMIT
AS-BUILT
ELEVATION: 1277.25'
QUADRANGLE: BLACKSVILLE, WV
ACREAGE: 94.72 02/23/2024
ACREAGE: 986.8 +/-
DRILL CONVERT DRILL DEEPER REDRILL FRACTURE OR STIMULATE
PLUG OFF FORMATION PERFORATE NEW FORMATION PLUG & ABANDON
CLEAN OUT & REPLUG OTHER CHANGE (SPECIFY):
TARGET FORMATION: MARCELLUS
DRILLED DEPTH: SIDE TRACK TVD: 8,139' TMD: 26,076'
DESIGNATED AGENT: JOHN ADAMS
ADDRESS: 707 VIRGINIA STREET EAST, SUITE 1200
CITY: CHARLESTON STATE: WV ZIP CODE: 25301

PROPERTY OWNER INDEX	
4-9-38	ALLEN K & VIRGINIA L MOORE
4-9-43.6	THOMAS R LUZADER
4-18-32	PATRICIA A BUNNER
4-9-38.7	ALLEN K & VIRGINIA L MOORE
4-9-43.2	ROSE MARIE MOORE
4-9-43.5	CHISLER INC
4-17-2	ANGELA L CHISLER
4-17-3	ANGELA L CHISLER
4-17-4	DAYBROOK CHURCH OF CHRIST
4-9-38.4	CHARLES E & CONNIE L SNODGRASS
4-9-38.2	TERRY L & ANGELA M SHRIVER
4-9-41	JERRY W & GATHA TETER
4-9-41.1	LOIS JEAN MCCOY
4-9-41.2	LOIS JEAN MCCOY
4-9-40	CAROLYN SUE LUZADER-NEWHOUSE
4-8-2	KATHY LYNN SNYDER, ELIZABETH ANN REESE & JOHN M BUTCHER SR
4-8-3.1	RAYMOND L ALLEN
1-6-17	JACK LEMLEY; JAMES R LEMLEY; OLESTON SURVIVORS TRUST
4-8-4	L DOUGLAS & VICKI L TENNANT
1-8-5	KENNETH W & DONNA P EFAW
4-9-1.6	ERP FEDERAL MINING COMPLEX LLC
4-8-5.1	JANICE M STILES IRREVOCABLE TRUST
4-9-1.3	ORA D & MARY ANN TENNANT
4-9-3	JEFFREY TODD & CARLENE SUE MOORE ET AL
4-9-3.2	J TODD & CARLENE S MOORE
4-9-3.1	JEFFREY TODD & CARLENE MOORE ET AL
4-9-17	GARY D YOST
4-9-16	CHARLIE CHASE II & VICKI M CHASE
4-9-15	LOIS J MCCOY ET AL

LEASE INDEX			
A	WV-061-004154-001	N	WV-061-005864-001
B	WV-061-003731-000	O	WV-061-002693-003
C	WV-061-005711-001	P	WV-061-005813-001
D	WV-061-005711-001	Q	WV-061-000160-001-LA
E	WV-061-005884-003	R	WV-061-006022-001
F	WV-061-005208-008	S	WV-061-086005-001
G	WV-061-002667-023	T	WV-061-003670-037
H	WV-061-004985-001	U	WV-061-005991-001
I	WV-061-004984-001	V	WV-061-005823-001
J	WV-061-005209-001	W	WV-061-006004-001
K	WV-061-005864-001	X	WV-061-000160-001-LA
L	WV-061-005864-001	Y	WV-061-000160-001-LA
M	WV-061-005864-001	Z	WV-061-005863-002

02/23/2024

FILE #: <u>NEE14</u>	DATE: <u>JANUARY 10, 2024</u>
DRAWING #: <u>3075</u>	OPERATOR'S WELL #: <u>BUNNER 3H SIDE TRACK DRILLED</u>
SCALE: <u>N/A</u>	API WELL #: <u>47</u> <u>61</u> <u>01907 WR-35</u> STATE COUNTY PERMIT