


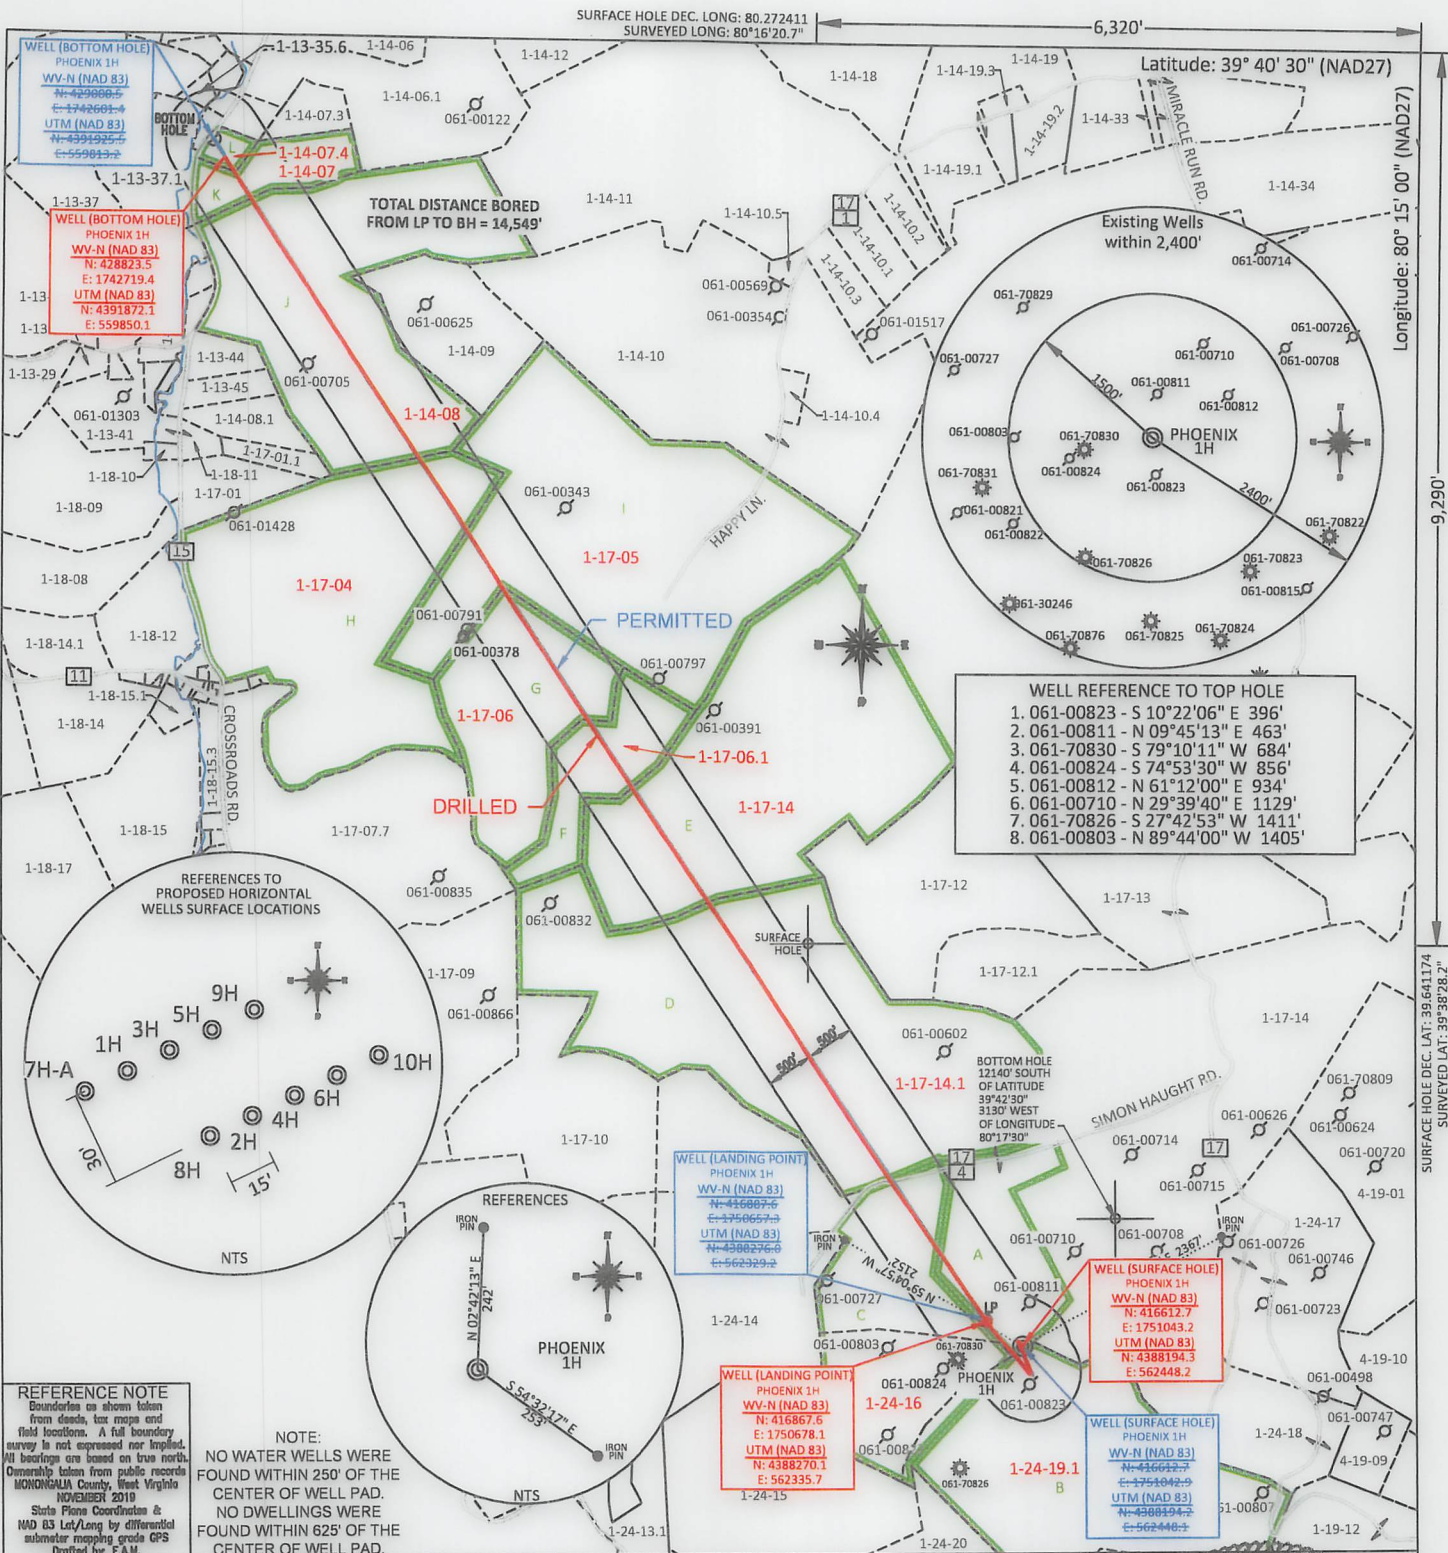

FILE #:	NNE16	PLAT IS CORRECT TO THE BEST OF MY KNOWLEDGE AND BELIEF AND SHOWS ALL THE INFORMATION REQUIRED BY LAW AND THE REGULATIONS ISSUED AND PRESCRIBED BY THE DEPARTMENT OF ENVIRONMENTAL PROTECTION. Signed: L.L.S. #2124 : Ernest J. Benchek III	
DRAWING #:	3029		
SCALE:	PLAT: 1" = 2000' TICK: 1" = 2000'		
MINIMUM DEGREE OF ACCURACY:	1/200		
PROVEN SOURCE OF ELEVATION:	SUBMETER MAPPING GRADE GPS		
(+) DENOTES LOCATION OF WELL ON UNITED STATES TOPOGRAPHIC MAPS WYDEP OFFICE OF OIL & GAS 601 57TH STREET CHARLESTON, WV 25304 Well Type: ☐ Oil ☐ Waste Diposal ☐ Production ☐ Deep ☒ Gas ☐ Liquid Injection ☐ Storage ☒ Shallow WATERSHED: DUNKARD CREEK COUNTY/DISTRICT: MONONGALIA / BATTELLE SURFACE OWNER: CHARLES WENDELL MOORE & FRANK M. CHISLER OIL & GAS ROYALTY OWNER: Pat L. Park, et al LEASE NUMBERS: DRILL ☒ CONVERT ☐ DRILL DEEPER ☐ REDRILL ☐ FRACTURE OR STIMULATE ☒ PLUG OFF FORMATION ☐ PERFORATE NEW FORMATION ☐ PLUG & ABANDON ☐ CLEAN OUT & REPLUG ☐ OTHER CHANGE ☐ (SPECIFY): TARGET FORMATION: MARCELLUS WELL OPERATOR: NORTHEAST NATURAL ENERGY LLC ADDRESS: 707 VIRGINIA STREET EAST, SUITE 1200 CITY: CHARLESTON STATE: WV ZIP CODE: 25301 DATE: APRIL 2, 2025 OPERATOR'S WELL #: PHOENIX 1H AS-DRILLED API WELL #: 47 61 01938 STATE COUNTY PERMIT AS-BUILT ELEVATION: 1,503.50' QUADRANGLE: WADESTOWN ACREAGE: 466.30 +/- ACREAGE: 1,369.00 06/06/2025 DRILLED DEPTH: TVD: 8,151' TMD: 23,008' DESIGNATED AGENT: JOHN ADAMS ADDRESS: 707 VIRGINIA STREET EAST, SUITE 1200 CITY: CHARLESTON STATE: WV ZIP CODE: 25301			

	PROPERTY OWNER INDEX
1-24-19.1	CHARLES WENDELL MOORE
1-24-16	ELIZABETH ANN WILSON & RANDY LEE DURR
1-17-14.1	FRANK M. CHISLER
1-17-14	PHOENIX ENERGY RESOURCES, LLC
1-17-06.1	SUSAN ANNE BURNESON
1-17-06	KENT A. & SHIRLEY A. LEONHARDT
1-17-05	KENT A. & SHIRLEY A. LEONHARDT
1-17-04	MARY M. LUNSFORD
1-14-08	KING FAMILY TRUST
1-14-07	DAVID W WOLFE JR & BRANDI SHAY WOLFE
1-14-07.4	DAVID W WOLFE JR & BRANDI SHAY WOLFE

	LEASE INDEX	
A	WV-061-004076-010	G WV-061-005790-003
B	WV-061-004463-001	H WV-061-004714-003
C	WV-061-004076-010	I WV-061-005790-003
D	WV-061-005787-001	J WV-061-004874-001
E	WV-061-004523-000	K WV-061-006053-001
F	WV-061-005790-003	L WV-061-006053-001

06/06/2025

FILE #: NEE14

DRAWING #: 3029

SCALE: N/A

DATE: APRIL 2, 2025

OPERATOR'S WELL #: PHOENIX 1H AS-DRILLED

API WELL #: 47 61 01938

STATE COUNTY PERMIT