


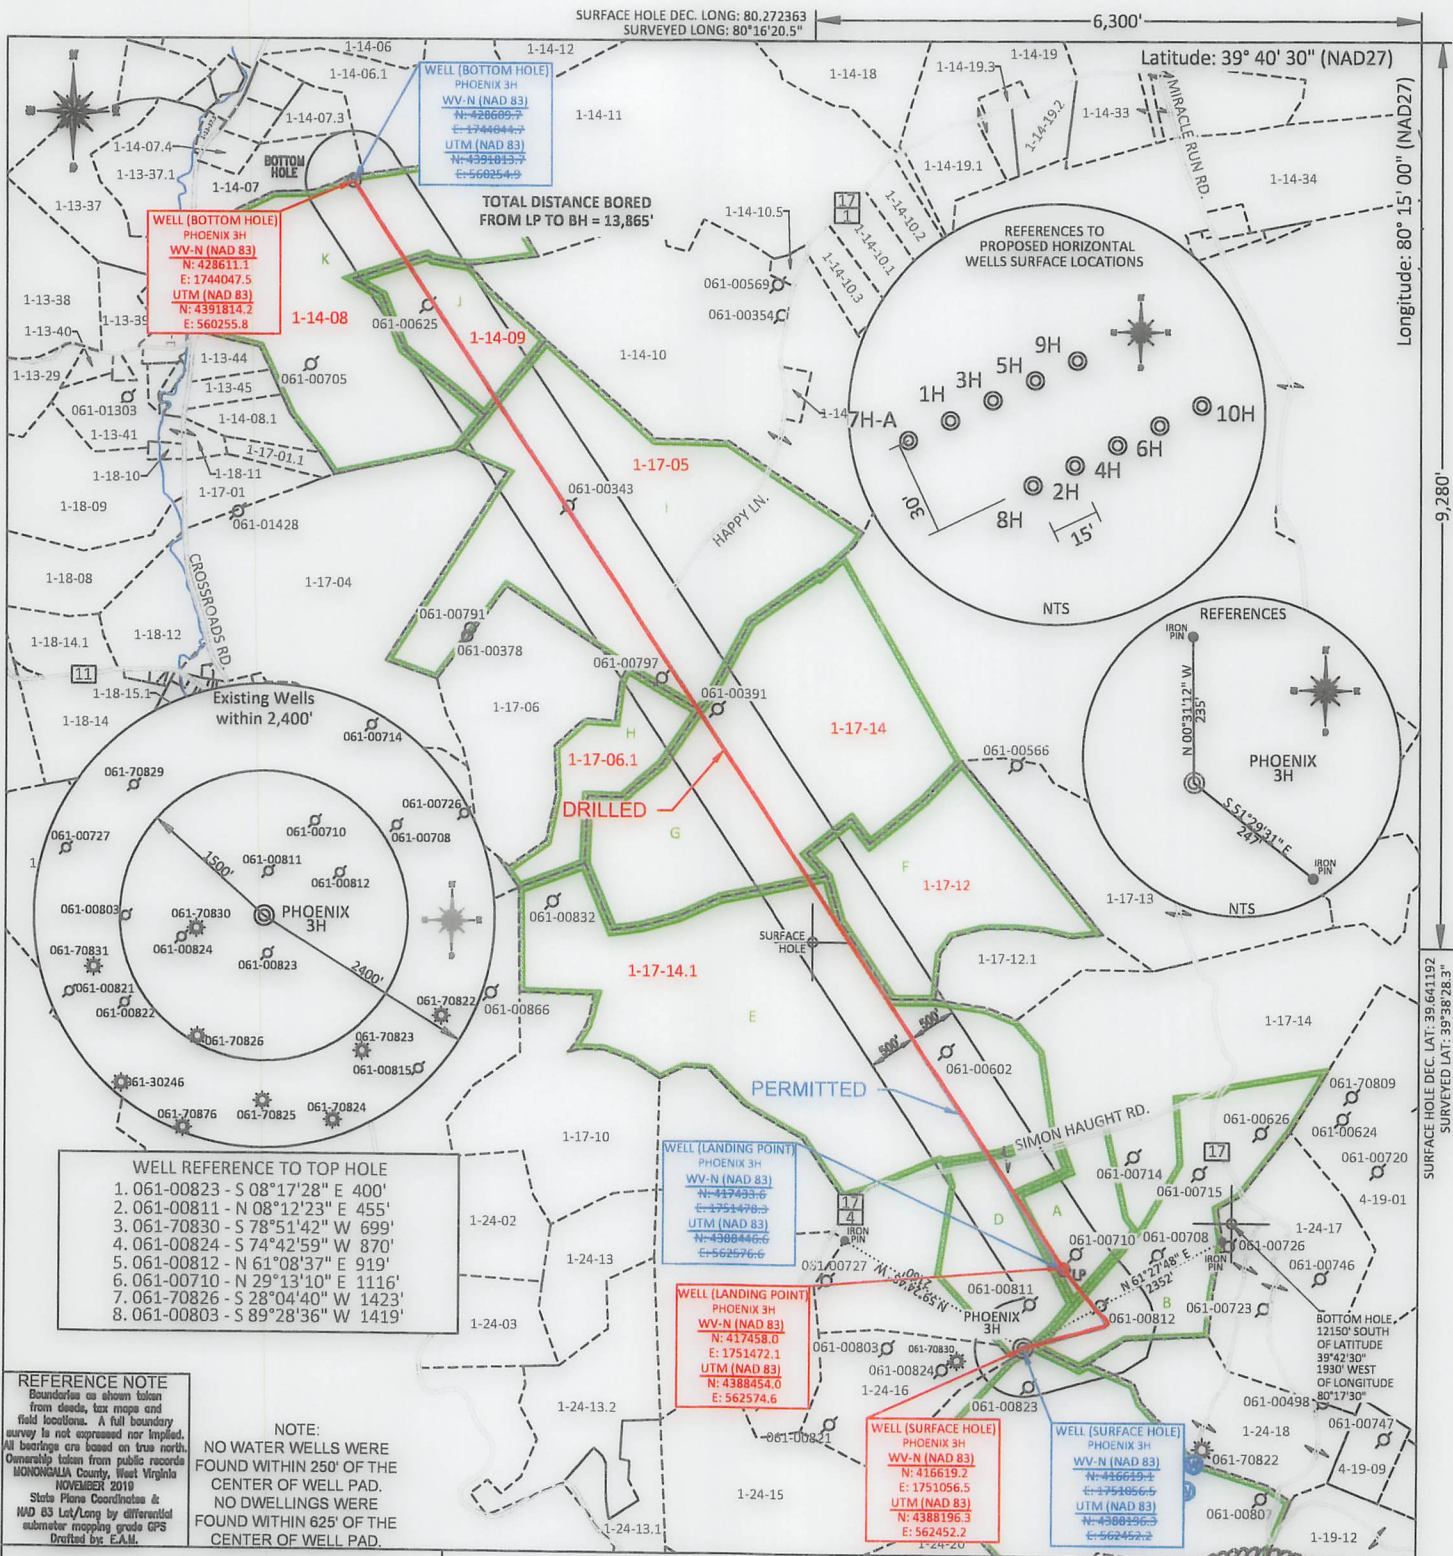

(+) DENOTES LOCATION OF WELL ON UNITED STATES TOPOGRAPHIC MAPS WVDEP

OFFICE OF OIL & GAS
601 57TH STREET
CHARLESTON, WV 25304

Well Type: ☐ Oil ☐ Waste Diposal ☐ Production ☐ Deep
☒ Gas ☐ Liquid Injection ☐ Storage ☒ Shallow

WATERSHED: DUNKARD CREEK

COUNTY/DISTRICT: MONONGALIA / BATTELLE

SURFACE OWNER: CHARLES WENDELL MOORE & FRANK M. CHISLER

OIL & GAS ROYALTY OWNER: Pat L. Park, et al

LEASE NUMBERS:

DRILL ☒ CONVERT ☐ DRILL DEEPER ☐ REDRILL ☐ FRACTURE OR STIMULATE ☒
PLUG OFF FORMATION ☐ PERFORATE NEW FORMATION ☐ PLUG & ABANDON ☐
CLEAN OUT & REPLUG ☐ OTHER CHANGE ☐ (SPECIFY):

TARGET FORMATION: MARCELLUS

WELL OPERATOR: NORTHEAST NATURAL ENERGY LLC

ADDRESS: 707 VIRGINIA STREET EAST, SUITE 1200

CITY: CHARLESTON STATE: WV ZIP CODE: 25301

DATE: APRIL 2, 2025

OPERATOR'S WELL #: PHOENIX 3H AS-DRILLED

API WELL #: 47 61 01939
STATE COUNTY PERMIT

AS-BUILT
ELEVATION: 1,503.50'

QUADRANGLE: WADESTOWN

ACREAGE: 466.30 +/-

ACREAGE: 1,244.968 +/-

05/30/2025

DRILLED DEPTH: TVD: 8,176' TMD: 22,136'

DESIGNATED AGENT: JOHN ADAMS

ADDRESS: 707 VIRGINIA STREET EAST, SUITE 1200

CITY: CHARLESTON STATE: WV ZIP CODE: 25301

	PROPERTY OWNER INDEX
1-14-07	DAVID W WOLFE JR & BRANDI SHAY WOLFE
1-14-08	KING FAMILY TRUST
1-14-09	KING FAMILY TRUST
1-17-14.1	FRANK M. CHISLER
1-17-14	PHOENIX ENERGY RESOURCES, LLC
1-17-06.1	SUSAN ANNE BURNESON
1-17-05	KENT A. & SHIRLEY A. LEONHARDT
1-17-12	PHOENIX ENERGY RESOURCES, LLC
1-24-19.1	CHARLES WENDELL MOORE

	LEASE INDEX		
A	WV-061-004093-050	G	WV-061-004523-000
B	WV-061-003767-004	H	WV-061-005790-003
C	WV-061-004463-001	I	WV-061-005790-003
D	WV-061-004076-010	J	WV-061-004639-011
E	WV-061-005787-001	K	WV-061-004874-001
F	WV-061-004290-001		

05/30/2025

FILE #: <u>NEE14</u> DRAWING #: <u>3030</u> SCALE: <u>N/A</u>	DATE: <u>APRIL 2, 2025</u> OPERATOR'S WELL #: <u>PHOENIX 3H AS-DRILLED</u> API WELL #: <u>47</u> <u>61</u> <u>01939</u> STATE COUNTY PERMIT
---	--