
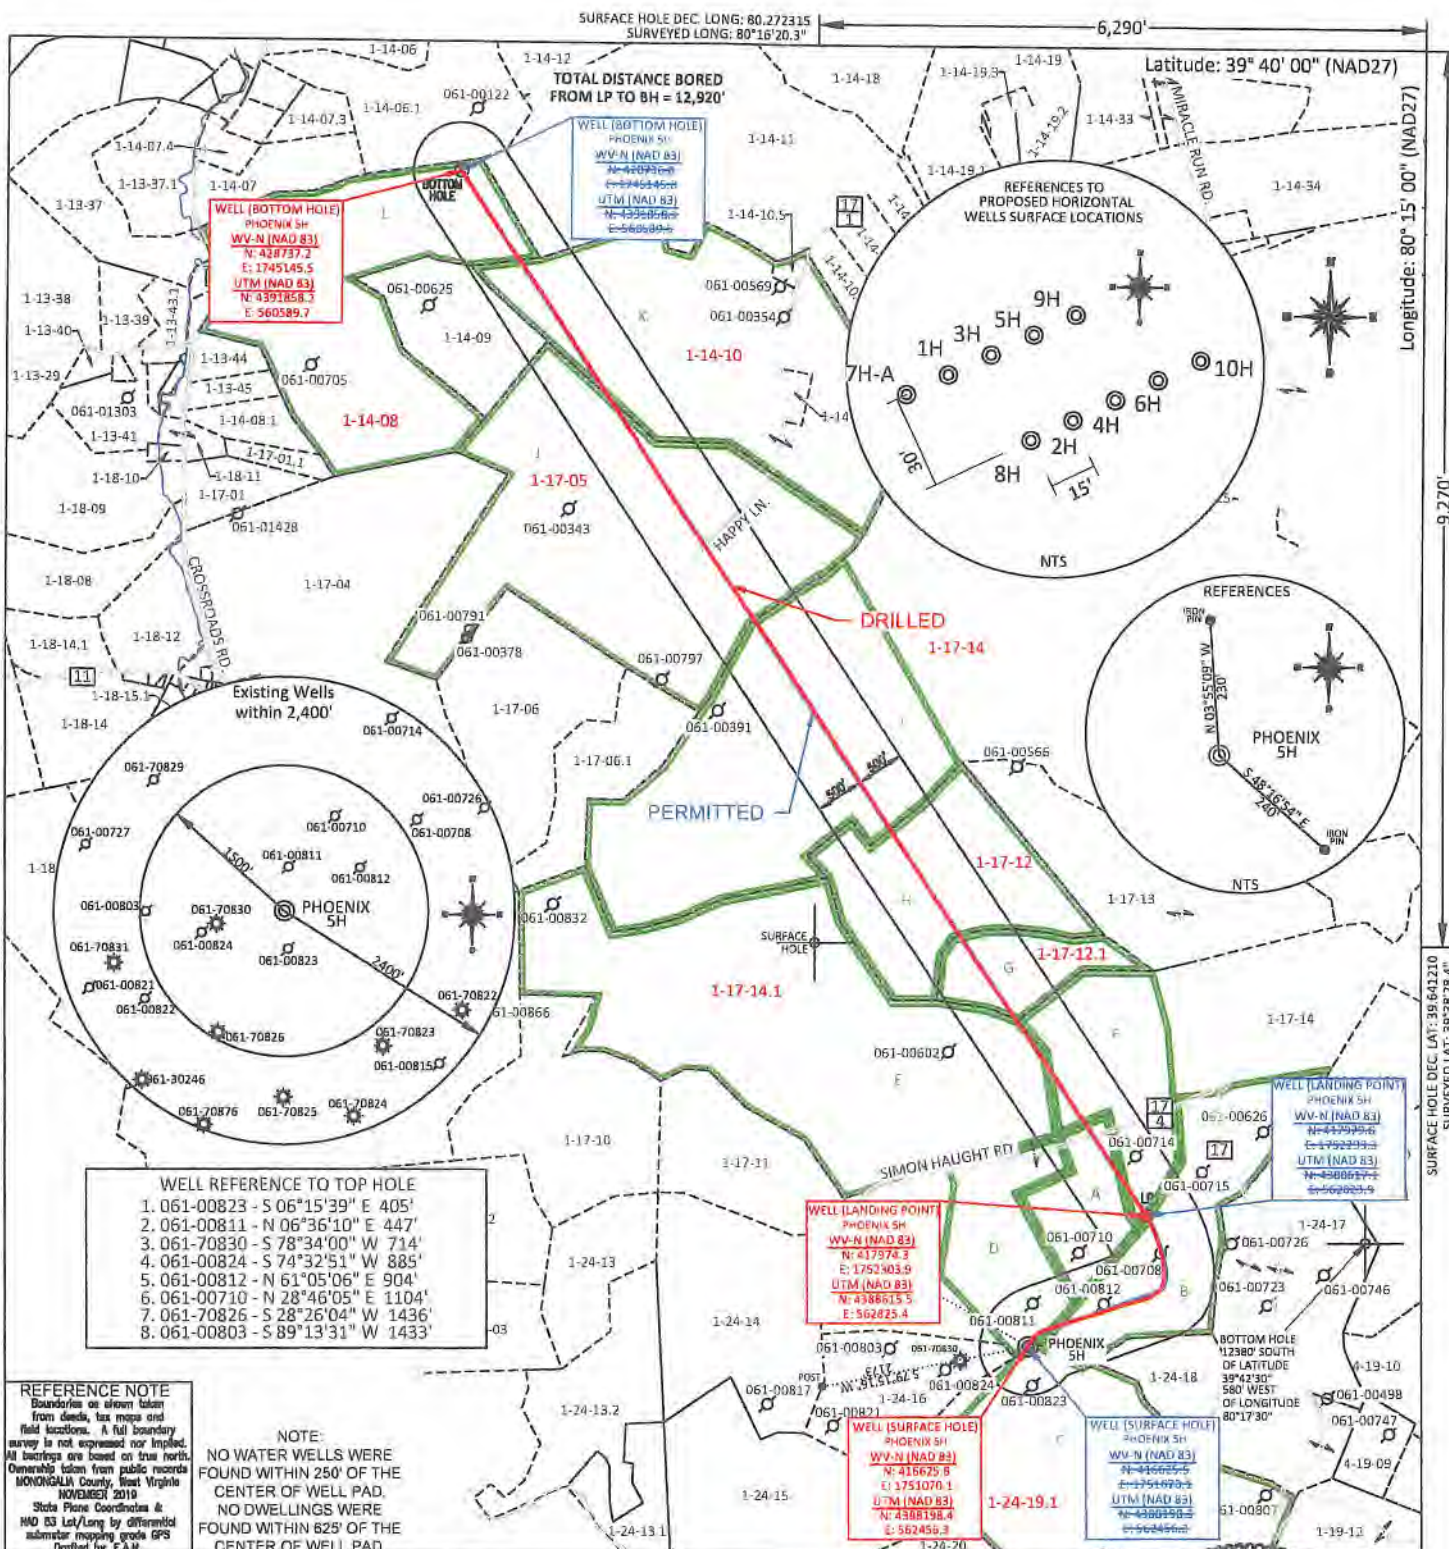


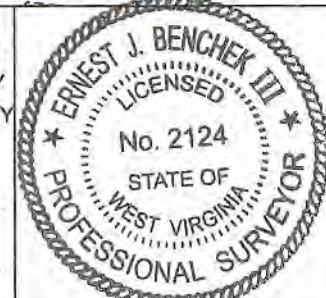

FILE #:	NNE16	PLAT IS CORRECT TO THE BEST OF MY KNOWLEDGE AND BELIEF AND SHOWS ALL THE INFORMATION REQUIRED BY LAW AND THE REGULATIONS ISSUED AND PRESCRIBED BY THE DEPARTMENT OF ENVIRONMENTAL PROTECTION. Signed:  L.L.S. #2124 : Ernest J. Benchek III	
DRAWING #:	3031		
SCALE:	PLAT: 1" = 2000' TICK: 1" = 2000'		
MINIMUM DEGREE OF ACCURACY:	1/200		
PROVEN SOURCE OF ELEVATION:	SUBMETER MAPPING GRADE GPS	DATE:	APRIL 2, 2025
OFFICE OF OIL & GAS 601 57TH STREET CHARLESTON, WV 25304		OPERATOR'S WELL #: PHOENIX 5H AS-DRILLED	
Well Type: ☐ Oil ☐ Waste Diposal ☐ Production ☐ Deep ☒ Gas ☐ Liquid Injection ☐ Storage ☒ Shallow		API WELL #: 47 61 01940 STATE COUNTY PERMIT	
WATERSHED: DUNKARD CREEK		AS-BUILT ELEVATION: 1,503.50'	
COUNTY/DISTRICT: MONONGALIA / BATTELLE		QUADRANGLE: WADESTOWN	
SURFACE OWNER: CHARLES WENDELL MOORE & FRANK M. CHISLER		ACREAGE: 466.30 +/-	
OIL & GAS ROYALTY OWNER: Pat L. Park, et al		ACREAGE: 1,474.772 +/-	
LEASE NUMBERS:		05/30/2025	
TARGET FORMATION: MARCELLUS		DRILL DEEPER ☐ REDRILL ☐ FRACTURE OR STIMULATE ☒	
WELL OPERATOR: NORTHEAST NATURAL ENERGY LLC		PLUG OFF FORMATION ☐ PERFORATE NEW FORMATION ☐ PLUG & ABANDON ☐	
ADDRESS: 707 VIRGINIA STREET EAST, SUITE 1200		CLEAN OUT & REPLUG ☐ OTHER CHANGE ☐ (SPECIFY):	
CITY: CHARLESTON STATE: WV ZIP CODE: 25301		TVD: 8,164' TMD: 21,858'	
		DESIGNATED AGENT: JOHN ADAMS	
		ADDRESS: 707 VIRGINIA STREET EAST, SUITE 1200	
		CITY: CHARLESTON STATE: WV ZIP CODE: 25301	

	PROPERTY OWNER INDEX
1-14-08	KING FAMILY TRUST
1-14-10	MICHAEL A & ANITA K BRAGG (LIFE-GEORGE H FOLEY)
1-17-05	KENT A. & SHIRLEY A. LEONHARDT
1-17-12	PHOENIX ENERGY RESOURCES, LLC
1-17-12.1	NANCY MOORE & CATHERINE ANN MOORE
1-17-14	PHOENIX ENERGY RESOURCES, LLC
1-17-14.1	FRANK M. CHISLER
1-24-19.1	CHARLES WENDELL MOORE

	LEASE INDEX		
A	WV-061-004079-002	G	WV-061-004281-002
B	WV-061-003767-004	H	WV-061-004290-001
C	WV-061-004463-001	I	WV-061-004937-006
D	WV-061-004076-010	J	WV-061-005790-003
E	WV-061-004433-001	K	WV-061-004505-001
F	WV-061-004433-001	L	WV-061-004874-001

05/30/2025

FILE #: NEE14

DRAWING #: 3031

SCALE: N/A

DATE: APRIL 2, 2025

OPERATOR’S WELL #: PHOENIX 5H AS-DRILLED

API WELL #: 47 61 01940

STATE COUNTY PERMIT