



PROPERTY OWNER INDEX	
1-14-10	MICHAEL A & ANITA K BRAGG (LIFE-GEORGE H FOLEY)
1-17-05	KENT A. & SHIRLEY A. LEONHARDT
1-17-12	ERP FEDERAL MINING COMPLEX LLC
1-17-12.1	NANCY MOORE & CATHERINE ANN MOORE
1-17-13	ERP FEDERAL MINING COMPLEX LLC
1-17-14	PHOENIX ENERGY RESOURCES, LLC
1-17-14.1	FRANK M. CHISLER
1-24-17	JOHN RAYMOND & JENNIFER L. HORNSBY MYERS
1-24-19.1	CHARLES WENDELL MOORE


LEASE INDEX			
A	WV-061-004079-002	I	WV-061-003767-004
B	WV-061-003767-004	J	WV-061-004937-006
C	WV-061-005687-001	K	WV-061-004595-003
D	WV-061-004463-001	L	WV-061-005790-003
E	WV-061-004076-010	M	WV-061-004505-001
F	WV-061-004433-001	N	WV-061-004326-018
G	WV-061-004281-002	O	WV-061-003767-004
H	WV-061-004290-001		

05/30/2025

FILE #: NEE14	DATE: APRIL 2, 2025
DRAWING #: 3033	OPERATOR'S WELL #: PHOENIX 9H AS-DRILLED
SCALE: N/A	API WELL #: 47 61 01942 STATE COUNTY PERMIT

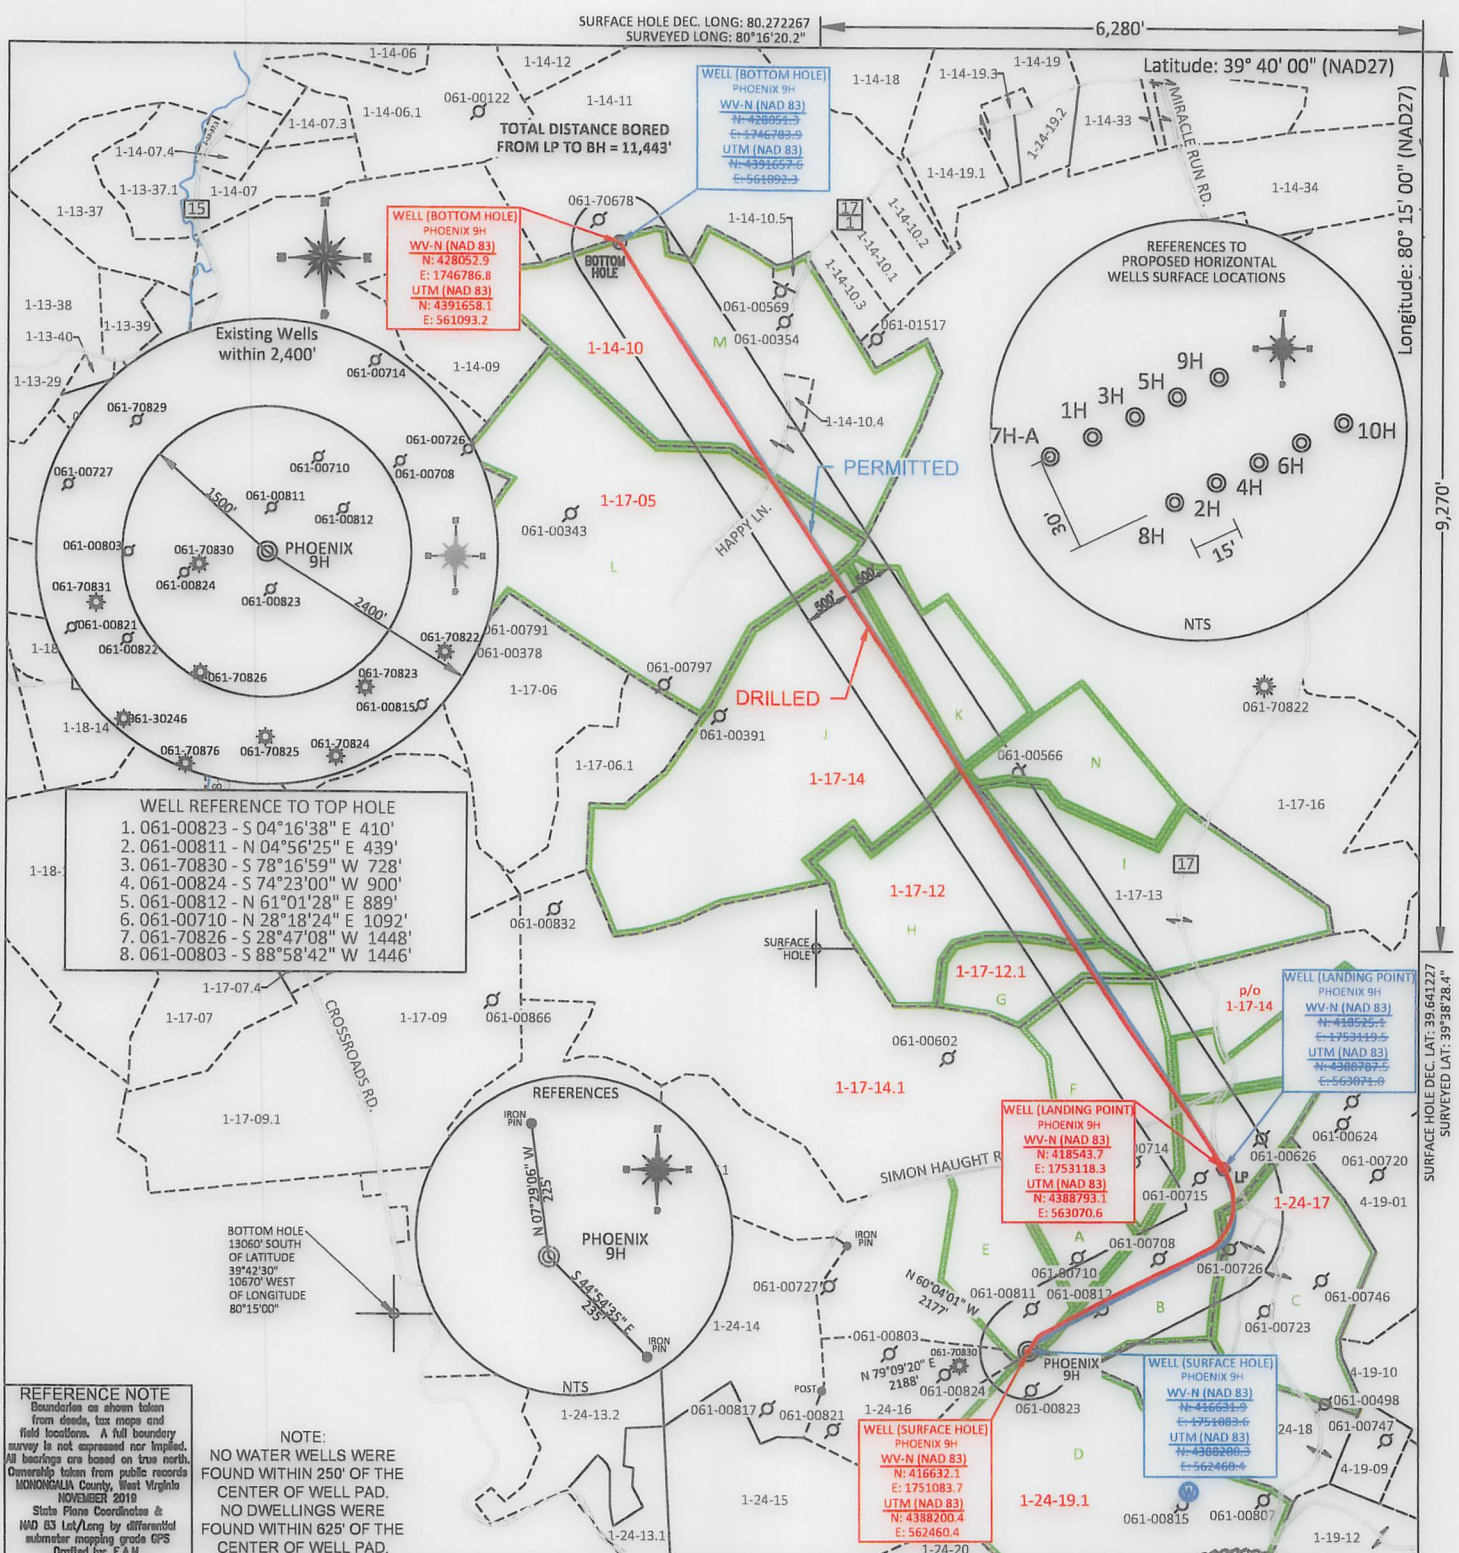

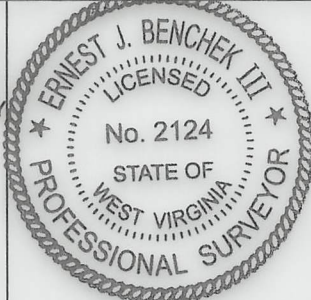FILE #: <u>NNE16</u> DRAWING #: <u>3033</u> SCALE: <u>PLAT: 1" = 2000'</u> <u>TICK: 1" = 2000'</u> MINIMUM DEGREE OF ACCURACY: <u>1/200</u> PROVEN SOURCE SUBMETER MAPPING OF ELEVATION: GRADE GPS	PLAT IS CORRECT TO THE BEST OF MY KNOWLEDGE AND BELIEF AND SHOWS ALL THE INFORMATION REQUIRED BY LAW AND THE REGULATIONS ISSUED AND PRESCRIBED BY THE DEPARTMENT OF ENVIRONMENTAL PROTECTION. Signed: _____ L.L.S. #2124 : <u>Ernest J. Benchek III</u>	
(+) DENOTES LOCATION OF WELL ON UNITED STATES TOPOGRAPHIC MAPS WVDEP OFFICE OF OIL & GAS 601 57TH STREET CHARLESTON, WV 25304 Well Type: ☐ Oil ☐ Waste Diposal ☐ Production ☐ Deep ☒ Gas ☐ Liquid Injection ☐ Storage ☒ Shallow WATERSHED: <u>DUNKARD CREEK</u> COUNTY/DISTRICT: <u>MONONGALIA / BATTELLE</u> SURFACE OWNER: <u>CHARLES WENDELL MOORE & FRANK M. CHISLER</u> OIL & GAS ROYALTY OWNER: <u>Pat L. Park, et al</u> LEASE NUMBERS: _____ DATE: <u>APRIL 2, 2025</u> OPERATOR'S WELL #: <u>PHOENIX 9H AS-DRILLED</u> API WELL #: <u>47</u> <u>61</u> <u>01942</u> STATE COUNTY PERMIT AS-BUILT ELEVATION: <u>1,503.50'</u> QUADRANGLE: <u>WADESTOWN</u> ACREAGE: <u>466.30 +/-</u> ACREAGE: <u>1,336.618 +/-</u> DRILL ☒ CONVERT ☐ DRILL DEEPER ☐ REDRILL ☐ FRACTURE OR STIMULATE ☒ PLUG OFF FORMATION ☐ PERFORATE NEW FORMATION ☐ PLUG & ABANDON ☐ CLEAN OUT & REPLUG ☐ OTHER CHANGE ☐ (SPECIFY): _____ TARGET FORMATION: <u>MARCELLUS</u> WELL OPERATOR: <u>NORTHEAST NATURAL ENERGY LLC</u> ADDRESS: <u>707 VIRGINIA STREET EAST, SUITE 1200</u> CITY: <u>CHARLESTON</u> STATE: <u>WV</u> ZIP CODE: <u>25301</u> DRILLED DEPTH: <u>TVD: 8,183' TMD: 20,733'</u> DESIGNATED AGENT: <u>JOHN ADAMS</u> ADDRESS: <u>707 VIRGINIA STREET EAST, SUITE 1200</u> CITY: <u>CHARLESTON</u> STATE: <u>WV</u> ZIP CODE: <u>25301</u>		

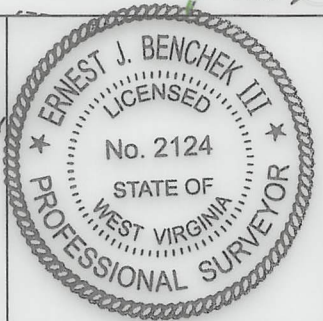

05/30/2025

CITY: CHARLESTON STATE: WV ZIP CODE: 25301
WELL OPERATOR: NORTHEAST NATURAL ENERGY LLC
ADDRESS: 707 VIRGINIA STREET EAST, SUITE 1500
SURFACE OWNER: CHARLES WENDELL MOORE & FRANK W. CHISLER
OIL & GAS ROYALTY OWNER: Pat L. Park et al
LEASE NUMBERS:
WATERSHED: DUNKARD CREEK
COUNTY/DISTRICT: MONONGALIA / BATTLE
ACREAGE: 1,336.618+/-
ACREAGE: 466.30 +/-
QUADRANGLE: WADSWORTH
ELEVATION: 1,503.20'
AS-BUILT
API WELL #: 47 STATE COUNTY PERMIT 01945
OPERATOR'S WELL #: PHOENIX 3H A2-DRILLED
DATE: APRIL 5, 2025
TARGET FORMATION: MARCELLUS
CLEAN OUT & REPLUG ☐ OTHER CHANGE ☐ (SPECIFY):
PLUG OFF FORMATION ☐ PERFORATE NEW FORMATION ☐ PLUG & ABANDON ☐
DRILL DEEPER ☐ REDRILL ☐ FRACTURE OR STIMULATE ☒
CITY: CHARLESTON STATE: WV ZIP CODE: 25301

FILE #: INE16
DRAWING #: 3033
SCALE: PLT: 1" = 3000', TBC: 1" = 3000'
OF ACCURACY: 1/500
MINIMUM DEGREE
PROVEN SOURCE SUBMITTER MAPPING
OF ELEVATION: GRADE GPS

L.S. #2124 : Ernest J. Benchek III
Signed:
THE DEPARTMENT OF ENVIRONMENTAL PROTECTION.
LAW AND THE REGULATIONS ISSUED AND PRESCRIBED BY
BELIEF AND SHOWS ALL THE INFORMATION REQUIRED BY
PLAT IS CORRECT TO THE BEST OF MY KNOWLEDGE AND

