


RECEIVED
Office Of Oil and Gas


JUL 31 2025

WV Department of
Environmental Protection

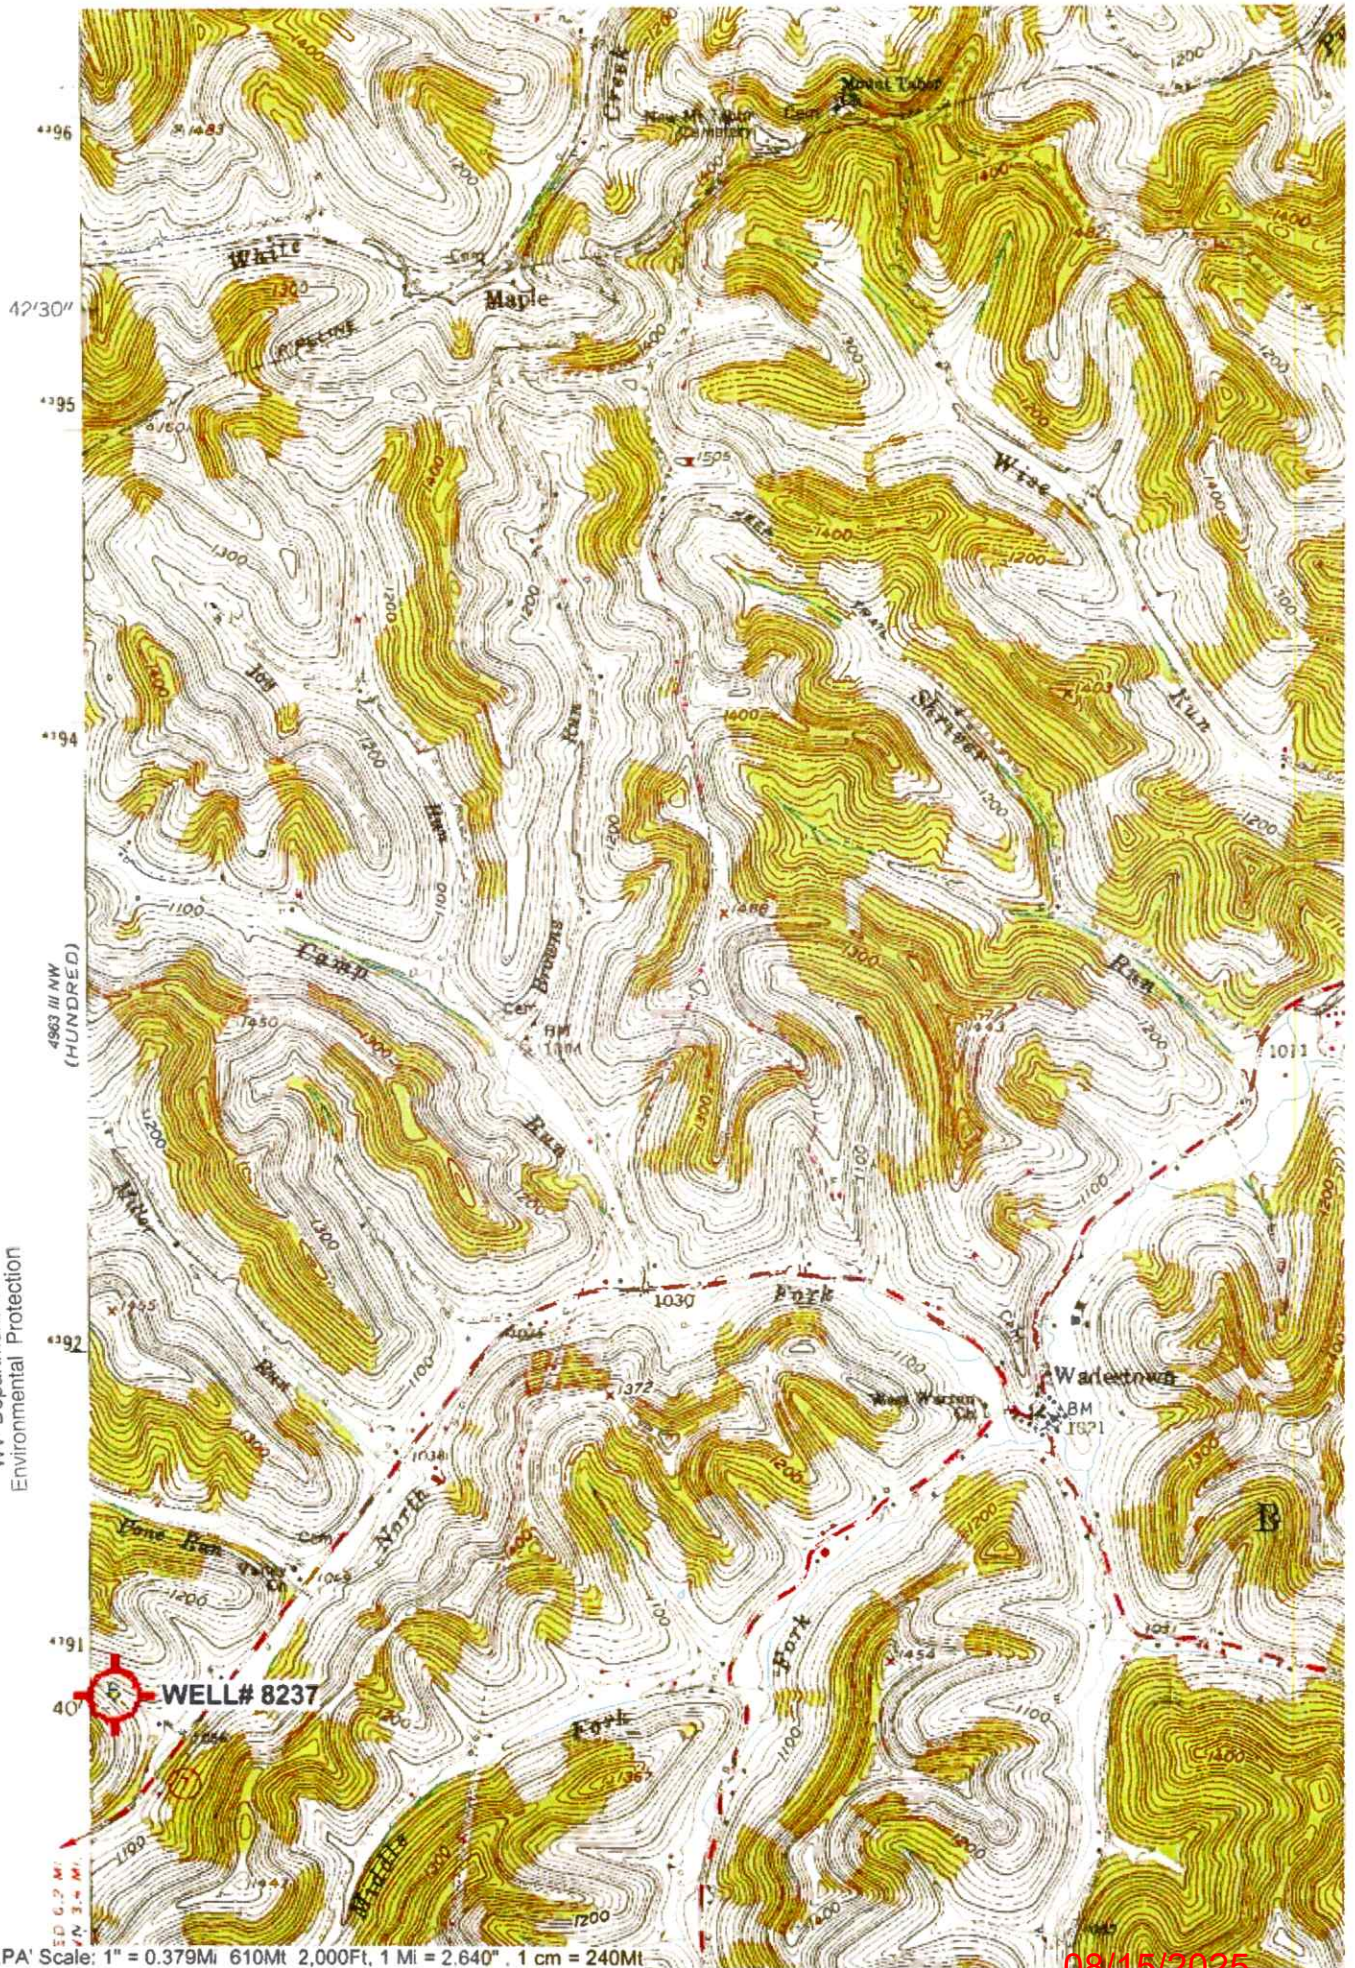

'Wadestown; WV,PA' Scale: 1" = 0.379Mi 610Mt 2,000Ft, 1 Mi = 2,640" . 1 cm = 240Mt

08/15/2025

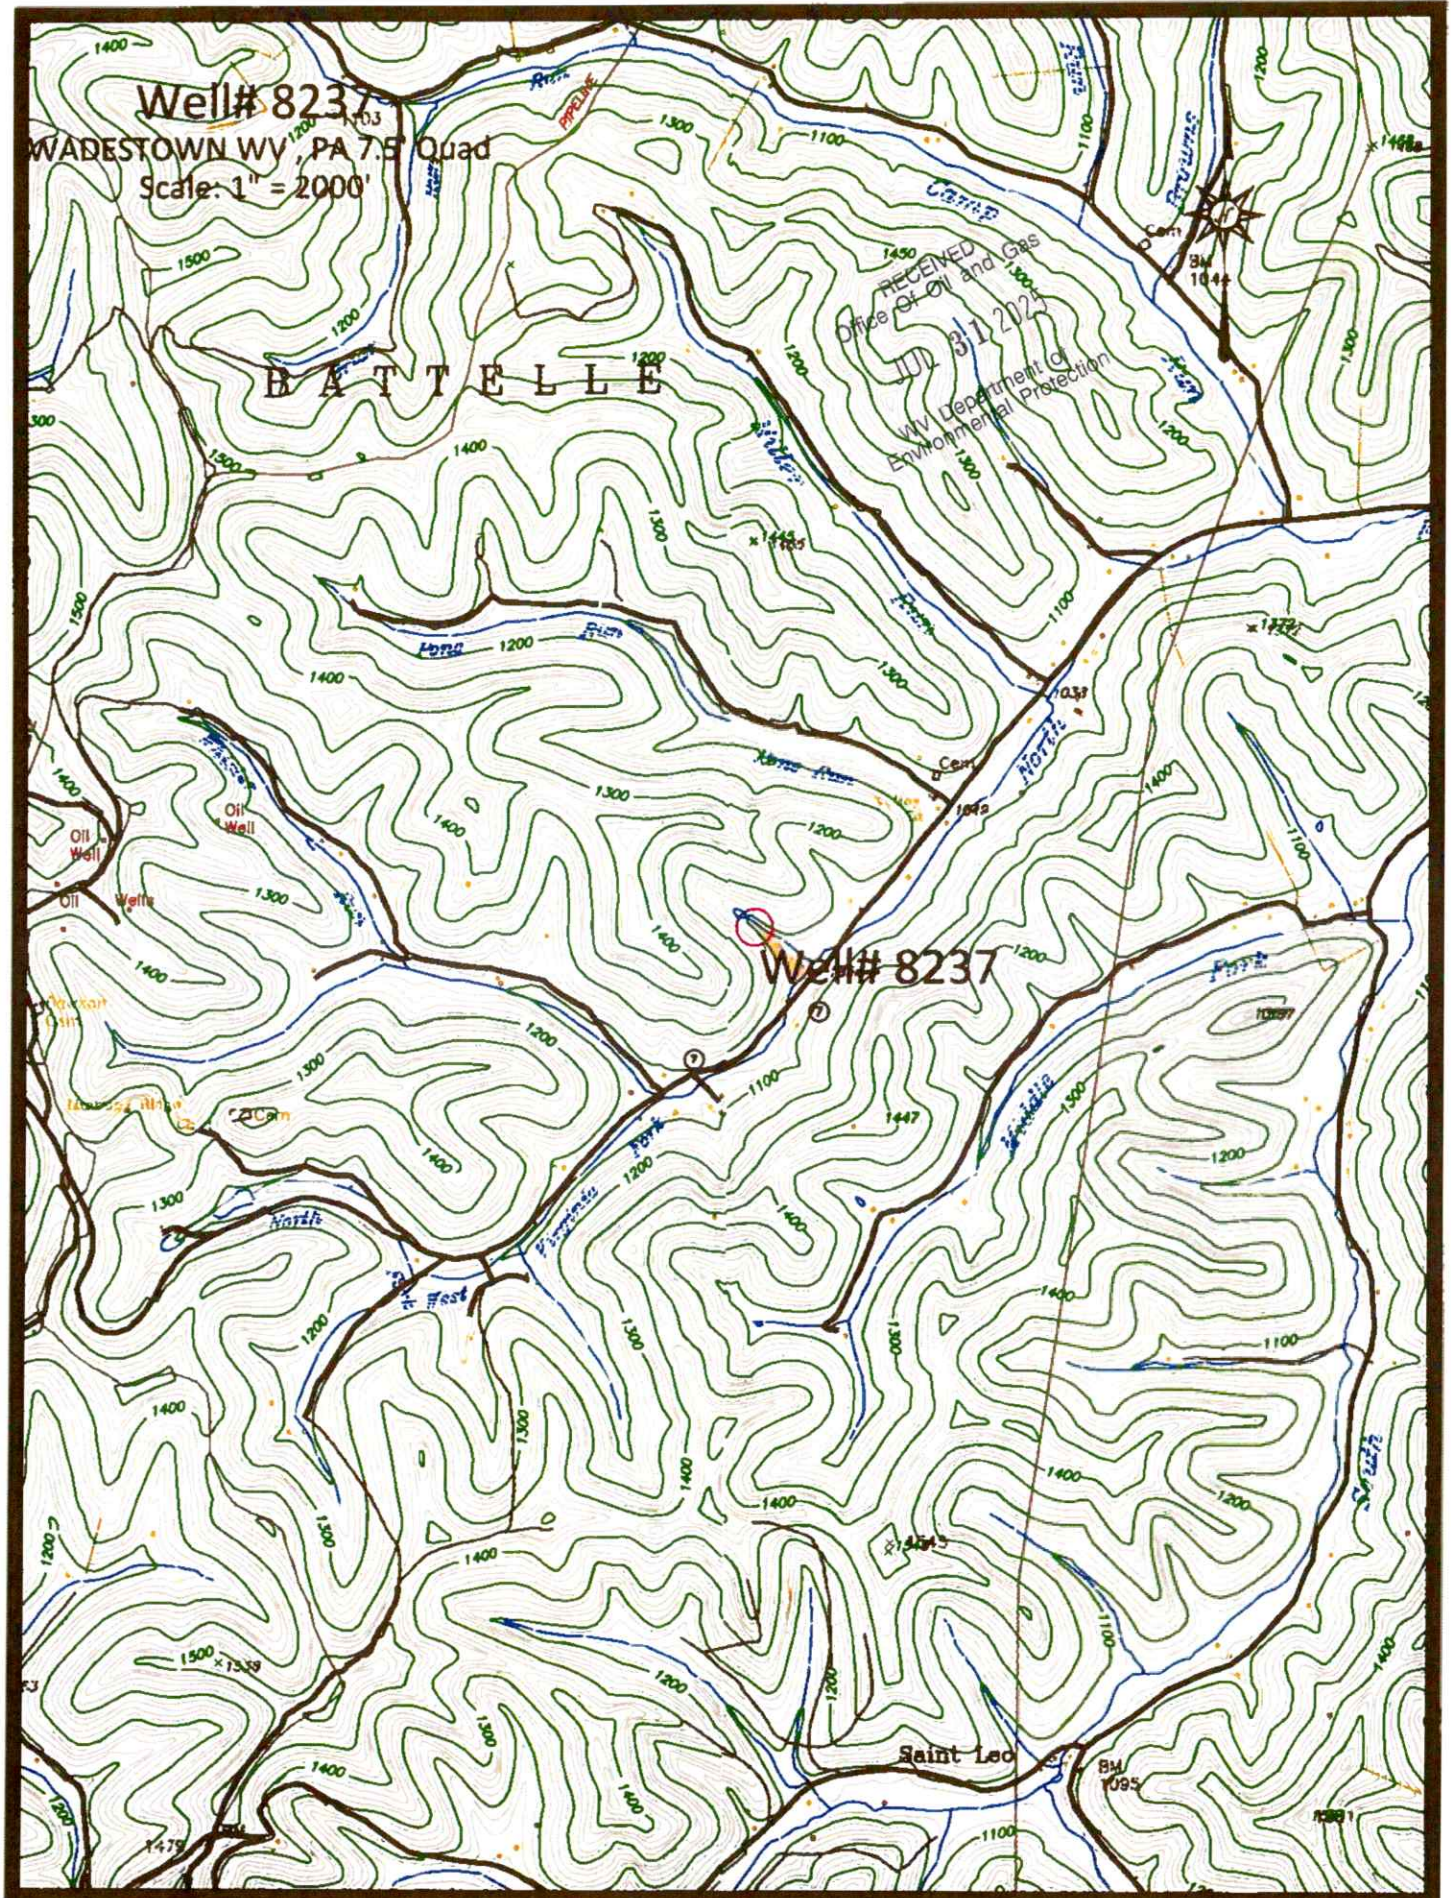

08/15/2025

4706102014

Well# 8237

WADESTOWN WV, PA 7.5' Quad

Scale: 1" = 500'

Rone Run

Valley Ch

RECEIVED
Office of Oil and Gas
JUL 31 2025
WV Department of
Environmental Protection

Well# 8237

1056

7

7

1100


1447

Fork

Access Road

08/15/2025

4706102014

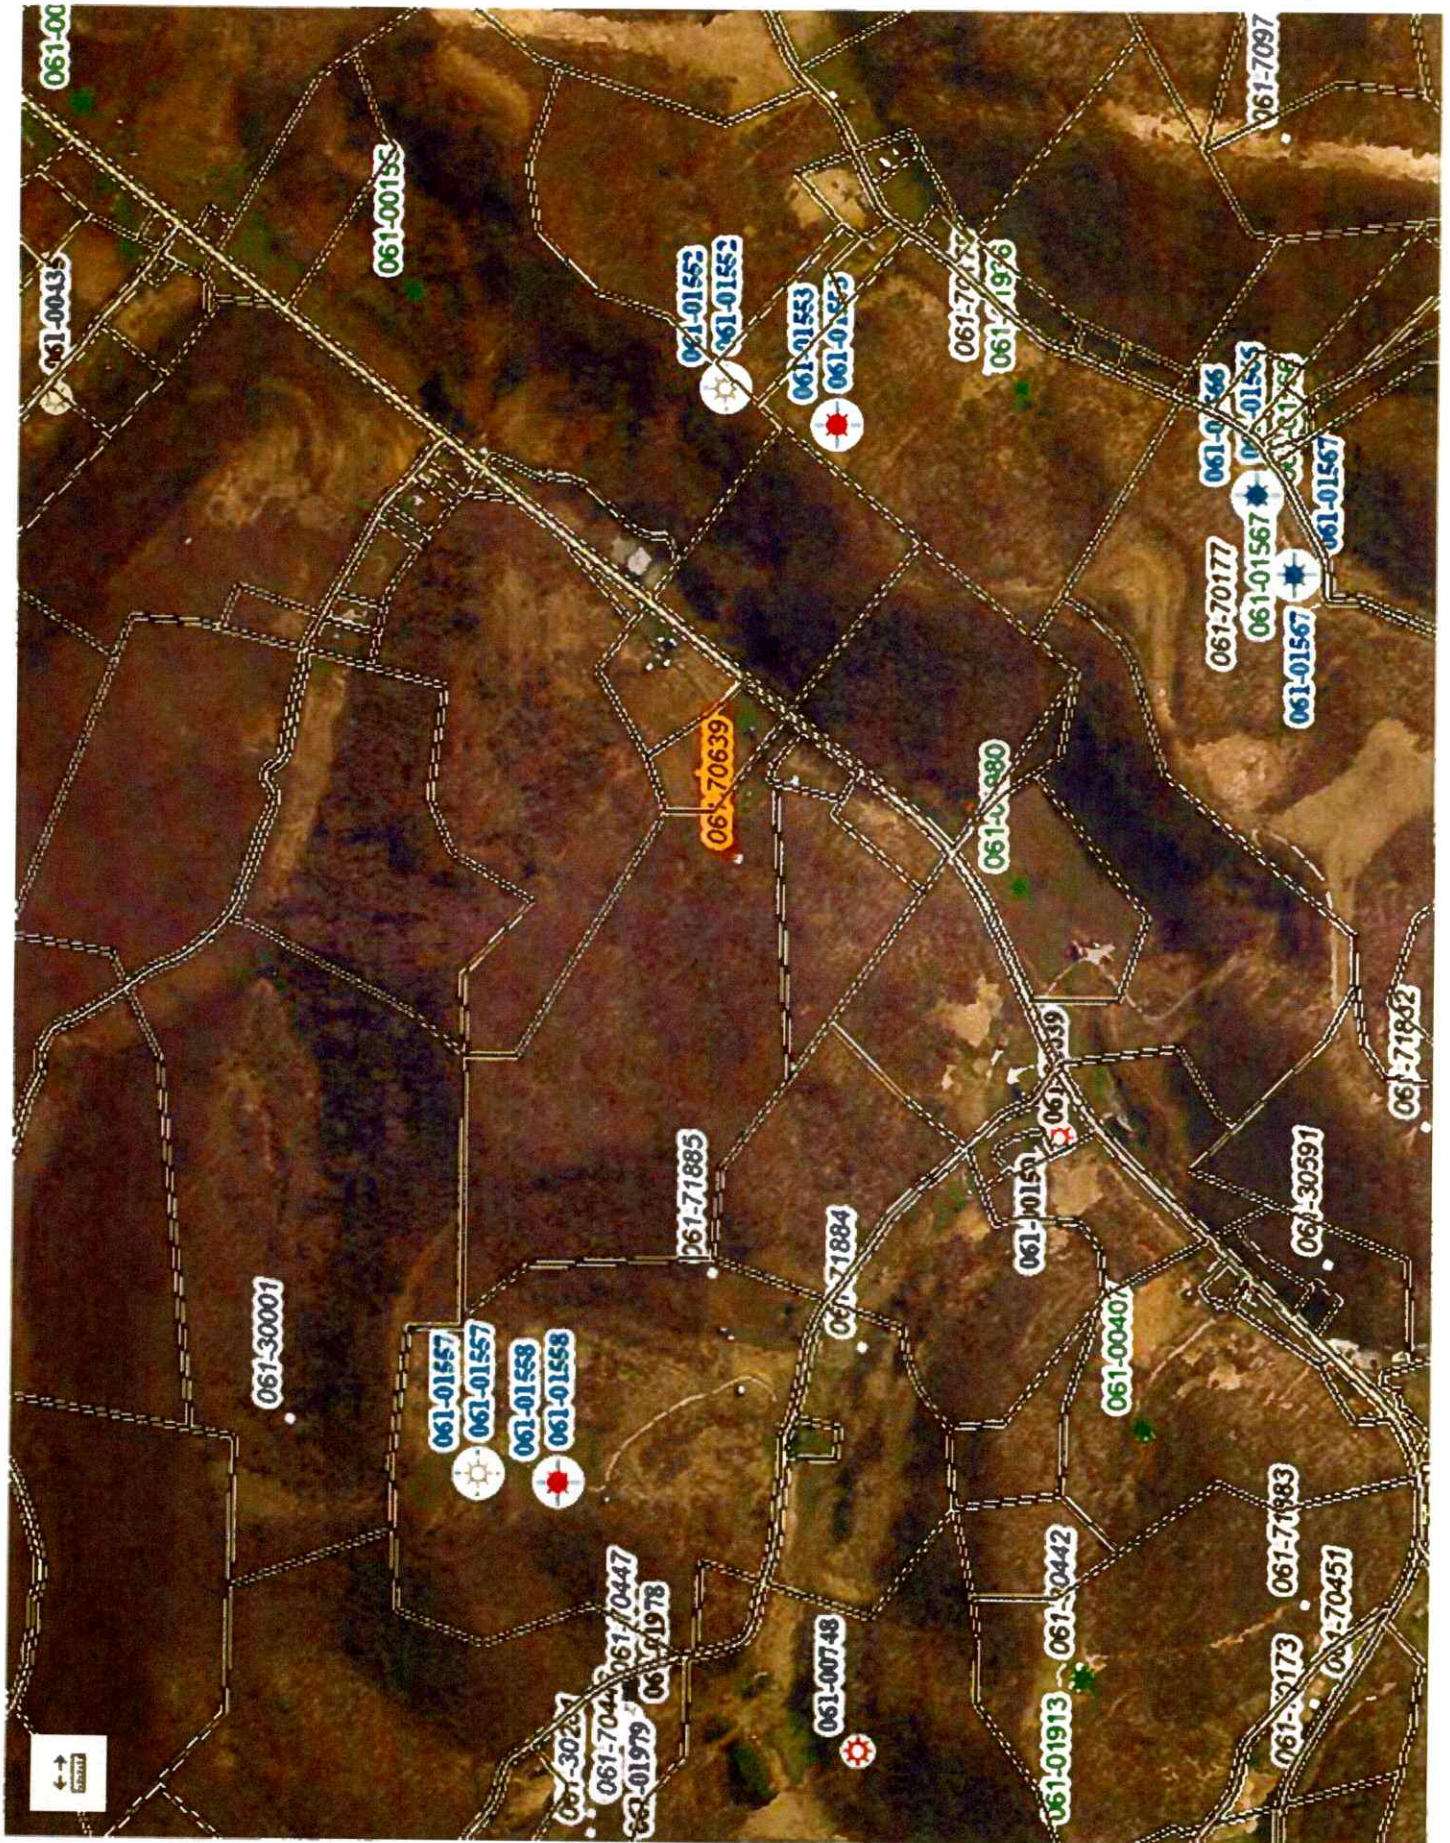

08/15/2025

WW-7
8-30-06



RECEIVED
Office of Oil and Gas
4706102014
JUL 31 2025
WV Department of
Environmental Protection

West Virginia Department of Environmental Protection
Office of Oil and Gas

WELL LOCATION FORM: GPS

API: 47-061-70639 WELL NO.: 8237
FARM NAME: URIAH SHRIVER
RESPONSIBLE PARTY NAME: WEST VIRGINIA LAND RESOURCES INC.
COUNTY: MONONGALIA DISTRICT: BATTELLE
QUADRANGLE: WADESTOWN W.VA, PA
SURFACE OWNER: SHEILA K. & JERRY L. TENNANT
ROYALTY OWNER: _____
UTM GPS NORTHING: 4,390,999 m
UTM GPS EASTING: 553,708 m GPS ELEVATION: 337 m

The Responsible Party named above has chosen to submit GPS coordinates in lieu of preparing a new well location plat for a plugging permit or assigned API number on the above well. The Office of Oil and Gas will not accept GPS coordinates that do not meet the following requirements:

1. Datum: NAD 1983, Zone: 17 North, Coordinate Units: meters, Altitude: height above mean sea level (MSL) meters.
2. Accuracy to Datum - 3.05 meters
3. Data Collection Method:

Survey grade GPS ☒ : Post Processed Differential _____

Real-Time Differential ☒

Mapping Grade GPS _____ : Post Processed Differential

Real-Time Differential

4. Letter size copy of the topography map showing the well location.

I the undersigned, hereby certify this data is correct to the best of my knowledge and belief and shows all the information required by law and the regulations issued and prescribed by the Office of Oil and Gas.

Signature

Title

JULY 18, 2025

Date

08/15/2025