



WELL NAME: SULLIVAN 2H
Catherine's
MONONGALIA Co., WV / GRANT TOWN QUAD

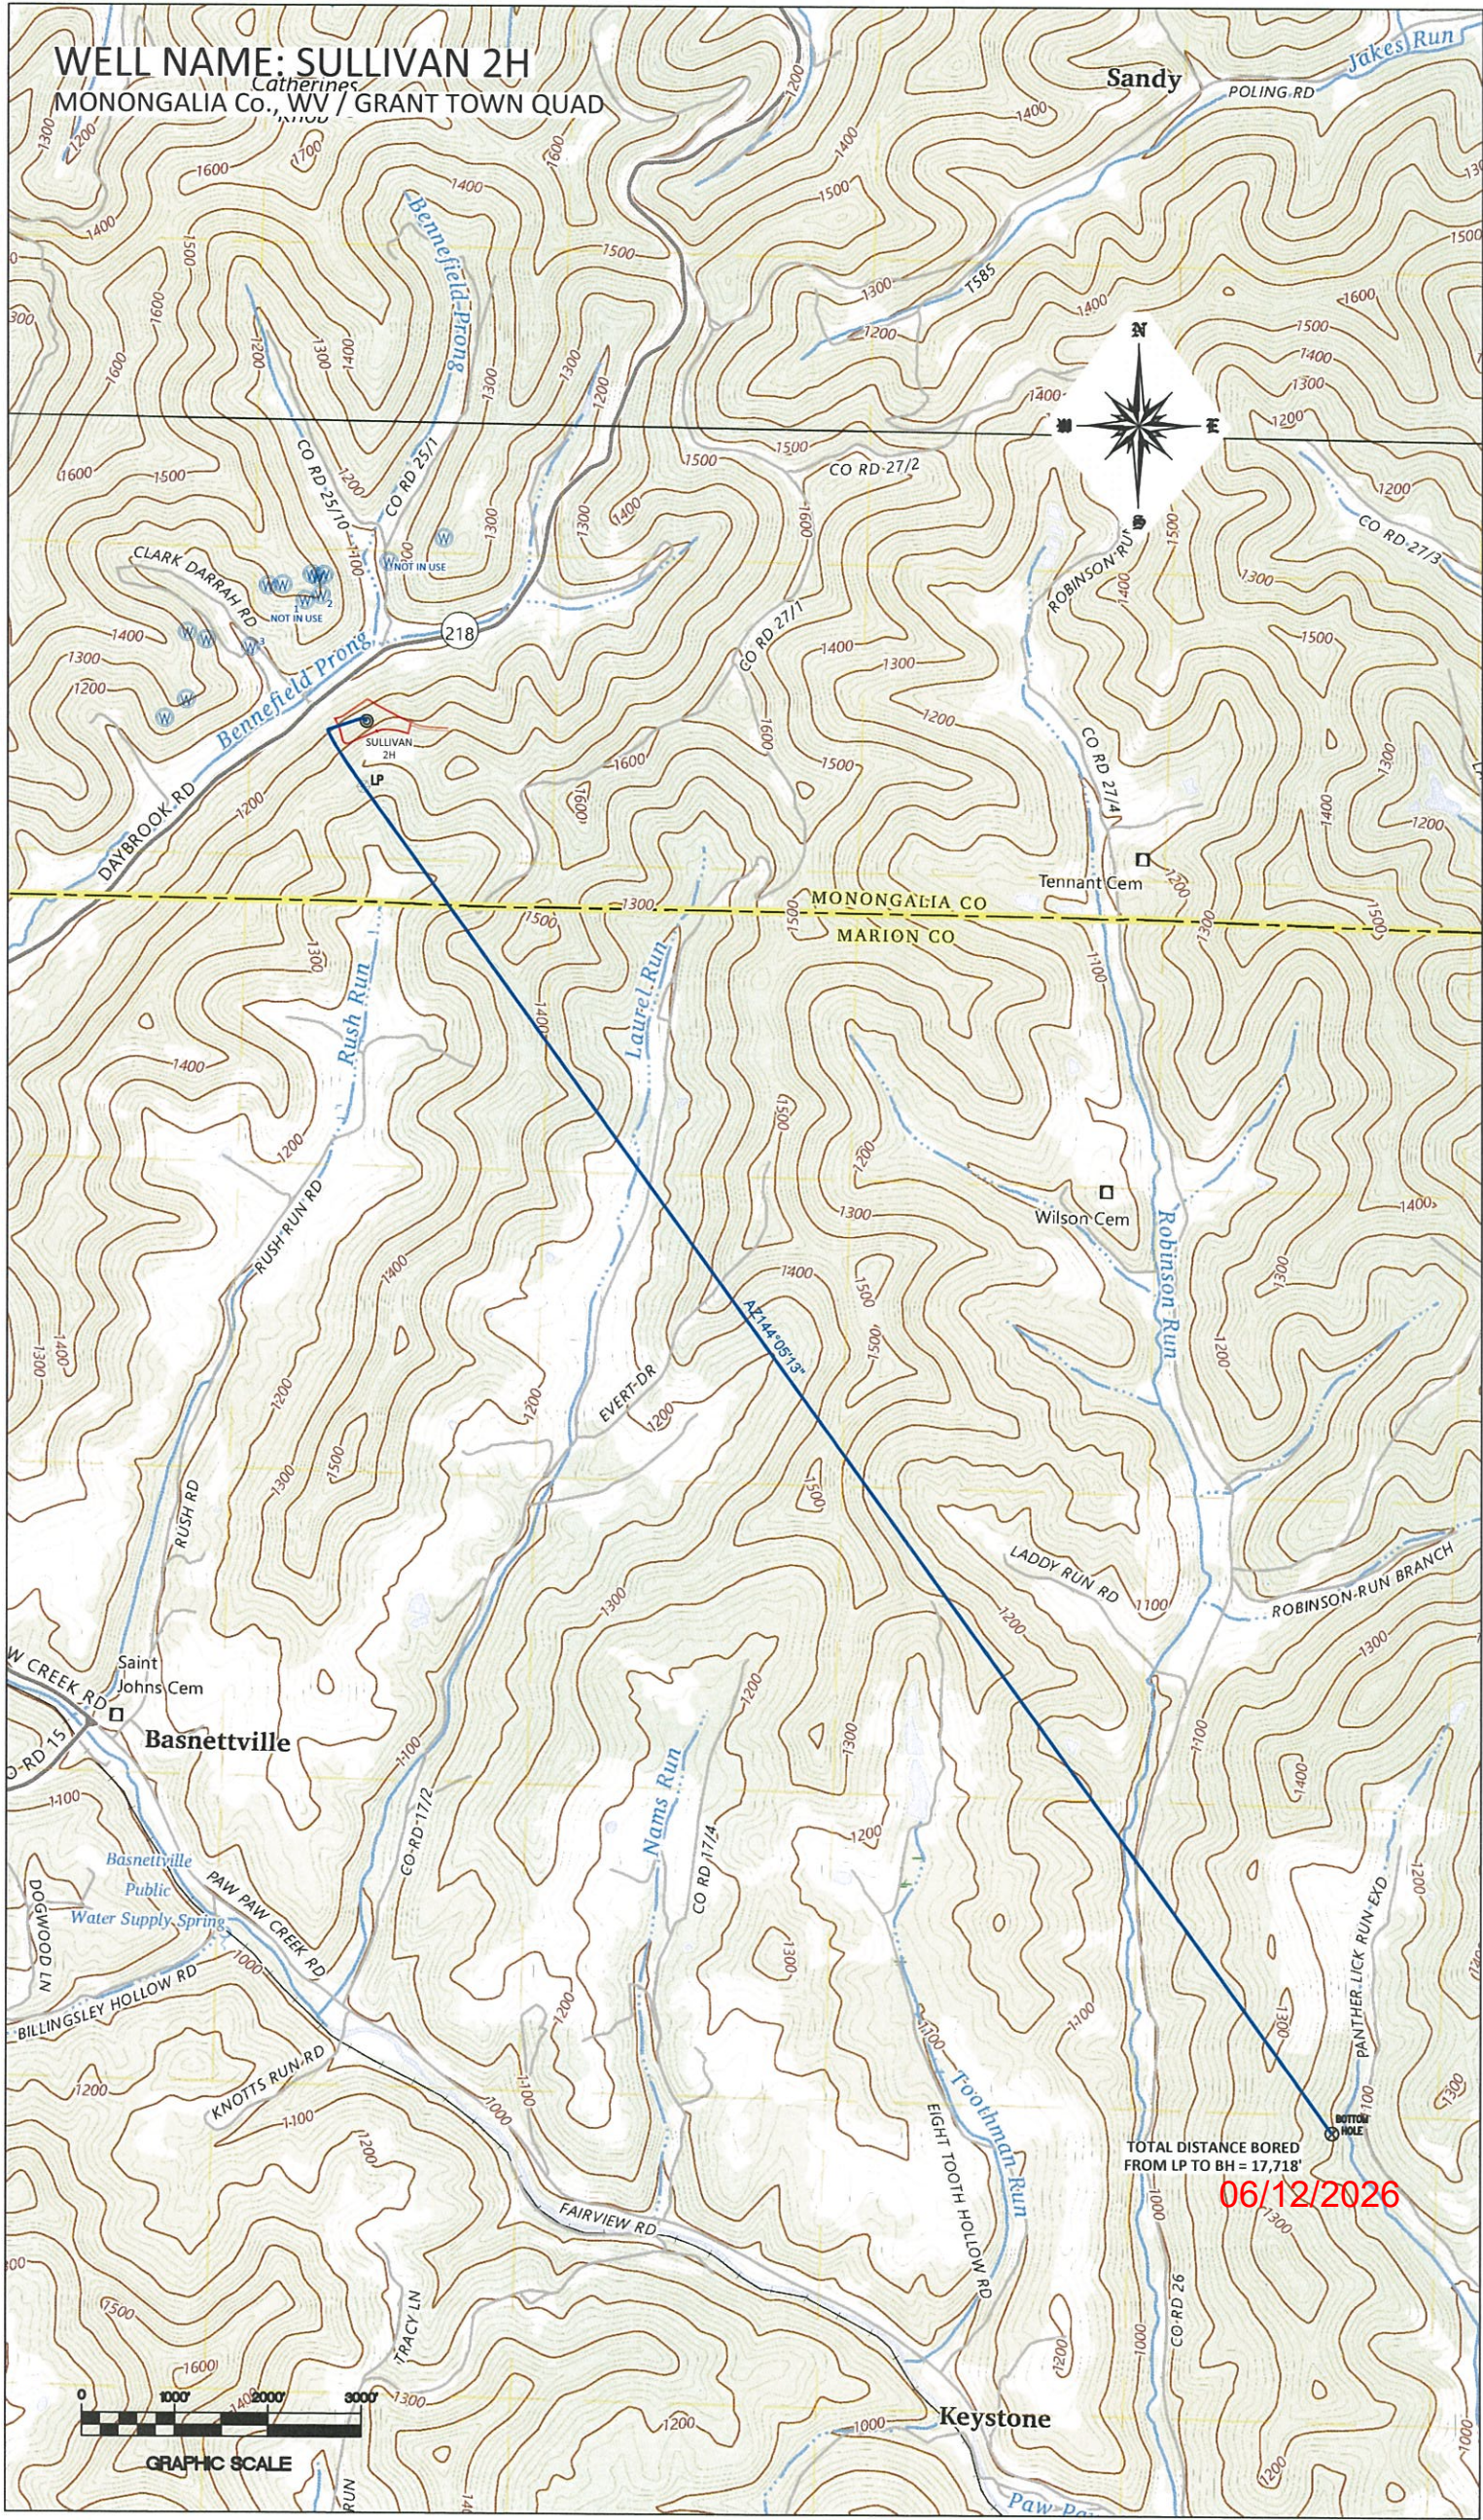

TOTAL DISTANCE BORED
FROM LP TO BH = 17,718'

06/12/2026

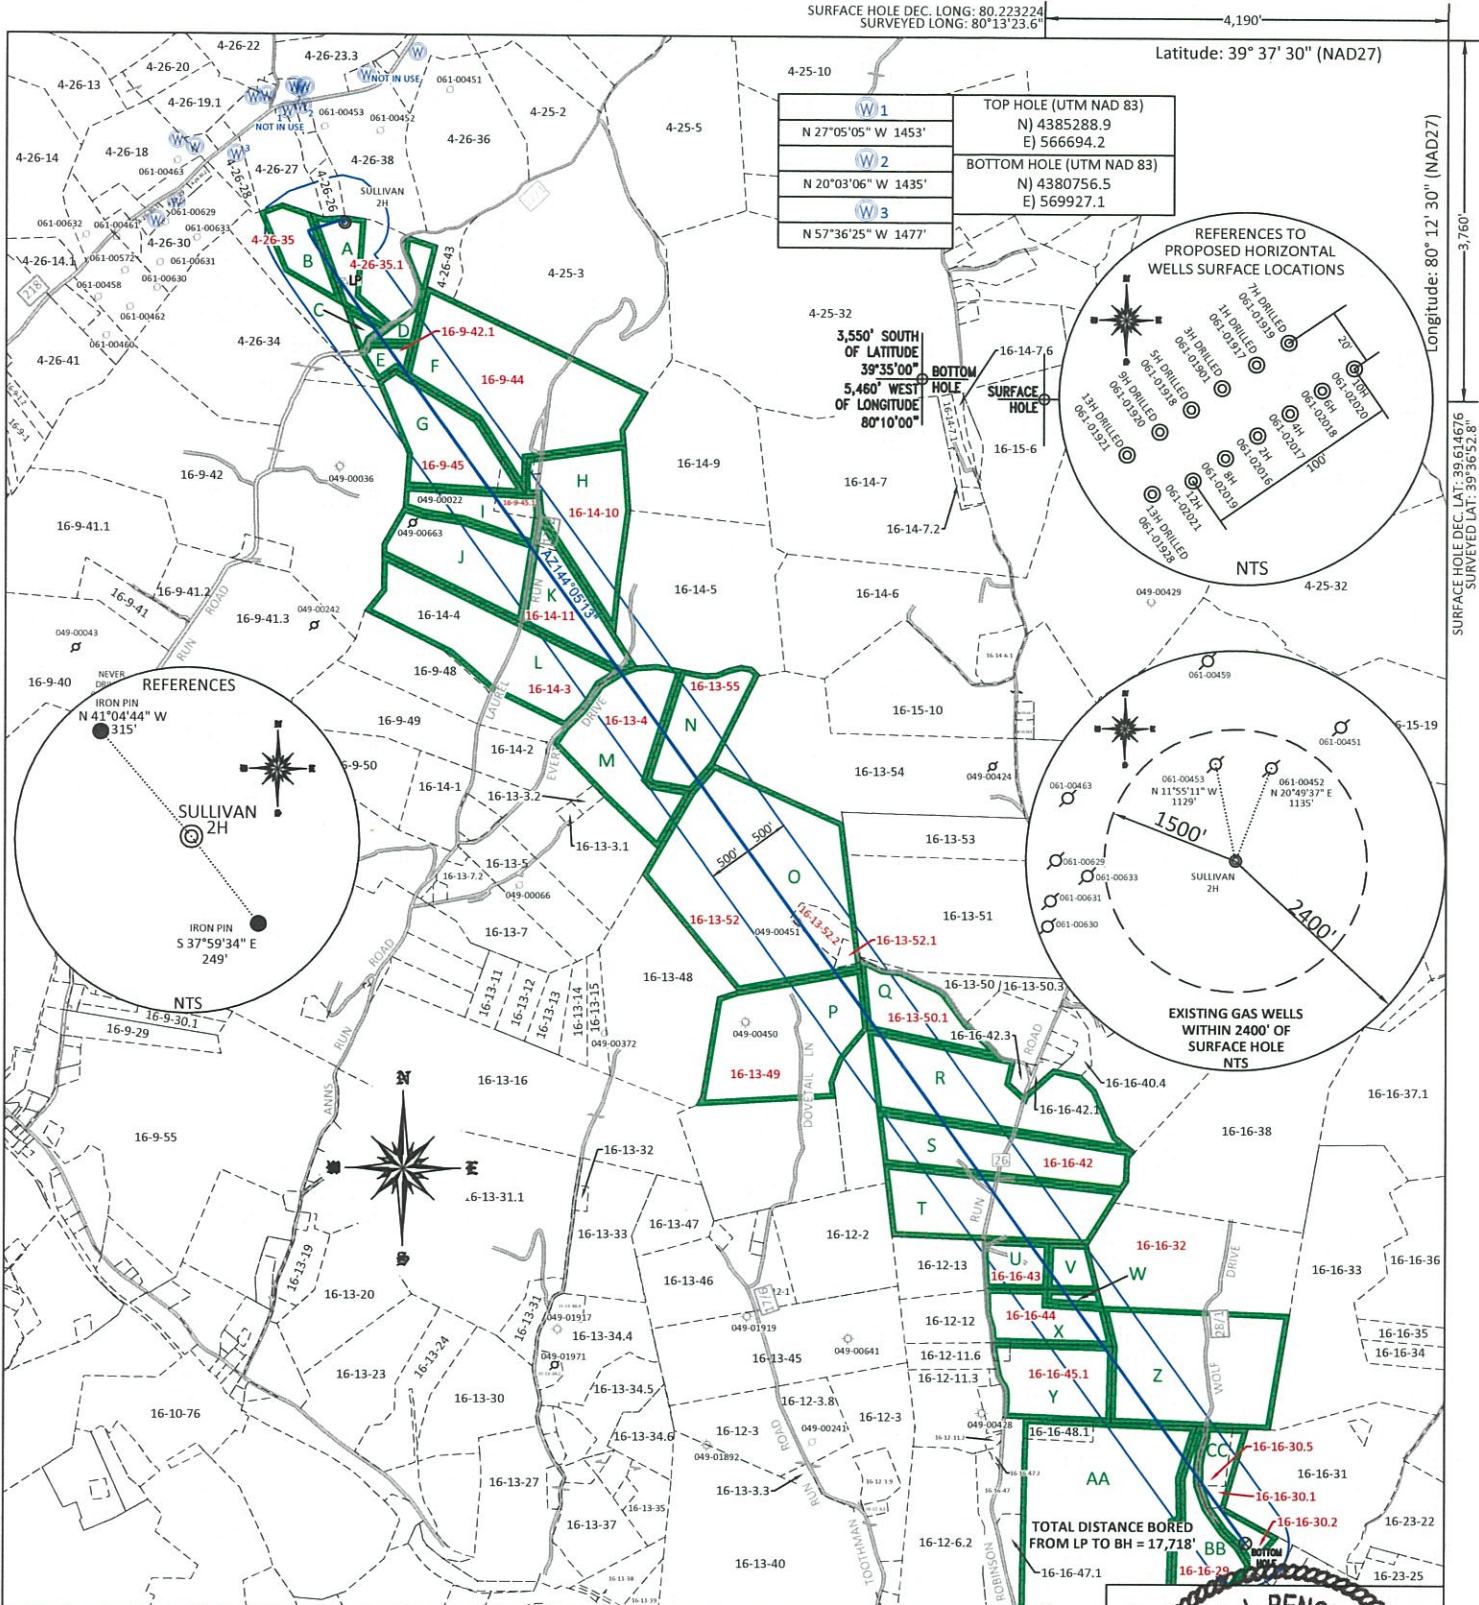


FILE #: NNE25
DRAWING #: 4139
SCALE: PLAT: 1" = 2200'
TICK MARK: 1" = 2000'
MINIMUM DEGREE OF ACCURACY: 1/200
PROVEN SOURCE OF ELEVATION: SUBMETER MAPPING GRADE GPS

I, THE UNDERSIGNED, HEREBY CERTIFY THAT THIS PLAT IS CORRECT TO THE BEST OF MY KNOWLEDGE AND BELIEF AND SHOWS ALL THE INFORMATION REQUIRED BY LAW AND THE REGULATIONS ISSUED AND PRESCRIBED BY THE DEPARTMENT OF ENVIRONMENTAL PROTECTION.

Signed: 

L.L.S. #2124 : Ernest J. Benchek III

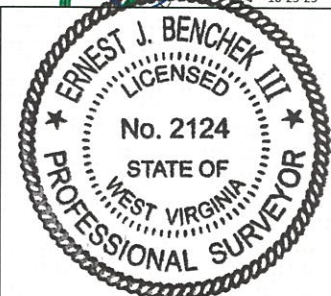

(+) DENOTES LOCATION OF WELL ON UNITED STATES TOPOGRAPHIC MAPS WVDEP
OFFICE OF OIL & GAS
601 57TH STREET
CHARLESTON, WV 25304

Well Type: ☐ Oil ☐ Waste Diposal ☐ Production ☐ Deep
☒ Gas ☐ Liquid Injection ☐ Storage ☒ Shallow

WATERSHED: UPPER MONONGAHELA RIVER

COUNTY/DISTRICT: MONONGALIA / CLAY

SURFACE OWNER: ALAN SULLIVAN

OIL & GAS ROYALTY OWNER: James T. McClimans, et al

LEASE NUMBERS:

DATE: JUNE 10, 2026

OPERATOR'S WELL #: SULLIVAN 2H

API WELL #: 47 61 02016
STATE COUNTY PERMIT

AS-BUILT ELEVATION: 1,476.7'

QUADRANGLE: GRANT TOWN

ACREAGE: 980.344 +/-

ACREAGE: 25.870 06/12/2026

DRILL ☒ CONVERT ☐ DRILL DEEPER ☐ REDRILL ☐ FRACTURE OR STIMULATE ☒
PLUG OFF FORMATION ☐ PERFORATE NEW FORMATION ☐ PLUG & ABANDON ☐
CLEAN OUT & REPLUG ☐ OTHER CHANGE ☐ (SPECIFY):

TARGET FORMATION: MARCELLUS

ESTIMATED DEPTH: TVD: 8,082' TMD: 26,227'

WELL OPERATOR: NORTHEAST NATURAL ENERGY LLC

DESIGNATED AGENT: John Adams

ADDRESS: 707 VIRGINIA STREET EAST, SUITE 1200

ADDRESS: 707 VIRGINIA STREET EAST, SUITE 1200

CITY: CHARLESTON STATE: WV ZIP CODE: 25301

CITY: CHARLESTON STATE: WV ZIP CODE: 25301

	PROPERTY OWNER INDEX
4-26-35.1	ALAN SULLIVAN
4-26-35	JAMES LOUIS DOUKAS
16-9-42.1	JAMES P & URSULA A MCDONALD
16-9-44	ROBERT R FOLEY
16-9-45	TODD E KATZNER & ERIN E ESTELL KATZNER
16-9-45.1	ANGELA M TUTALO
16-14-10	JON & MARY T WHETZEL
16-14-11	TRAVIS M & STEPHANIE M CATSONIS
16-14-3	RODNEY R & KEPPEK K MARTIN
16-13-4	BRAD N SOMMER (LEASE 1298-554 KID NATION)
16-13-55	J L TENNANT
16-13-52	JAMES & JOYCE GANDY
16-13-52.2	RIAN HITCHNER
16-13-52.1	RIAN HITCHNER
16-13-49	DAVID L PRICE JR & ANDREA L PRICE
16-13-50.1	TERI & ROBERT E ANDERSON
16-16-42	THOMAS A OR COLLEEN J WEAKS
16-16-43	QUENTIN L ROSS
16-16-44	PAMELA R HARRIS (LIFE WB 121-554)
16-16-45.1	PAUL W & PATRICIA S REESE
16-16-32	PJH RANCH LLC
16-16-30.5	BRAD L & DEBORAH A MCDOUGAL
16-16-30.1	BRAD L & DEBORAH A MCDOUGAL
16-16-30.2	BRAD L & DEBORAH A MCDOUGAL
16-16-29	LUCINDA FURBEE & MARK KING
16-16-48	JAMES S ICE

LEASE INDEX			
A	WV-061-006979-002	P	WV-049-107187-001
B	WV-061-006176-001	Q	WV-049-106812-002
C	WV-061-006979-002	R	WV-049-106130-001
D	WV-049-106826-023	S	WV-049-107115-001
E	WV-049-106978-001	T	WV-049-106130-001
F	WV-049-104886-000	U	WV-061-00219-001
G	WV-049-106843-002	V	WV-049-106801-001
H	WV-049-106066-004	W	WV-049-106802-001
I	WV-049-105234-001	X	WV-061-00219-001
J	WV-049-106843-002	Y	WV-061-00219-001
K	WV-049-105234-001	Z	WV-049-107007-001
L	WV-049-106904-001	AA	WV-049-007441-001
M	WV-061-00219-001	BB	WV-049-007661-001
N	WV-049-107024-001	CC	WV-049-107048-001
O	WV-049-107187-001		

06/12/2026

FILE #: <u>NNE20</u>	DATE: <u>JUNE 10, 2026</u>
DRAWING #: <u>4139</u>	OPERATOR'S WELL #: <u>SULLIVAN 2H</u>
SCALE: <u>N/A</u>	API WELL #: <u>47</u> <u>61</u> <u>02016</u> STATE COUNTY PERMIT