




WELL NAME: SULLIVAN 4H
GRANT TOWN, WV

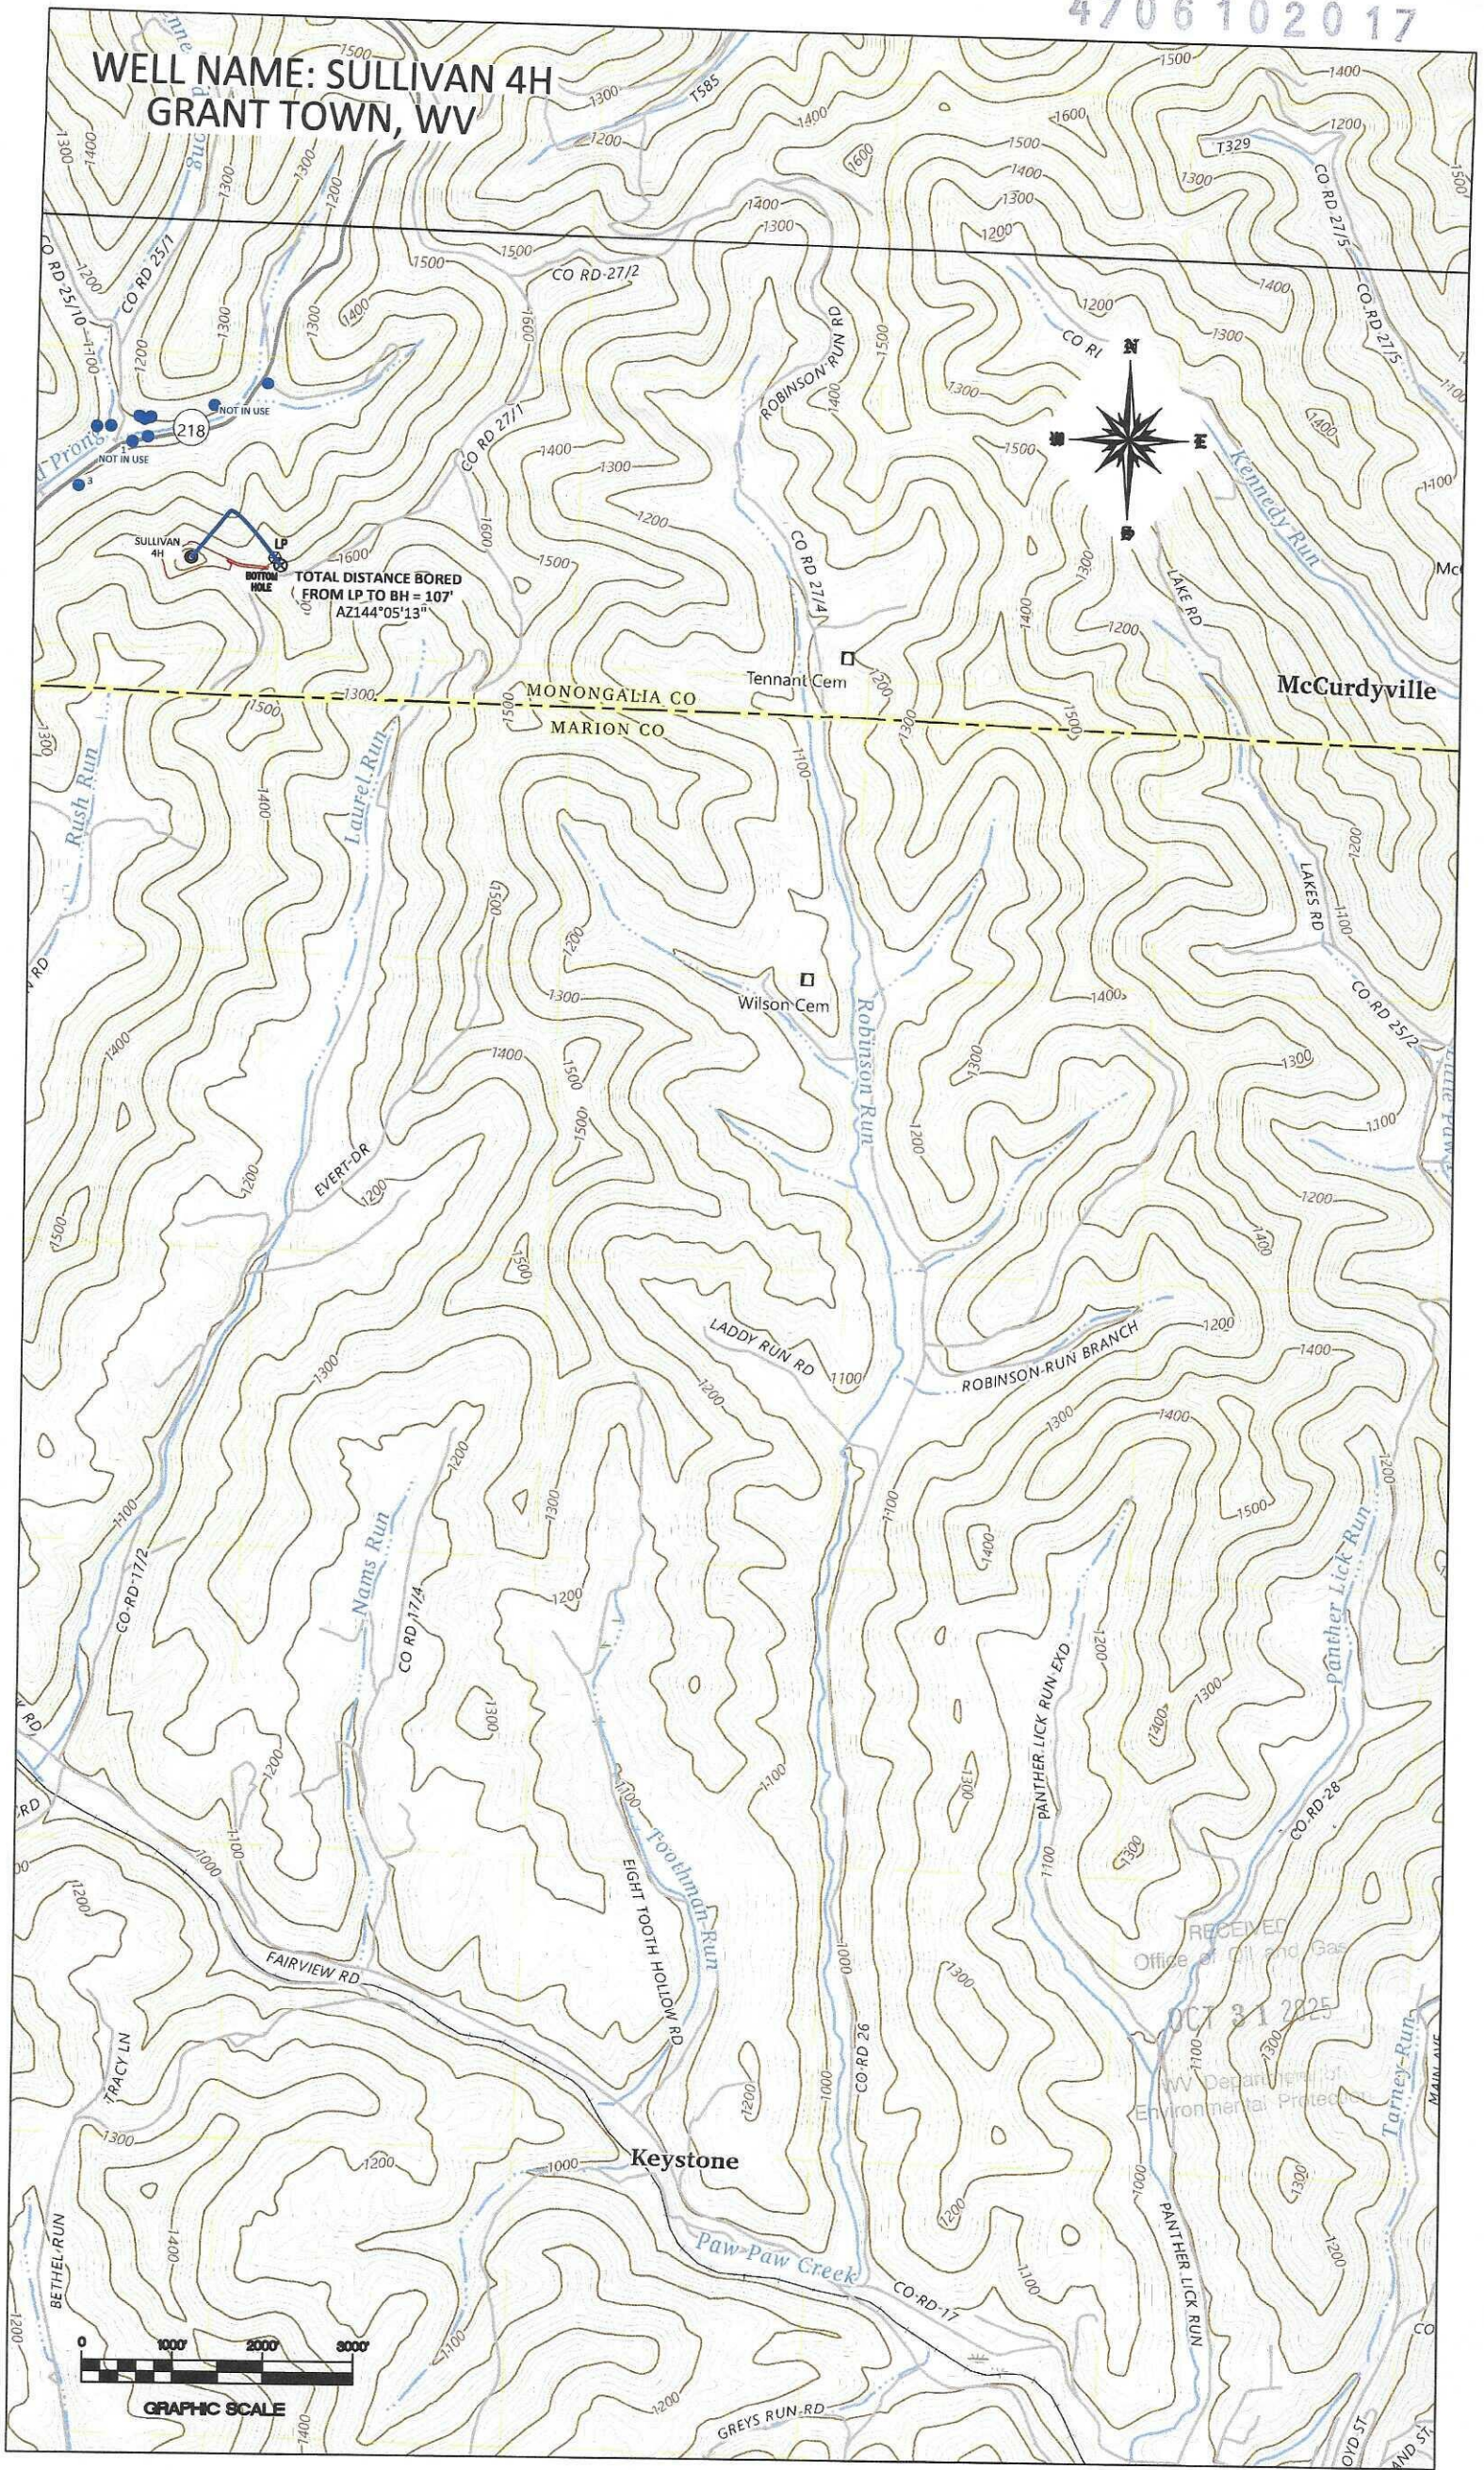


TOTAL DISTANCE BORED
FROM LP TO BH = 107'
AZ144°05'13"

MONONGALIA CO
MARION CO

McCurdyville

Keystone

RECEIVED
Office of Oil and Gas
OCT 31 2025
WV Department of
Environmental Protection

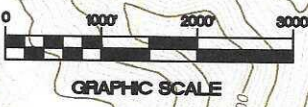


SURFACE HOLE DEC. LONG: 80.223166
SURVEYED LONG: 80°13'23.4"

4,180'

Latitude: 39° 37' 30" (NAD27)

Longitude: 80° 12' 30" (NAD27)

SURFACE HOLE DEC. LAT: 39.614708
SURVEYED LAT: 39°36'53.0"

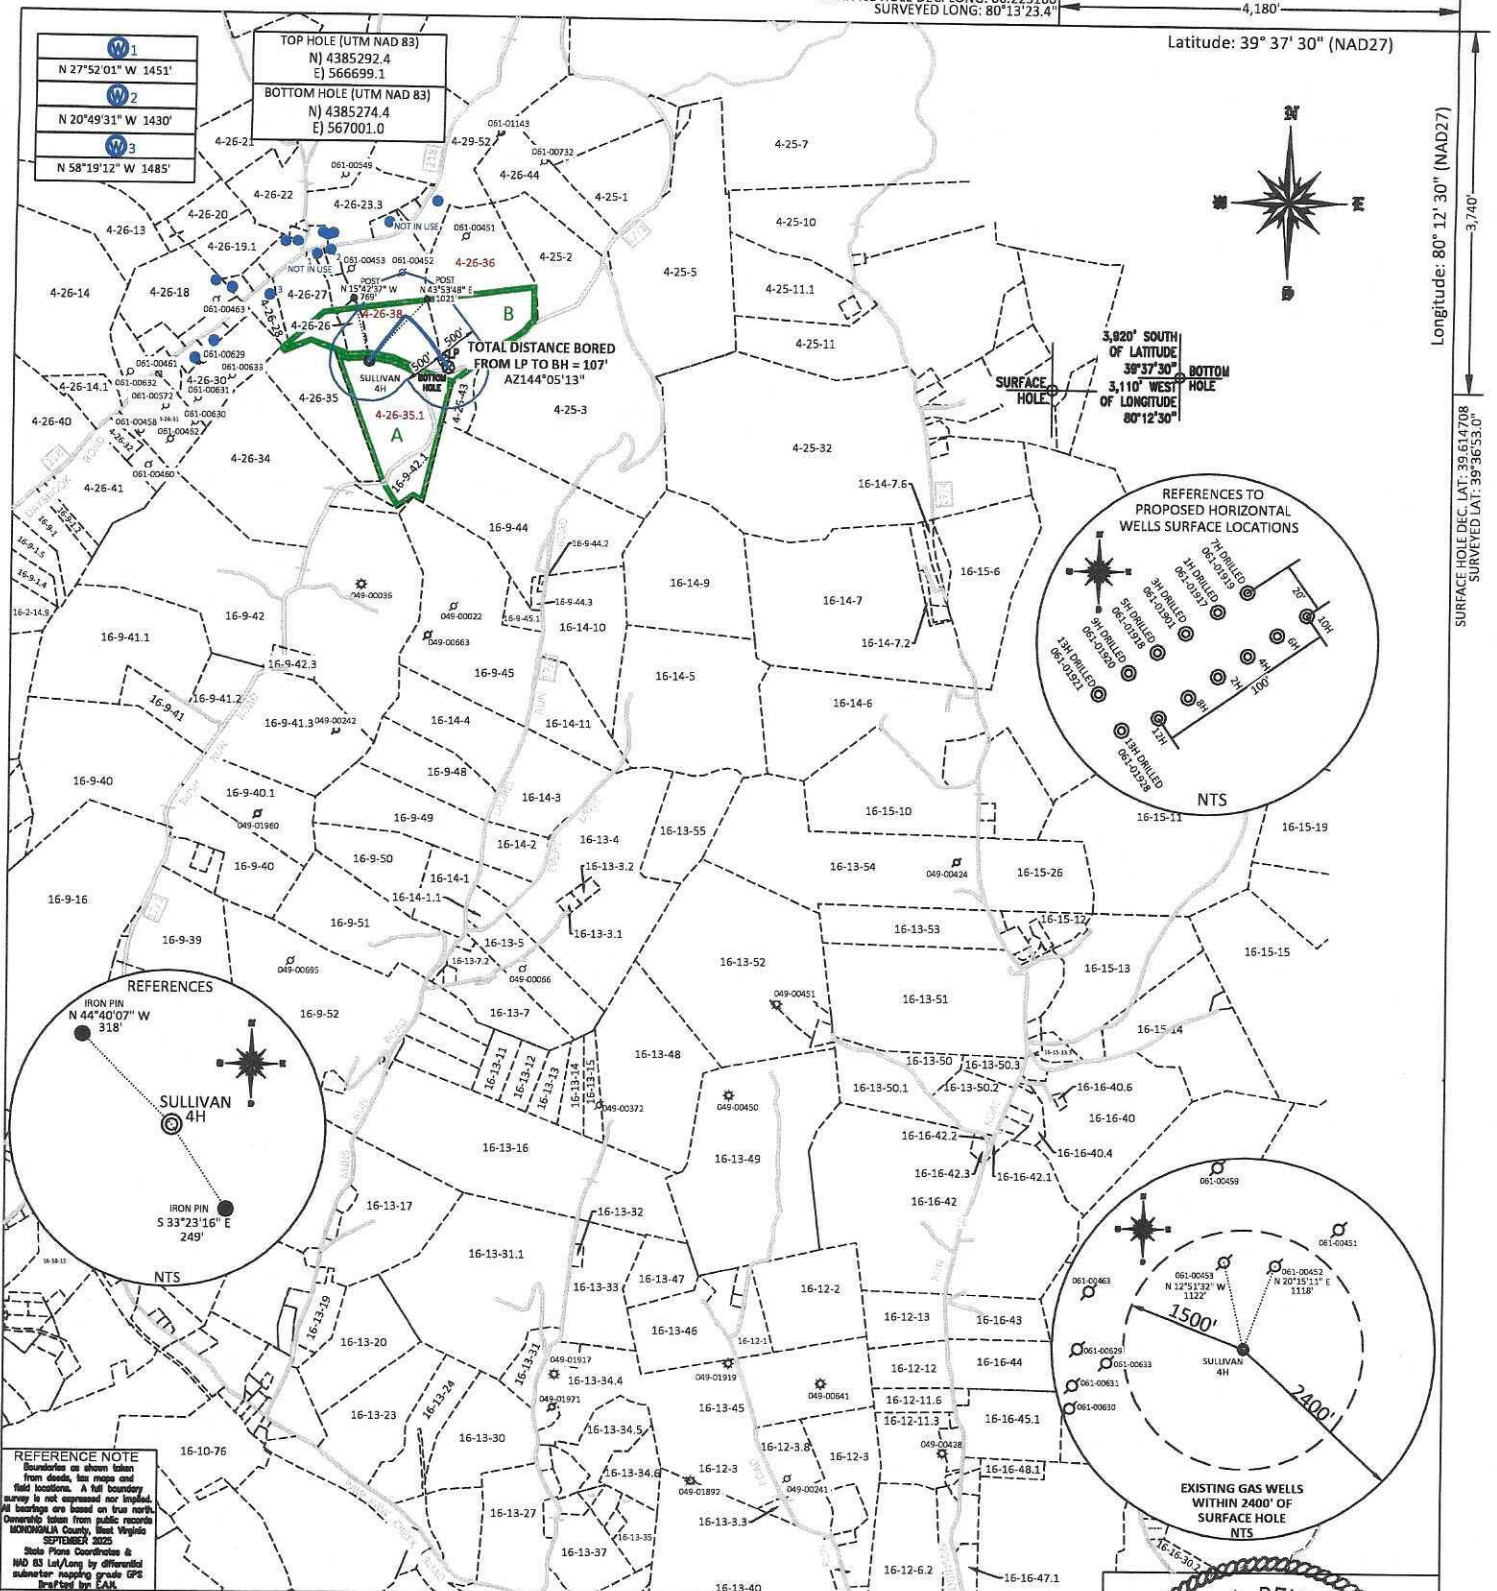

FILE #: NNE25
DRAWING #: 4157
SCALE: PLAT: 1" = 2400'
TICK MARK: 1" = 2000'
MINIMUM DEGREE OF ACCURACY: 1/200
PROVEN SOURCE OF ELEVATION: SUBMETER MAPPING GRADE GPS

I, THE UNDERSIGNED, HEREBY CERTIFY THAT THIS PLAT IS CORRECT TO THE BEST OF MY KNOWLEDGE AND BELIEF AND SHOWS ALL THE INFORMATION REQUIRED BY LAW AND THE REGULATIONS ISSUED AND PRESCRIBED BY THE DEPARTMENT OF ENVIRONMENTAL PROTECTION.
Signed:
L.L.S. #2124 : Ernest J. Benchek III



(+) DENOTES LOCATION OF WELL ON UNITED STATES TOPOGRAPHIC MAPS WVDEP
OFFICE OF OIL & GAS
601 57TH STREET
CHARLESTON, WV 25304
Well Type: ☐ Oil ☐ Waste Diposal ☐ Production ☐ Deep
☒ Gas ☐ Liquid Injection ☐ Storage ☒ Shallow
WATERSHED: UPPER MONONGAHELA RIVER
COUNTY/DISTRICT: MONONGALIA / CLAY
SURFACE OWNER: ALAN SULLIVAN
OIL & GAS ROYALTY OWNER: ALAN SULLIVAN
LEASE NUMBERS:

DATE: OCTOBER 10, 2025
OPERATOR'S WELL #: SULLIVAN 4H
API WELL #: 47 061 02017
STATE COUNTY PERMIT
AS-BUILT ELEVATION: 1,476.7'
QUADRANGLE: GRANT TOWN
ACREAGE: 85.276 +/-
ACREAGE: 25.870 +/-

DRILL ☒ CONVERT ☐ DRILL DEEPER ☐ REDRILL ☐ FRACTURE OR STIMULATE ☒
PLUG OFF FORMATION ☐ PERFORATE NEW FORMATION ☐ PLUG & ABANDON ☐
CLEAN OUT & REPLUG ☐ OTHER CHANGE ☐ (SPECIFY):
TARGET FORMATION: MARCELLUS
WELL OPERATOR: NORTHEAST NATURAL ENERGY LLC
ADDRESS: 707 VIRGINIA STREET EAST, SUITE 1200
CITY: CHARLESTON STATE: WV ZIP CODE: 25301
ESTIMATED DEPTH: TVD: 8,082' TMD: 8,654'
DESIGNATED AGENT: JOHN ADAMS
ADDRESS: 707 VIRGINIA STREET EAST, SUITE 1200
CITY: CHARLESTON STATE: WV ZIP CODE: 25301

	PROPERTY OWNER INDEX
4-26-35.1	ALAN SULLIVAN
4-26-38	ADAM CLAY DARRAH
4-26-36	LARRY NOLAN & LINDA MAE PAYTON

	LEASE INDEX
A	WV-061-005448-002
B	WV-061-005256-001

FILE #: <u> NNE25 </u> DRAWING #: <u> 4157 </u> SCALE: <u> N/A </u>	DATE: <u> OCTOBER 13, 2025 </u> OPERATOR'S WELL #: <u> SULLIVAN 4H </u> API WELL #: <u> 47 </u> <u> 061 </u> <u> 02017 </u> STATECOUNTYPERMIT
---	---