



WELL NAME: SULLIVAN 4H
Catherine's
MONONGALIA Co., WV / GRANT TOWN QUAD

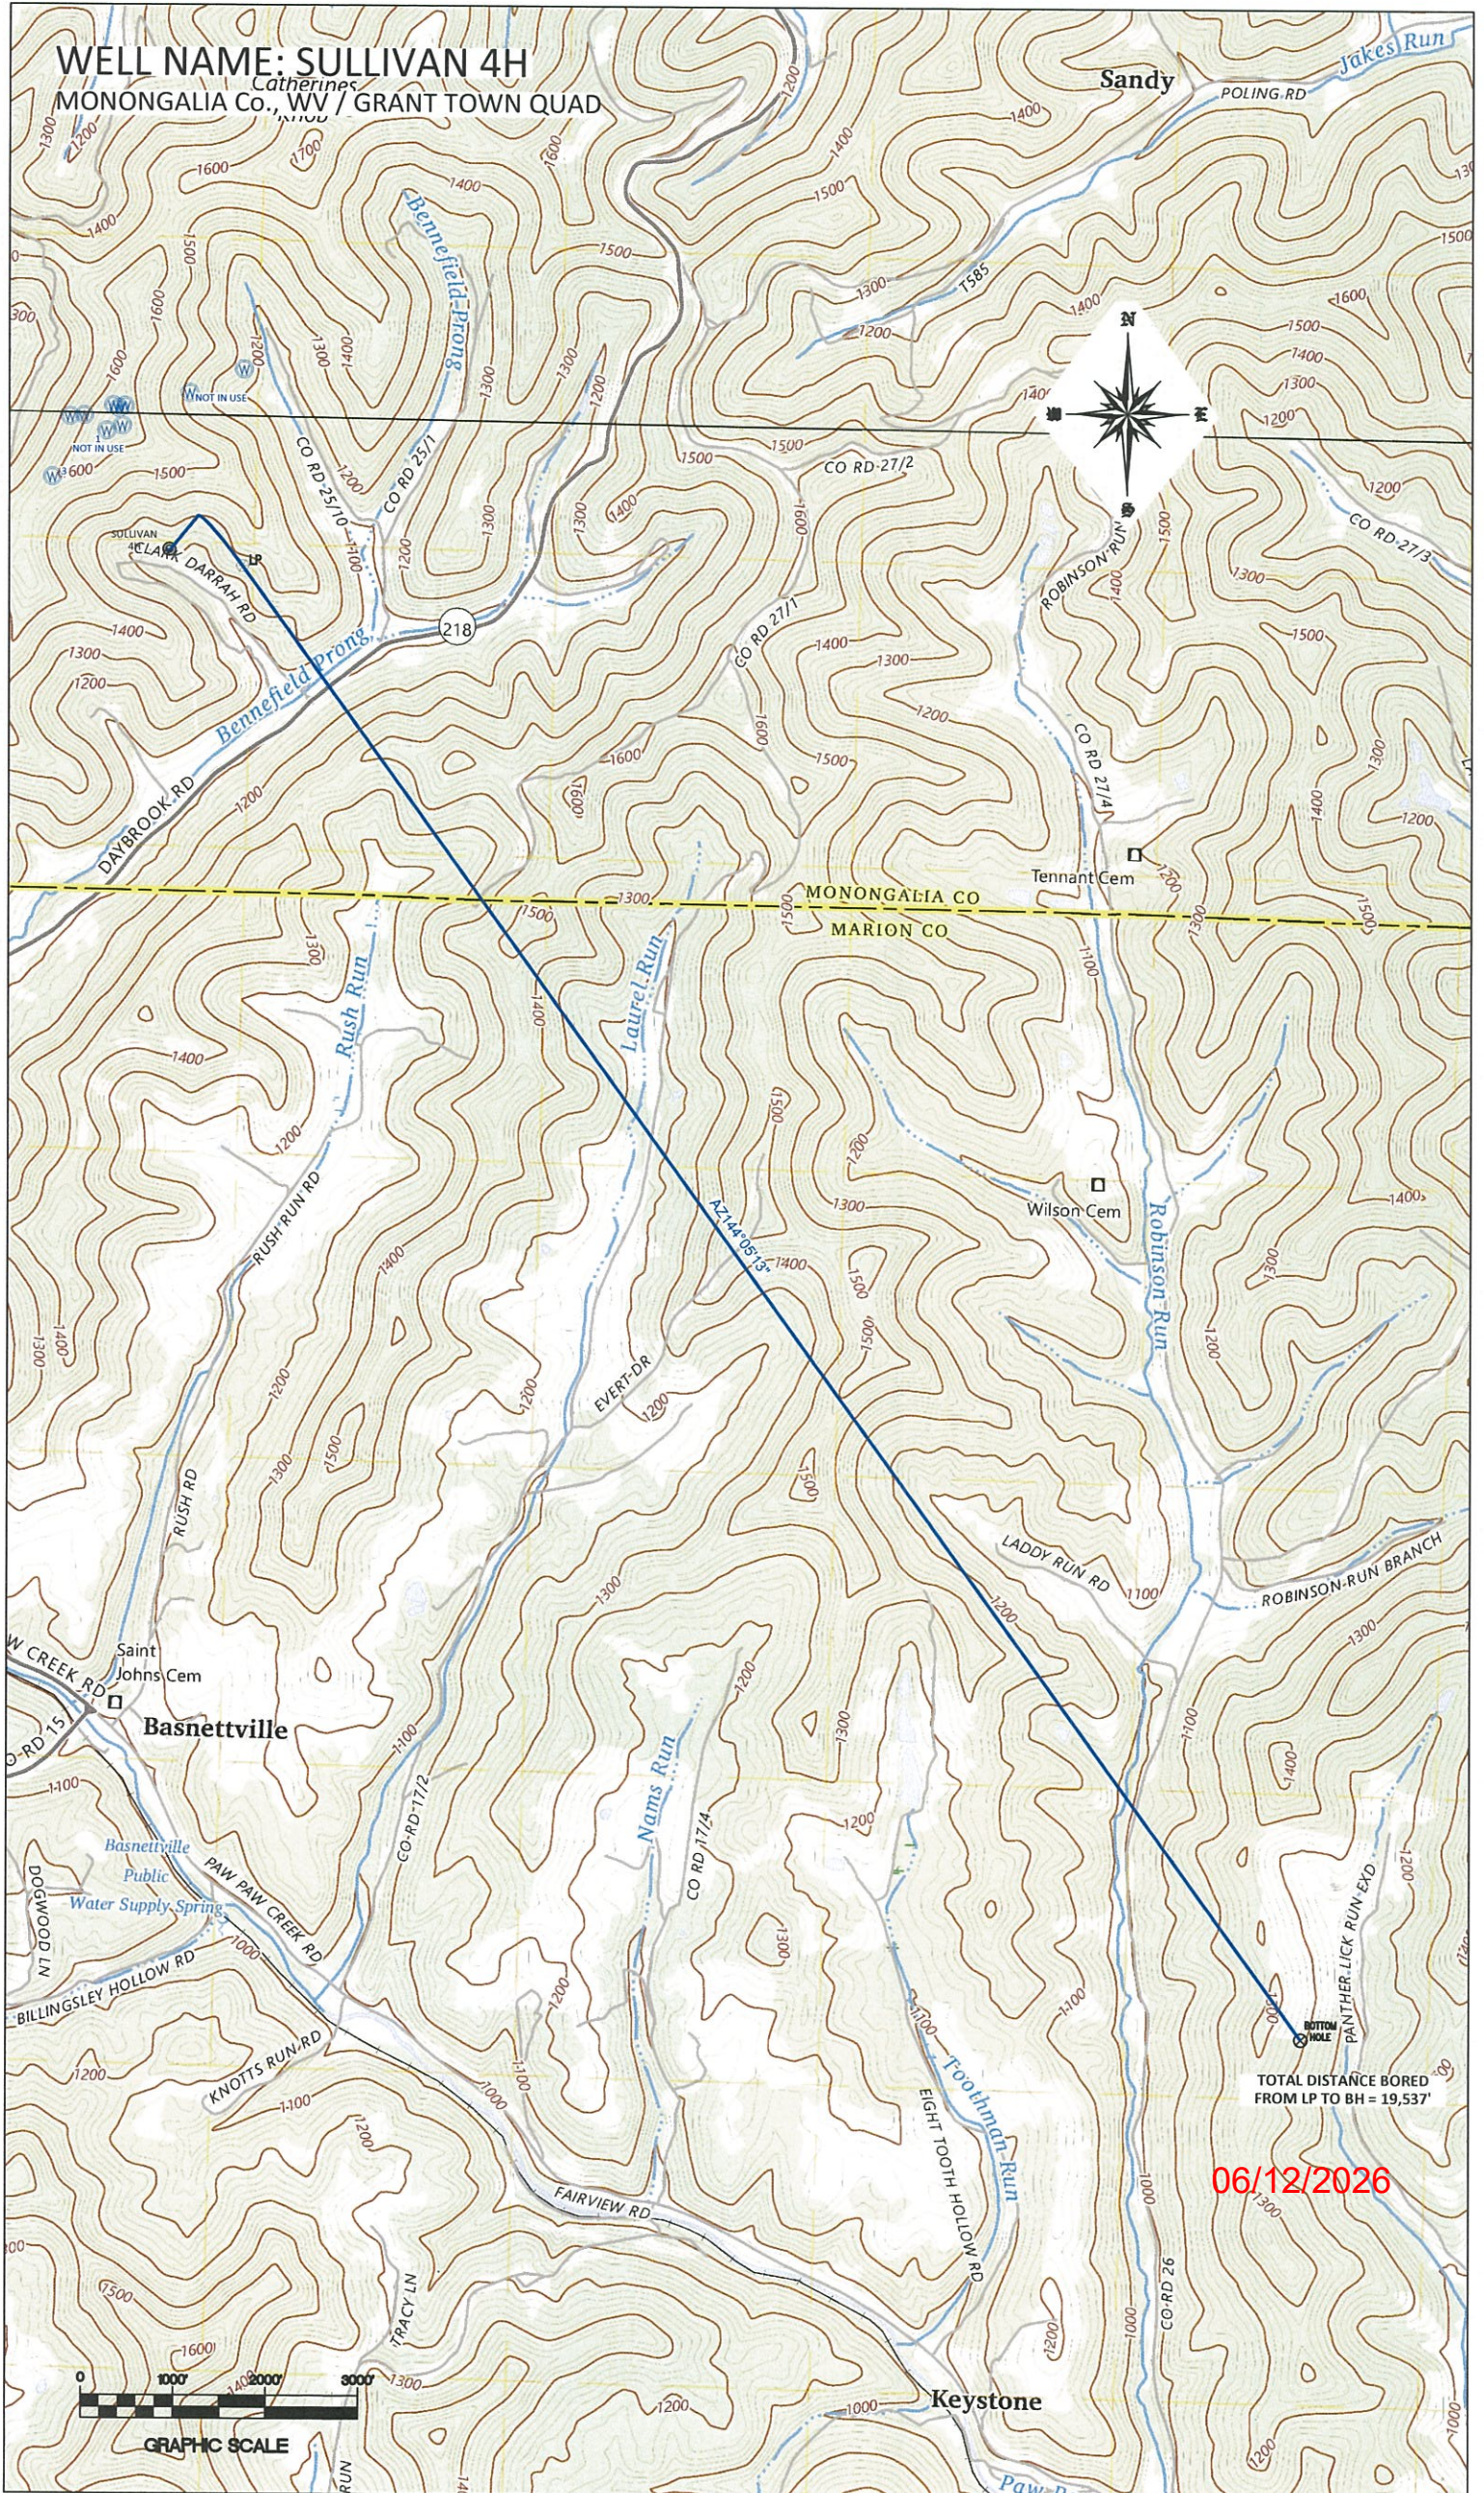

06/12/2026

TOTAL DISTANCE BORED
FROM LP TO BH = 19,537'

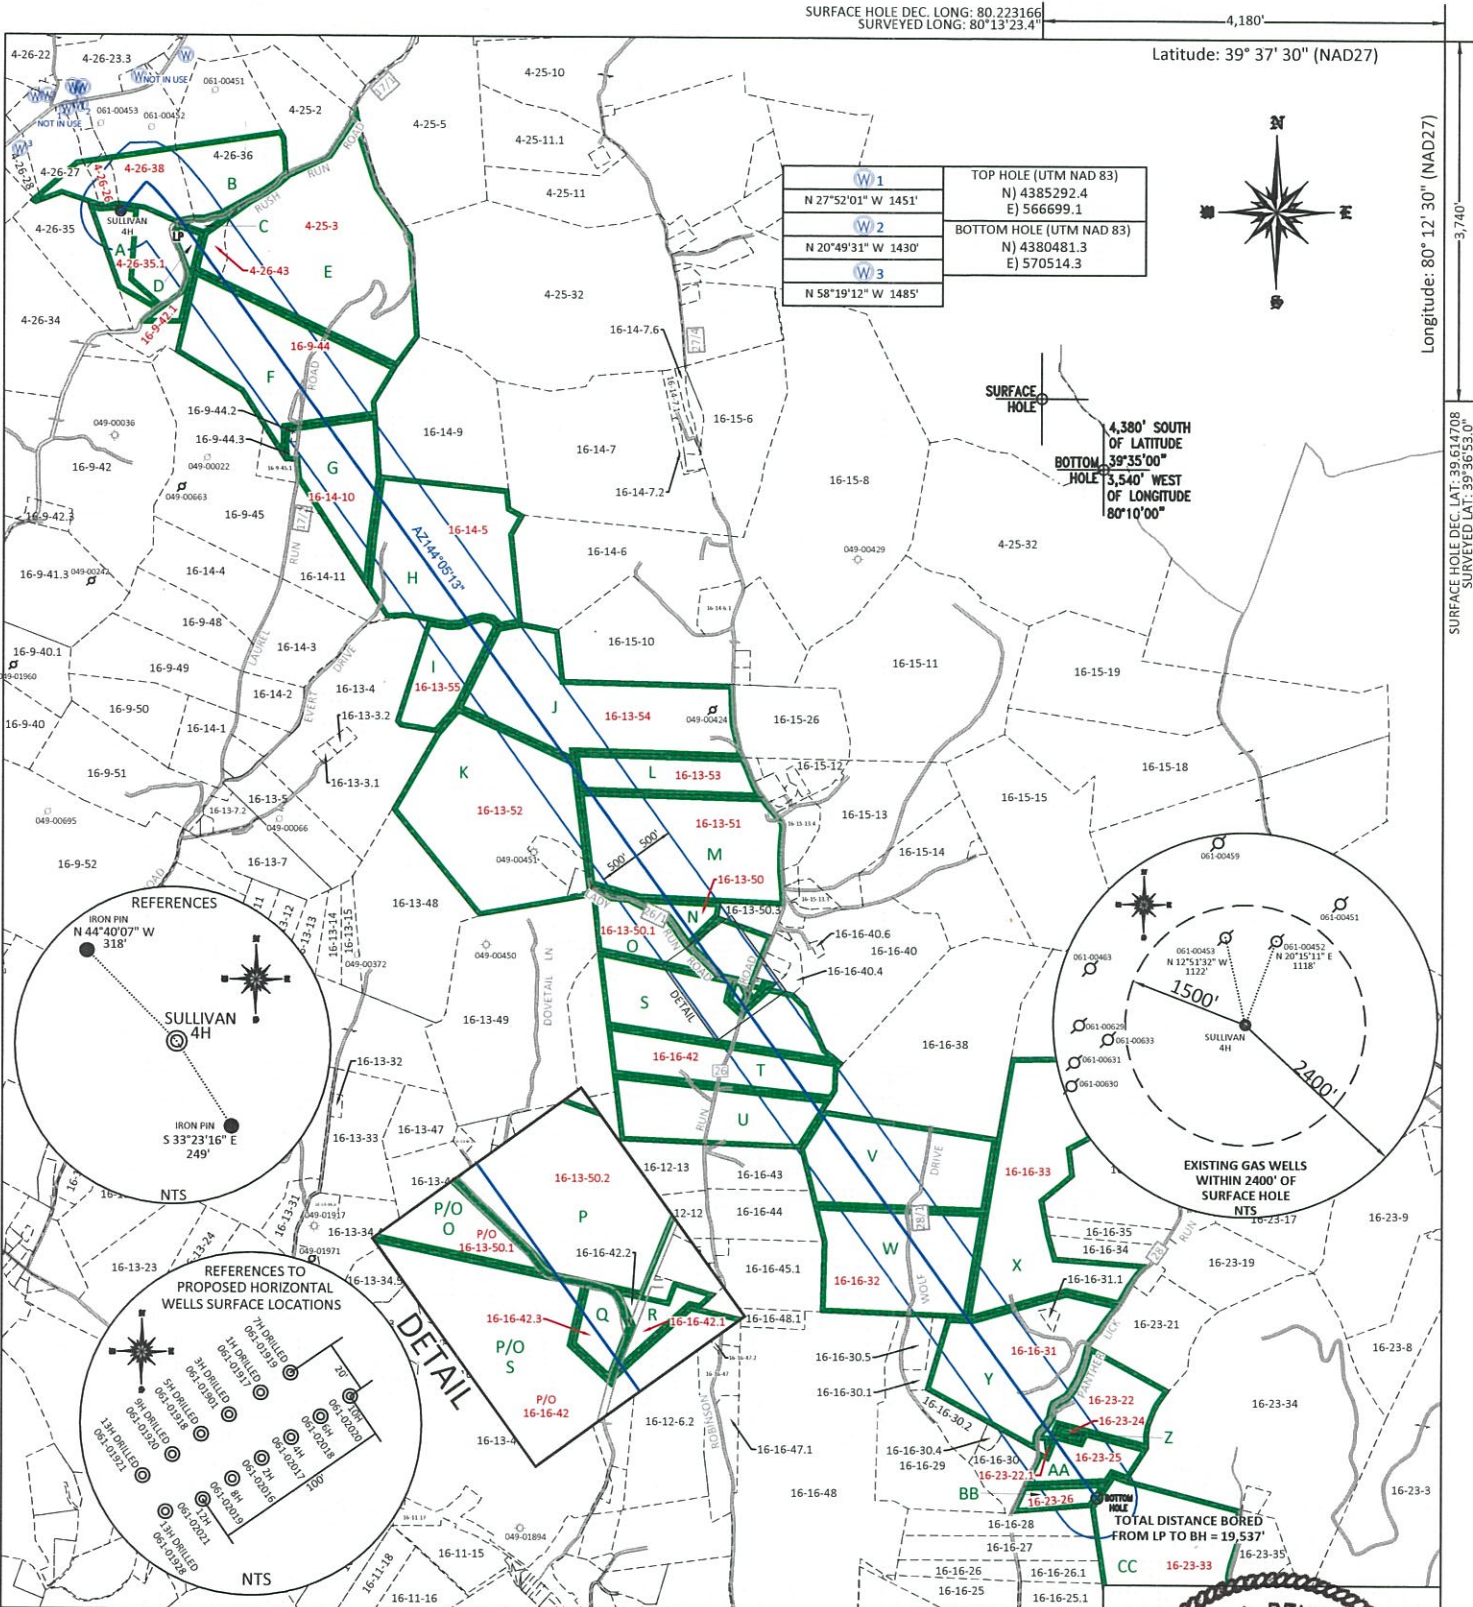


FILE #: NNE25
DRAWING #: 4140
SCALE: PLAT: 1" = 2400'
TICK MARK: 1" = 2000'
MINIMUM DEGREE OF ACCURACY: 1/200
PROVEN SOURCE OF ELEVATION: SUBMETER MAPPING GRADE GPS

I, THE UNDERSIGNED, HEREBY CERTIFY THAT THIS PLAT IS CORRECT TO THE BEST OF MY KNOWLEDGE AND BELIEF AND SHOWS ALL THE INFORMATION REQUIRED BY LAW AND THE REGULATIONS ISSUED AND PRESCRIBED BY THE DEPARTMENT OF ENVIRONMENTAL PROTECTION.

Signed: 

L.L.S. #2124 : Ernest J. Benchek III

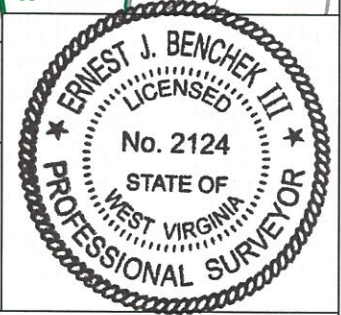

(+) DENOTES LOCATION OF WELL ON UNITED STATES TOPOGRAPHIC MAPS WVDEP
OFFICE OF OIL & GAS
601 57TH STREET
CHARLESTON, WV 25304

Well Type: ☐ Oil ☐ Waste Diposal ☐ Production ☐ Deep
☒ Gas ☐ Liquid Injection ☐ Storage ☒ Shallow

WATERSHED: UPPER MONONGAHELA RIVER

COUNTY/DISTRICT: MONONGALIA / CLAY

SURFACE OWNER: ALAN SULLIVAN

OIL & GAS ROYALTY OWNER: James T. McClimans, et al

LEASE NUMBERS:

DATE: JUNE 10, 2026

OPERATOR'S WELL #: SULLIVAN 4H

API WELL #: 47 61 02017
STATE COUNTY PERMIT

AS-BUILT ELEVATION: 1,476.7'

QUADRANGLE: GRANT TOWN

ACREAGE: 1195.550 +/-
ACREAGE: 25.870 +/-

06/12/2026

DRILL ☒ CONVERT ☐ DRILL DEEPER ☐ REDRILL ☐ FRACTURE OR STIMULATE ☒
PLUG OFF FORMATION ☐ PERFORATE NEW FORMATION ☐ PLUG & ABANDON ☐
CLEAN OUT & REPLUG ☐ OTHER CHANGE ☐ (SPECIFY):

TARGET FORMATION: MARCELLUS

WELL OPERATOR: NORTHEAST NATURAL ENERGY LLC

ADDRESS: 707 VIRGINIA STREET EAST, SUITE 1200

CITY: CHARLESTON STATE: WV ZIP CODE: 25301

ESTIMATED DEPTH: TVD: 8,082' TMD: 28,059'

DESIGNATED AGENT: John Adams

ADDRESS: 707 VIRGINIA STREET EAST, SUITE 1200

CITY: CHARLESTON STATE: WV ZIP CODE: 25301

	PROPERTY OWNER INDEX
4-26-35.1	ALAN SULLIVAN
4-26-26	NNE MIDSTREAM LLC
4-26-38	ADAM CLAY DARRAH
16-9-42.1	JAMES P & URSULA A MCDONALD
4-26-43	CLIFTON E TENNANT JR
4-25-3	DAVID M & DAWN M LINDNER
16-9-44	ROBERT R FOLEY
16-14-10	JON & MARY T WHETZEL
16-14-5	JOHN W & KAREN D CARPENTER
16-13-55	J L TENNANT
16-13-54	NICHOLAS CARLYLE
16-13-52	JAMES & JOYCE GANDY
16-13-53	KERRY L DARRAH (1/2 INT) & KERRY L & TROY (1/2 INT)
16-13-51	KERRY L DARRAH (1/2 INT) & KERRY L & TROY (1/2 INT)
16-13-50	LEO T MCINTOSH JR & CARRIE AMCINTOSH
16-13-50.2	GUY POOLE JR & LOIS J POOLE
16-13-50.1	TERI & ROBERT E ANDERSON
16-16-42	THOMAS A OR COLLEEN J WEAKS
16-16-42.3	WILLIAM B & ANGELA R WRIGHT
16-16-42.1	MARY J CARMAN
16-16-32	PJH RANCH LLC
16-16-33	DENNIS H & FRANCIS A FURBEE
16-16-31	ANDREW D FURBEE
16-23-22	RAY A MARTIN JR & JESSICA M MARTIN
16-23-24	LESA GORMAN
16-23-22.1	RAY A MARTIN JR & JESSICA M MARTIN
16-23-25	KEVIN B SLEETH
16-23-26	MARK B & LUCINDA F KING
16-23-33	ARLEEN D RODRIGUEZ (LIFE 1221-23)

	LEASE INDEX	
A	WV-061-006979-002	P WV-049-106812-002
B	WV-061-006256-001	Q WV-049-107169-001
C	WV-061-006256-001	R WV-049-106130-001
D	WV-049-106826-023	S WV-049-106130-001
E	WV-061-003690-001	T WV-049-107115-001
F	WV-049-104886-000	U WV-049-106130-001
G	WV-049-106066-004	V WV-049-704336-001
H	WV-049-104934-000	W WV-049-107007-001
I	WV-049-107024-001	X WV-061-00219-001
J	WV-049-106950-001	Y WV-049-106726-001
K	WV-049-107186-001	Z WV-049-107059-001
L	WV-049-107209-010	AA WV-049-800345-001
M	WV-049-106790-001	BB WV-049-007662-001
N	WV-049-106812-002	CC WV-049-007661-001
O	WV-049-106812-002	

06/12/2026

FILE #: NNE20	DATE: JUNE 10, 2026
DRAWING #: 4140	OPERATOR'S WELL #: SULLIVAN 4H
SCALE: N/A	API WELL #: 47 61 02017 STATE COUNTY PERMIT