



SULLIVAN WATER WELLS
OCTOBER 7, 2025
SCALE - (1"=600')


RECEIVED
Office of Oil and Gas


OCT 31 2025

WV Department of
Environmental Protection

4706102018

WELL NAME: SULLIVAN 6H
GRANT TOWN, WV

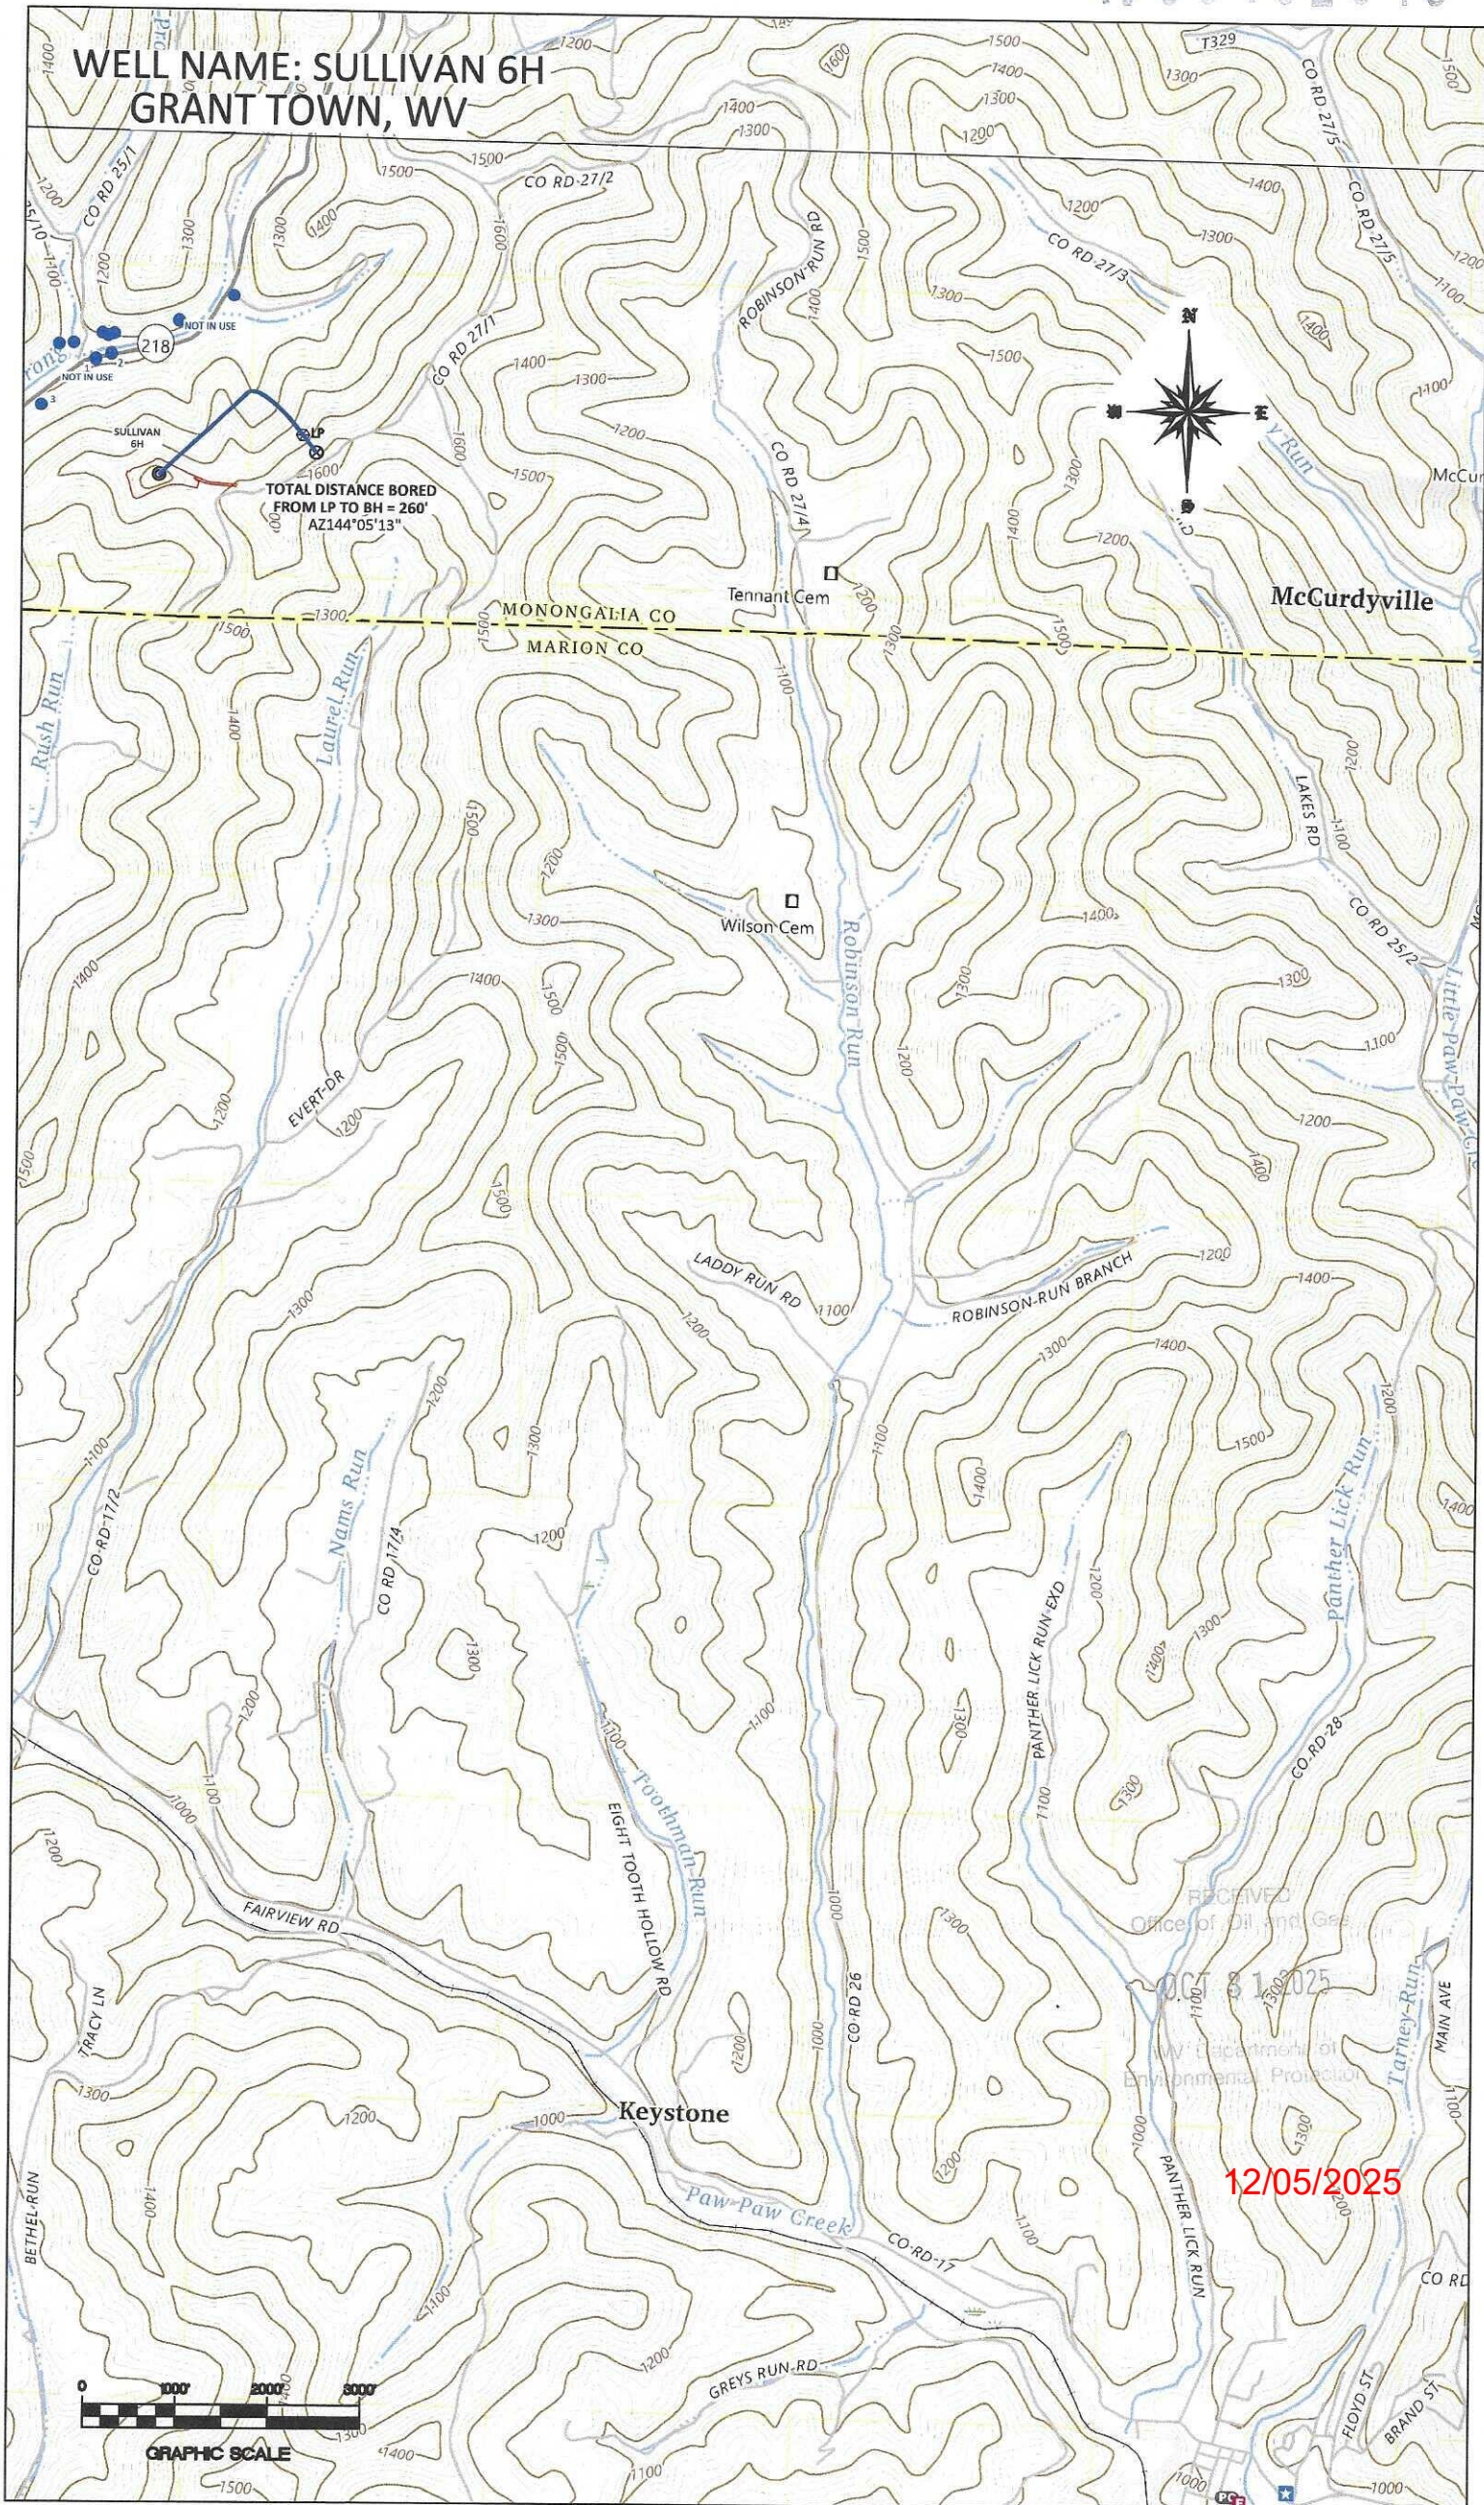

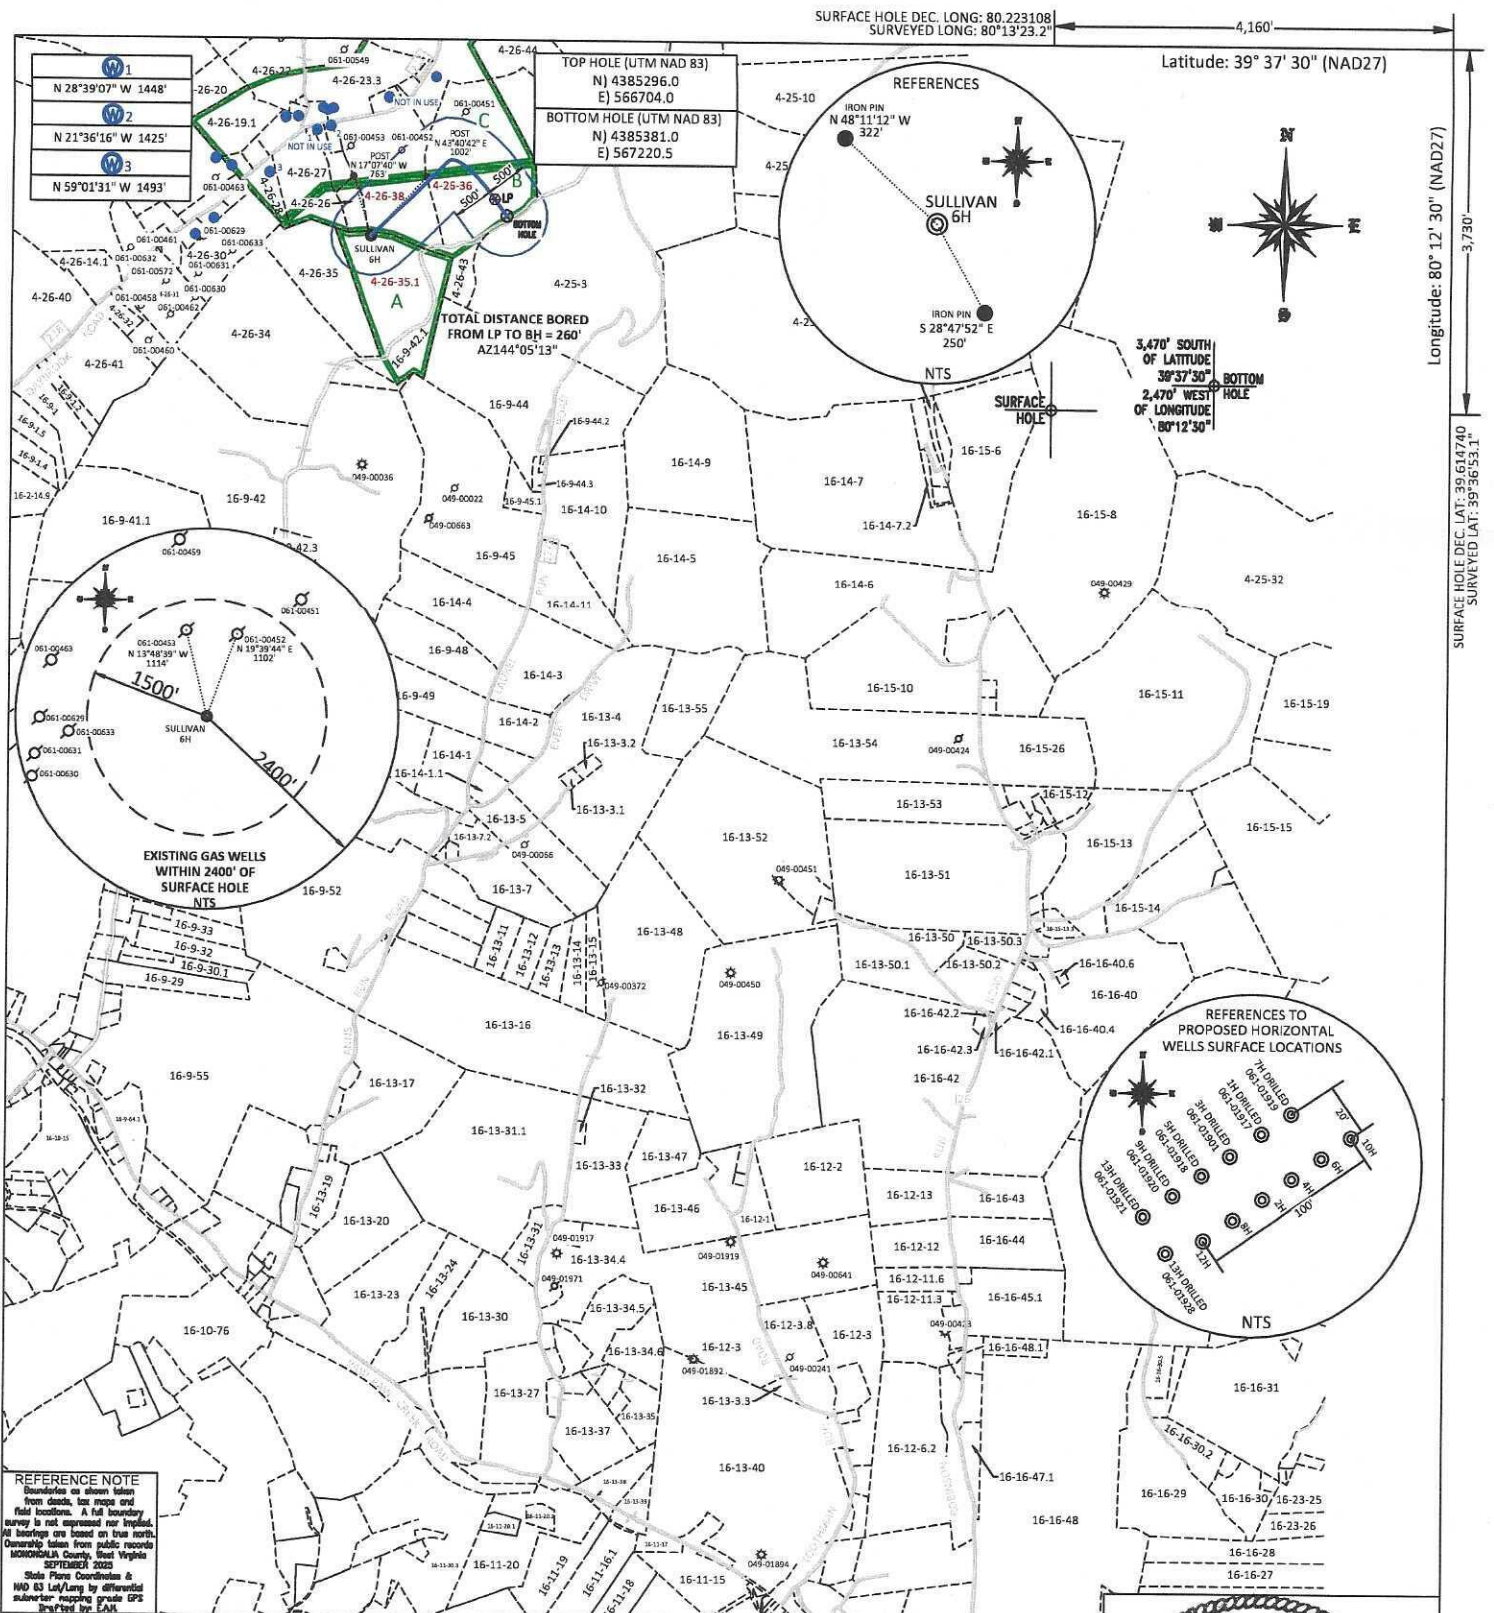

(+) DENOTES LOCATION OF WELL ON UNITED STATES TOPOGRAPHIC MAPS
WVDEP
OFFICE OF OIL & GAS
601 57TH STREET
CHARLESTON, WV 25304

DATE: OCTOBER 13, 2025

OPERATOR'S WELL #: SULLIVAN 6H

API WELL #: 47 D61 02018
STATE COUNTY PERMIT

Well Type: ☐ Oil ☐ Waste Diposal ☐ Production ☐ Deep
☒ Gas ☐ Liquid Injection ☐ Storage ☒ Shallow

WATERSHED: UPPER MONONGAHELA RIVER

AS-BUILT
ELEVATION: 1,476.7'

COUNTY/DISTRICT: MONONGALIA / CLAY

QUADRANGLE: GRANT TOWN

SURFACE OWNER: ALAN SULLIVAN

ACREAGE: 85.276 +/-

OIL & GAS ROYALTY OWNER: ALAN SULLIVAN

ACREAGE: 25.870 +/-

LEASE NUMBERS:

DRILL ☒ CONVERT ☐ DRILL DEEPER ☐ REDRILL ☐ FRACTURE OR STIMULATE ☒
PLUG OFF FORMATION ☐ PERFORATE NEW FORMATION ☐ PLUG & ABANDON ☐
CLEAN OUT & REPLUG ☐ OTHER CHANGE ☐ (SPECIFY):

TARGET FORMATION: MARCELLUS

ESTIMATED DEPTH: TVD: 8,082' TMD: 8,972'

WELL OPERATOR: NORTHEAST NATURAL ENERGY LLC

DESIGNATED AGENT: JOHN ADAMS

ADDRESS: 707 VIRGINIA STREET EAST, SUITE 1200

ADDRESS: 707 VIRGINIA STREET EAST, SUITE 1200

CITY: CHARLESTON STATE: WV ZIP CODE: 25301

CITY: CHARLESTON STATE: WV ZIP CODE: 25301

	PROPERTY OWNER INDEX
4-26-35.1	ALAN SULLIVAN
4-26-38	ADAM CLAY DARRAH
4-26-36	LARRY NOLAN & LINDA MAE PAYTON

	LEASE INDEX
A	WV-061-005448-002
B	WV-061-005256-001
C	WV-061-005256-001

12/05/2025

FILE #: <u> NNE25 </u> DRAWING #: <u> 4158 </u> SCALE: <u> N/A </u>	DATE: <u> OCTOBER 13, 2025 </u> OPERATOR'S WELL #: <u> SULLIVAN 6H </u> API WELL #: <u> 47 </u> <u> 061 </u> <u> 02018 </u> STATECOUNTYPERMIT
---	---