



WELL NAME: SULLIVAN 8H
Catherine's
MONONGALIA Co., WV / GRANT TOWN QUAD

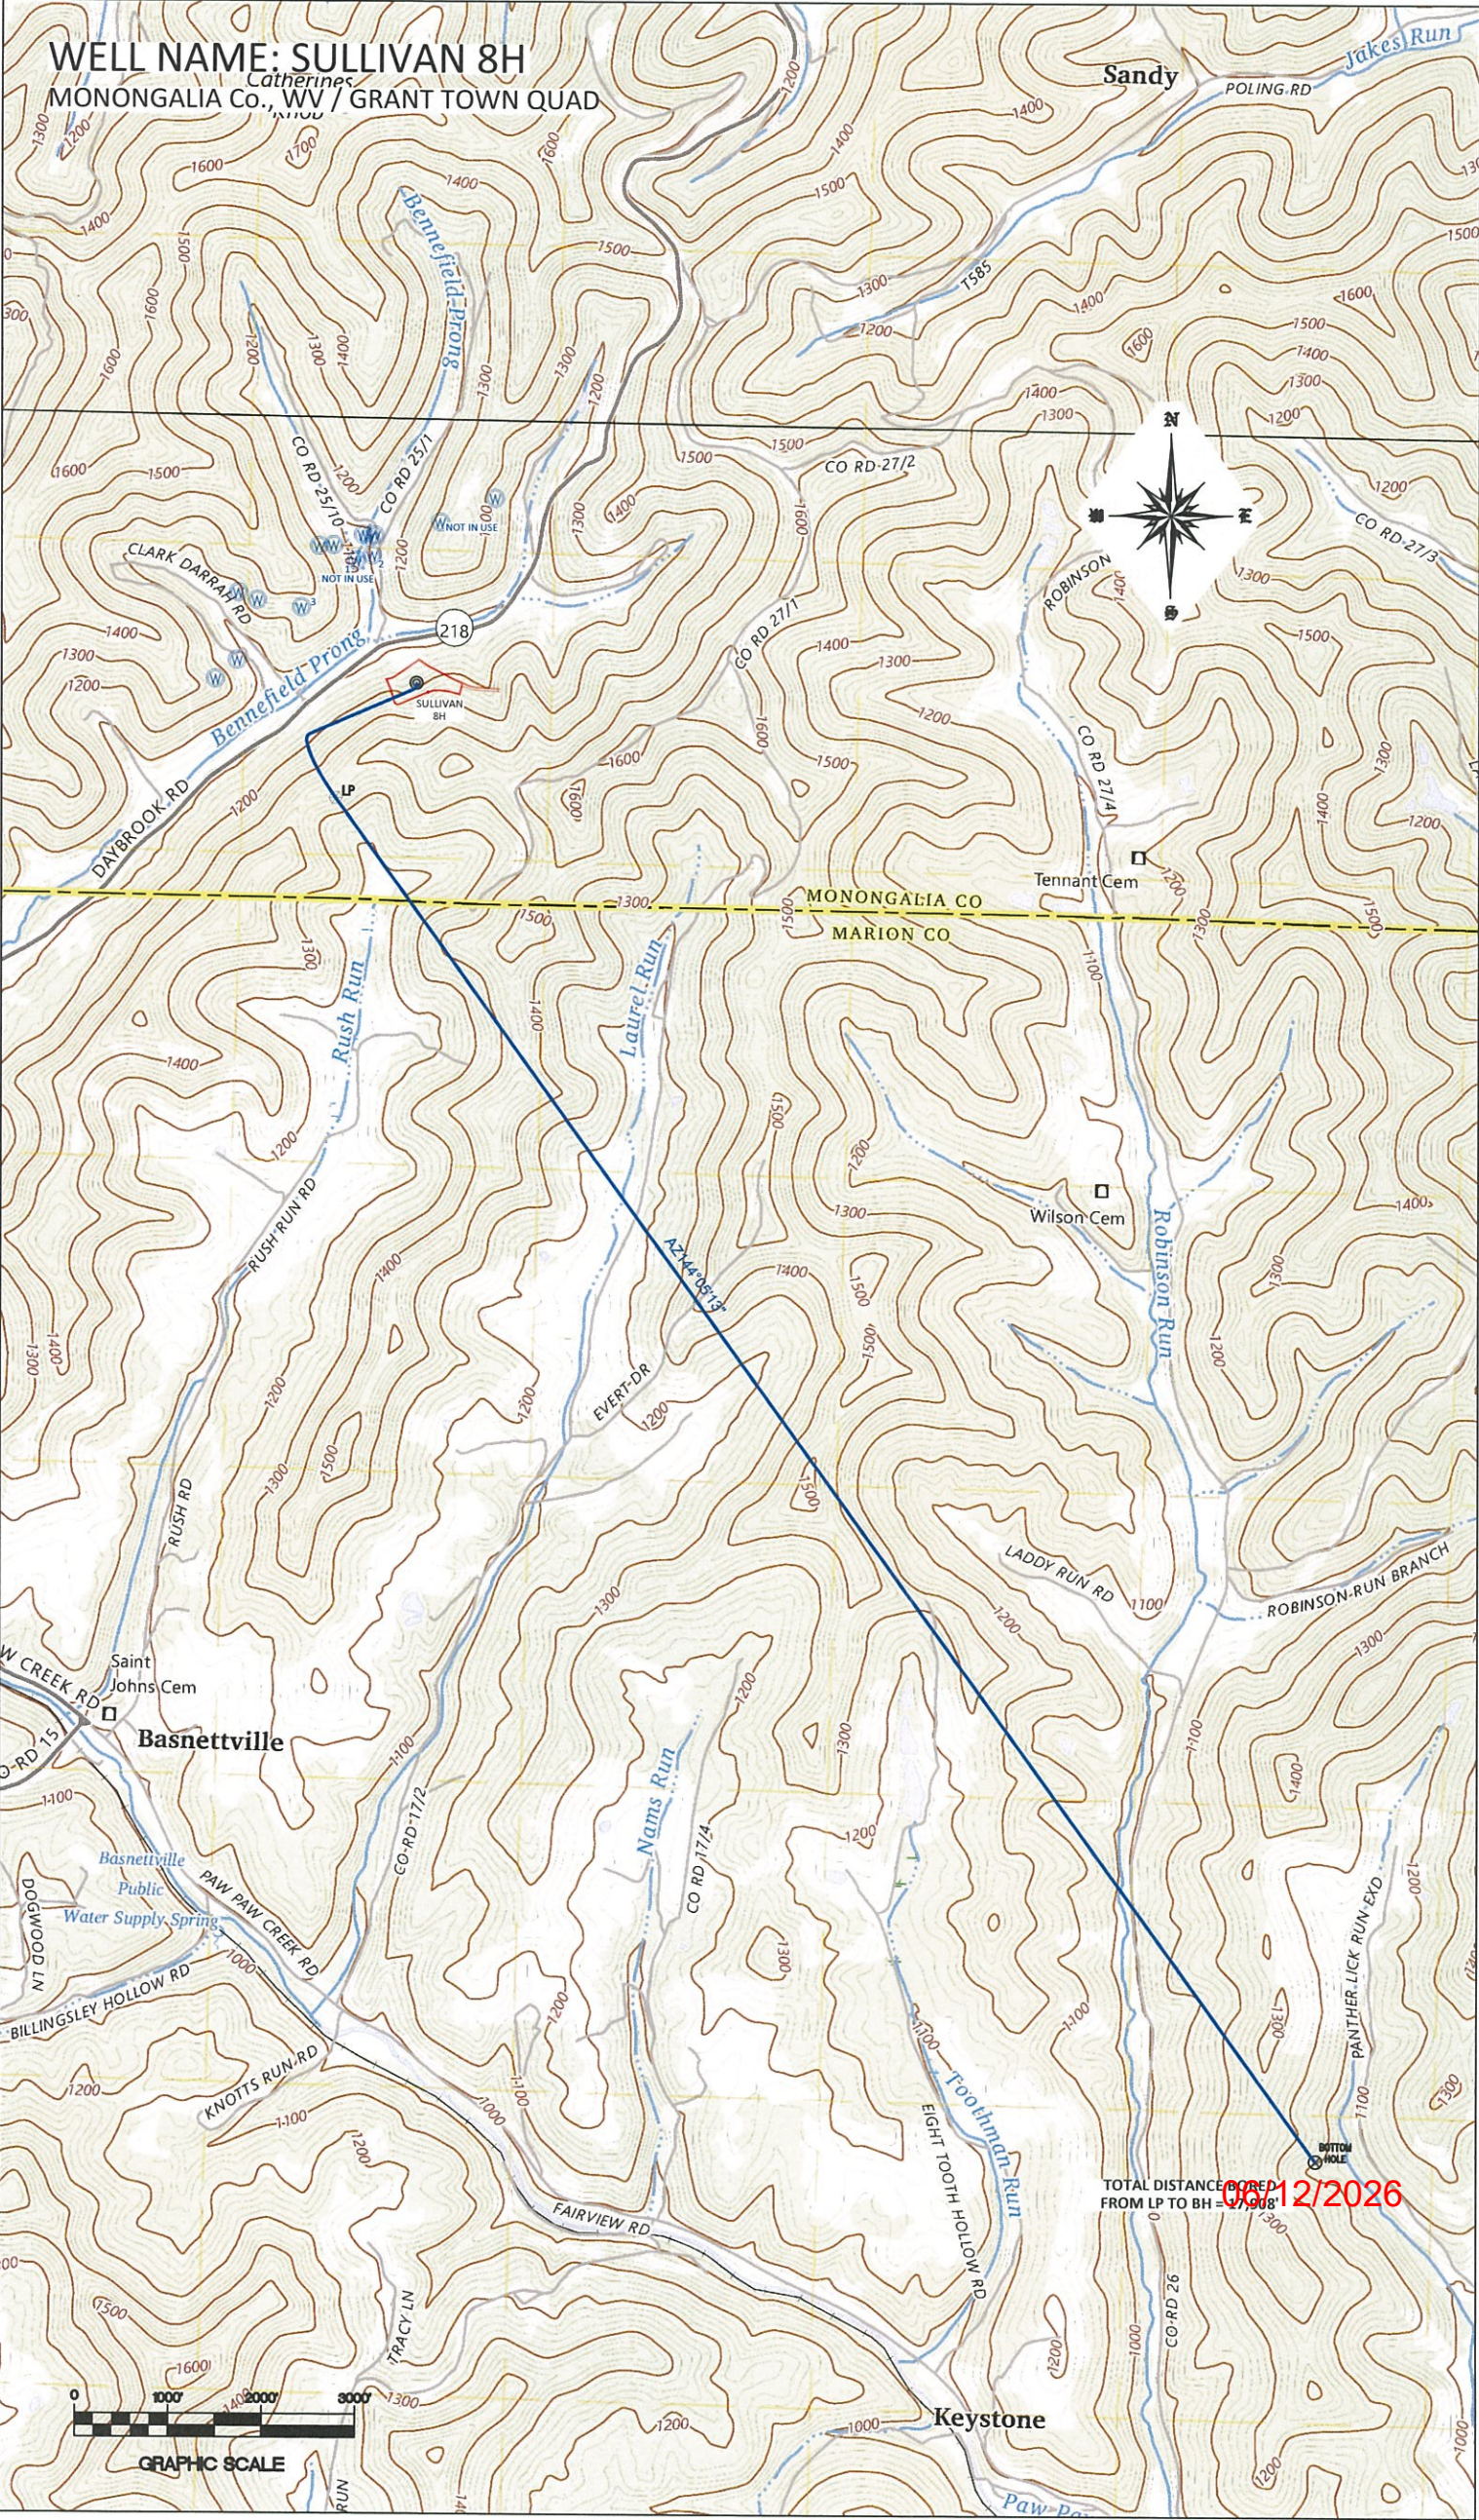

TOTAL DISTANCE MEASURED
FROM LP TO BH = 0.18
08/12/2026

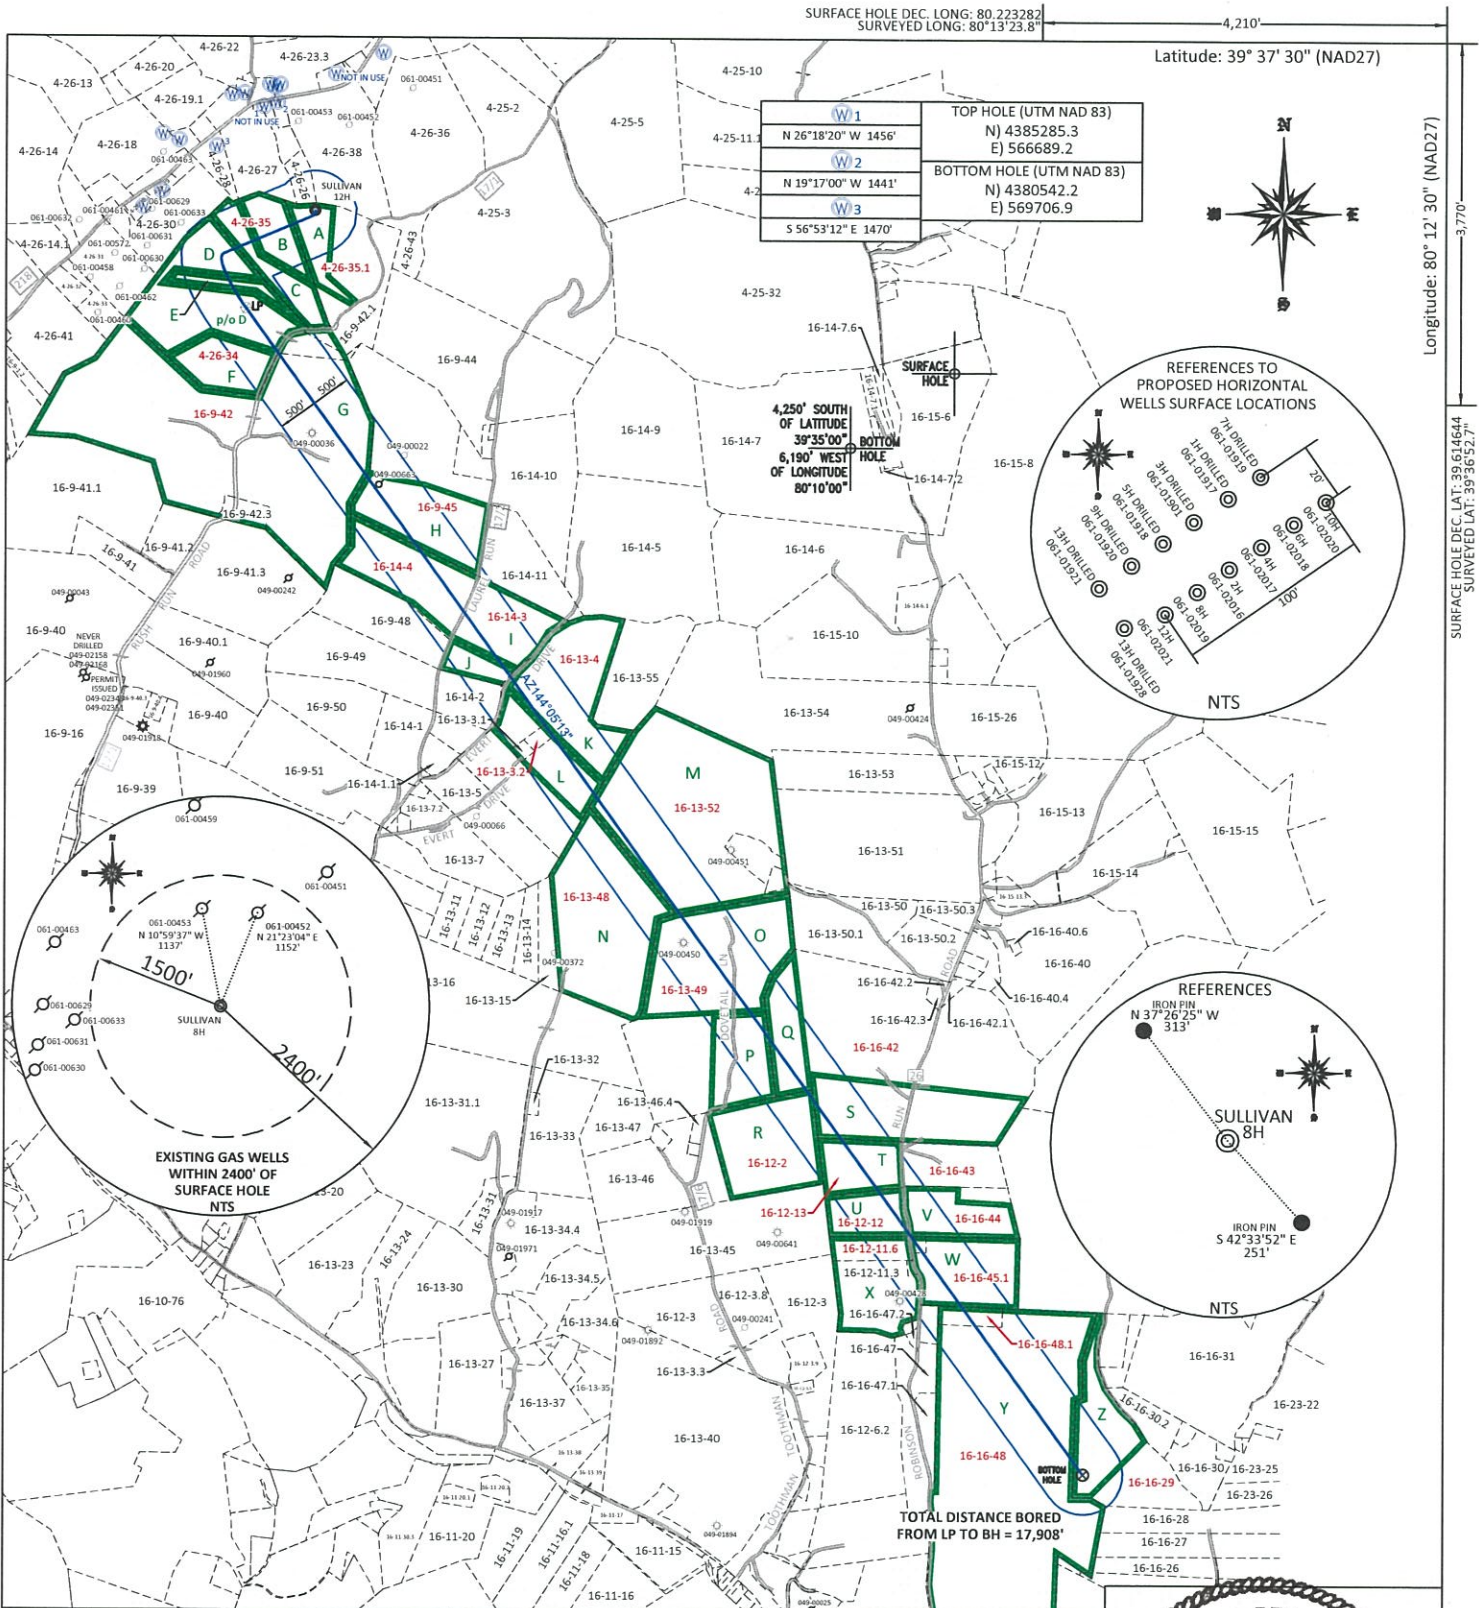

FILE #: NNE25

DRAWING #: 4138

SCALE: PLAT: 1" = 2400'
TICK MARK: 1" = 2000'


MINIMUM DEGREE OF ACCURACY: 1/200

PROVEN SOURCE SUBMETER MAPPING
OF ELEVATION: GRADE GPS

I, THE UNDERSIGNED, HEREBY CERTIFY THAT THIS PLAT IS CORRECT TO THE BEST OF MY KNOWLEDGE AND BELIEF AND SHOWS ALL THE INFORMATION REQUIRED BY LAW AND THE REGULATIONS ISSUED AND PRESCRIBED BY THE DEPARTMENT OF ENVIRONMENTAL PROTECTION.

Signed:

L.L.S. #2124 : Ernest J. Benchek III

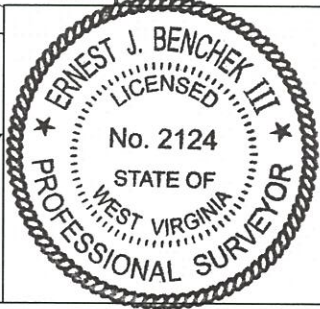

(+) DENOTES LOCATION OF WELL ON UNITED STATES TOPOGRAPHIC MAPS WVDEP

OFFICE OF OIL & GAS
601 57TH STREET
CHARLESTON, WV 25304

Well Type: ☐ Oil ☐ Waste Diposal ☐ Production ☐ Deep
☒ Gas ☐ Liquid Injection ☐ Storage ☒ Shallow

WATERSHED: UPPER MONONGAHELA RIVER

COUNTY/DISTRICT: MONONGALIA / CLAY

SURFACE OWNER: ALAN SULLIVAN

OIL & GAS ROYALTY OWNER: James T. McClimans, et al

LEASE NUMBERS:

DATE: JUNE 10, 2026

OPERATOR'S WELL #: SULLIVAN 8H

API WELL #: 47 61 02019
STATE COUNTY PERMIT

AS-BUILT ELEVATION: 1,476.7'

QUADRANGLE: GRANT TOWN

ACREAGE: 1036.493 +/-

ACREAGE: 25.870 +/-

DRILL ☒ CONVERT ☐ DRILL DEEPER ☐ REDRILL ☐ FRACTURE OR STIMULATE ☒
PLUG OFF FORMATION ☐ PERFORATE NEW FORMATION ☐ PLUG & ABANDON ☐
CLEAN OUT & REPLUG ☐ OTHER CHANGE ☐ (SPECIFY):

TARGET FORMATION: MARCELLUS

ESTIMATED DEPTH: TVD: 8,082' TMD: 26,564'

WELL OPERATOR: NORTHEAST NATURAL ENERGY LLC

DESIGNATED AGENT: John Adams

ADDRESS: 707 VIRGINIA STREET EAST, SUITE 1200

ADDRESS: 707 VIRGINIA STREET EAST, SUITE 1200

CITY: CHARLESTON STATE: WV ZIP CODE: 25301

CITY: CHARLESTON STATE: WV ZIP CODE: 25301

06/12/2026

	PROPERTY OWNER INDEX
4-26-35.1	ALAN SULLIVAN
4-26-35	JAMES LOUIS DOUKAS
4-26-34	SHIRLEY J NEELY, DEANNA M FRAZIER, DONNA J WALDEN & DARRIN NEELY
16-9-42	JAMES P & URSULA A MCDONALD
16-9-45	TODD E KATZNER & ERIN E ESTELL KATZNER
16-14-4	WILLIAM J & SARAH E EDDY
16-14-3	RODNEY R & KEPPEK K MARTIN
16-13-4	BRAD N SOMMER (LEASE 1298-554 KID NATION)
16-13-3.2	EMILY A FOLEY
16-13-52	JAMES & JOYCE GANDY
16-13-48	ELECTIC LODGE # 67 I O O F OF FARMINGTON
16-13-49	DAVID L PRICE JR & ANDREA L PRICE
16-16-42	THOMAS A OR COLLEEN J WEAKS
16-12-2	BRENDA HOLGUIN ARGANO
16-12-13	CHARLES D CLELLAND
16-12-12	CHARLES D & KIMBERLY K CLELLAND
16-16-44	PAMELA R HARRIS (LIFE WB 121-554)
16-16-45.2	BRIAN & MICHELE MCHUGH
16-12-11.6	TAMMI A BLAKE
16-16-45.1	PAUL W & PATRICIA S REESE
16-16-48.1	JAMES S ICE
16-16-48	JAMES S ICE
16-16-29	LUCINDA FURBEE & MARK KING

	LEASE INDEX		
A	WV-061-006979-002	N	WV-049-107328-001
B	WV-061-006176-001	O	WV-049-107186-001
C	WV-061-006172-001	P	WV-049-105431-003
D	WV-061-006172-001	Q	WV-049-106130-001
E	WV-061-006413-040	R	WV-049-106859-003
F	WV-061-006238-001	S	WV-049-106130-001
G	WV-061-00219-001	T	WV-061-00219-001
H	WV-049-106922-014	U	WV-061-00219-001
I	WV-049-106904-001	V	WV-061-00219-001
J	WV-049-106904-001	W	WV-061-00219-001
K	WV-061-00219-001	X	WV-061-00219-001
L	WV-049-106827-001	Y	WV-049-007441-001
M	WV-049-107186-001	Z	WV-049-007661-001

06/12/2026

FILE #:	NNE20	DATE:	JUNE 10, 2026
DRAWING #:	4138	OPERATOR'S WELL #:	SULLIVAN 8H
SCALE:	N/A	API WELL #:	47 61 02019 STATE COUNTY PERMIT