



RECEIVED  
Office of Oil and Gas  
CT 312  
WV Department of  
Environmental Protection

WELL NAME: SULLIVAN 10H  
GRANT TOWN, WV


TOTAL DISTANCE BORED  
FROM LP TO BH = 346'  
AZ144°05'13" 500'



12/05/2025



GRAPHIC SCALE

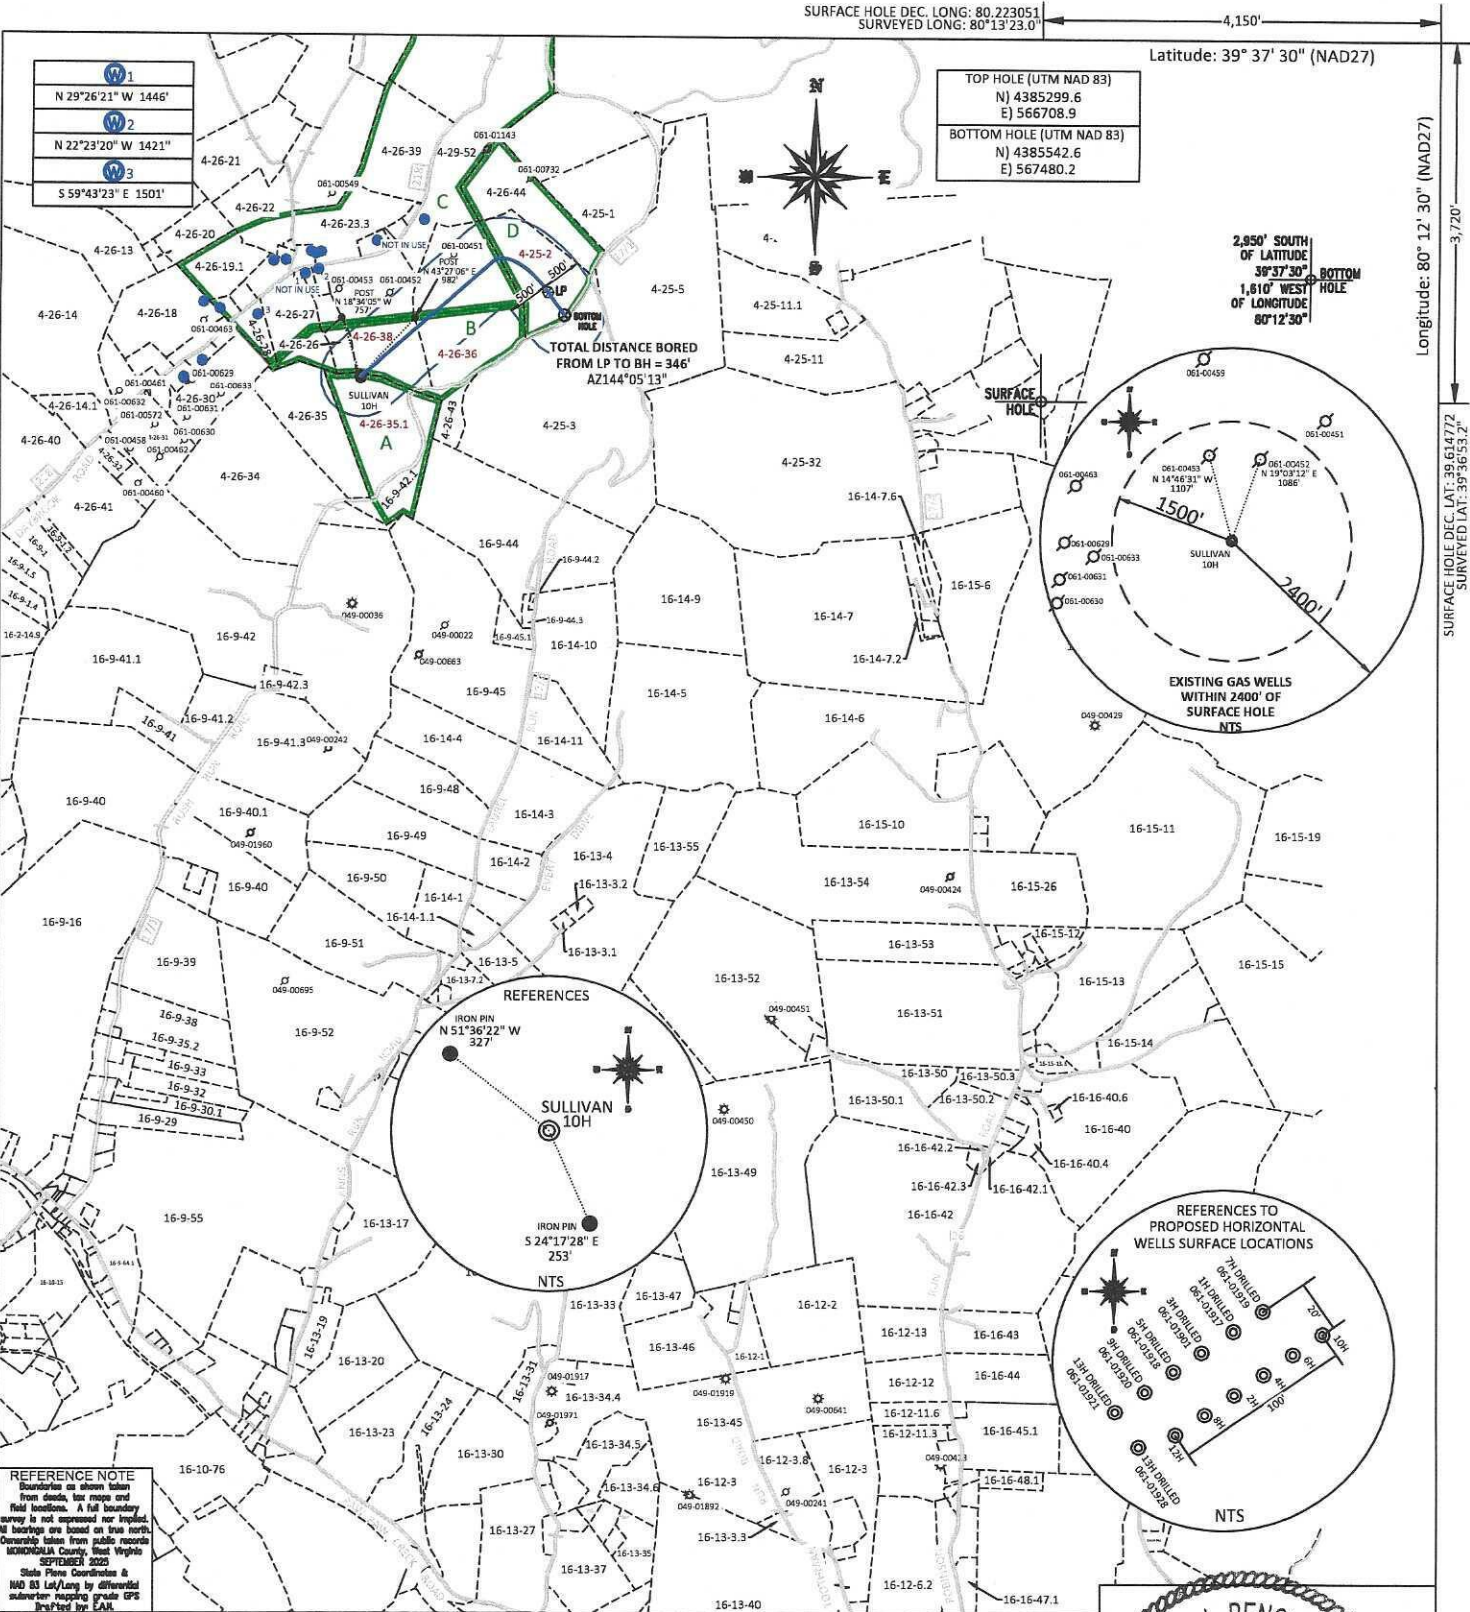

(+) DENOTES LOCATION OF WELL ON UNITED STATES TOPOGRAPHIC MAPS WYDEP

OFFICE OF OIL & GAS  
601 57TH STREET  
CHARLESTON, WV 25304

Well Type: ☐ Oil ☐ Waste Diposal ☐ Production ☐ Deep  
☒ Gas ☐ Liquid Injection ☐ Storage ☒ Shallow

WATERSHED: UPPER MONONGAHELA RIVER

COUNTY/DISTRICT: MONONGALIA / CLAY

SURFACE OWNER: ALAN SULLIVAN

OIL & GAS ROYALTY OWNER: ALAN SULLIVAN

LEASE NUMBERS:

DATE: OCTOBER 13, 2025

OPERATOR'S WELL #: SULLIVAN 10H

API WELL #: 47 061 02020  
STATE COUNTY PERMIT

AS-BUILT ELEVATION: 1,476.7'

QUADRANGLE: GRANT TOWN

ACREAGE: 347.497 +/-

ACREAGE: 25.870 +/-

DRILL ☒ CONVERT ☐ DRILL DEEPER ☐ REDRILL ☐ FRACTURE OR STIMULATE ☒  
PLUG OFF FORMATION ☐ PERFORATE NEW FORMATION ☐ PLUG & ABANDON ☐  
CLEAN OUT & REPLUG ☐ OTHER CHANGE ☐ (SPECIFY):

TARGET FORMATION: MARCELLUS

WELL OPERATOR: NORTHEAST NATURAL ENERGY LLC

ADDRESS: 707 VIRGINIA STREET EAST, SUITE 1200

CITY: CHARLESTON STATE: WV ZIP CODE: 25301

ESTIMATED DEPTH: TVD: 8,082' TMD: 9,429'

DESIGNATED AGENT: JOHN ADAMS

ADDRESS: 707 VIRGINIA STREET EAST, SUITE 1200

CITY: CHARLESTON STATE: WV ZIP CODE: 25301

|           | PROPERTY OWNER INDEX             |
|-----------|----------------------------------|
| 4-26-35.1 | ALAN SULLIVAN                    |
| 4-26-38   | ADAM CLAY DARRAH                 |
| 4-26-36   | LARRY NOLAN & LINDA MAE PAYTON   |
| 4-25-2    | ORVILLE W BELL JR & RENEE D LOAR |

|   | LEASE INDEX       |
|---|-------------------|
| A | WV-061-005448-002 |
| B | WV-061-005256-001 |
| C | WV-061-005256-001 |
| D | WV-061-005961-002 |

12/05/2025

|                                                                                                                                 |                                                                                                                                                                                                              |
|---------------------------------------------------------------------------------------------------------------------------------|--------------------------------------------------------------------------------------------------------------------------------------------------------------------------------------------------------------|
| FILE #: <u>          NNE25          </u><br>DRAWING #: <u>          4160          </u><br>SCALE: <u>          N/A          </u> | DATE: <u>          OCTOBER 13, 2025          </u><br>OPERATOR'S WELL #: <u>          SULLIVAN 10H          </u><br>API WELL #: <u>  47  </u> <u>  061  </u> <u>  02020  </u><br><div>STATECOUNTYPERMIT</div> |
|---------------------------------------------------------------------------------------------------------------------------------|--------------------------------------------------------------------------------------------------------------------------------------------------------------------------------------------------------------|