



WELL NAME: SULLIVAN 12H
Catherine's
MONONGALIA Co., WV / GRANT TOWN QUAD

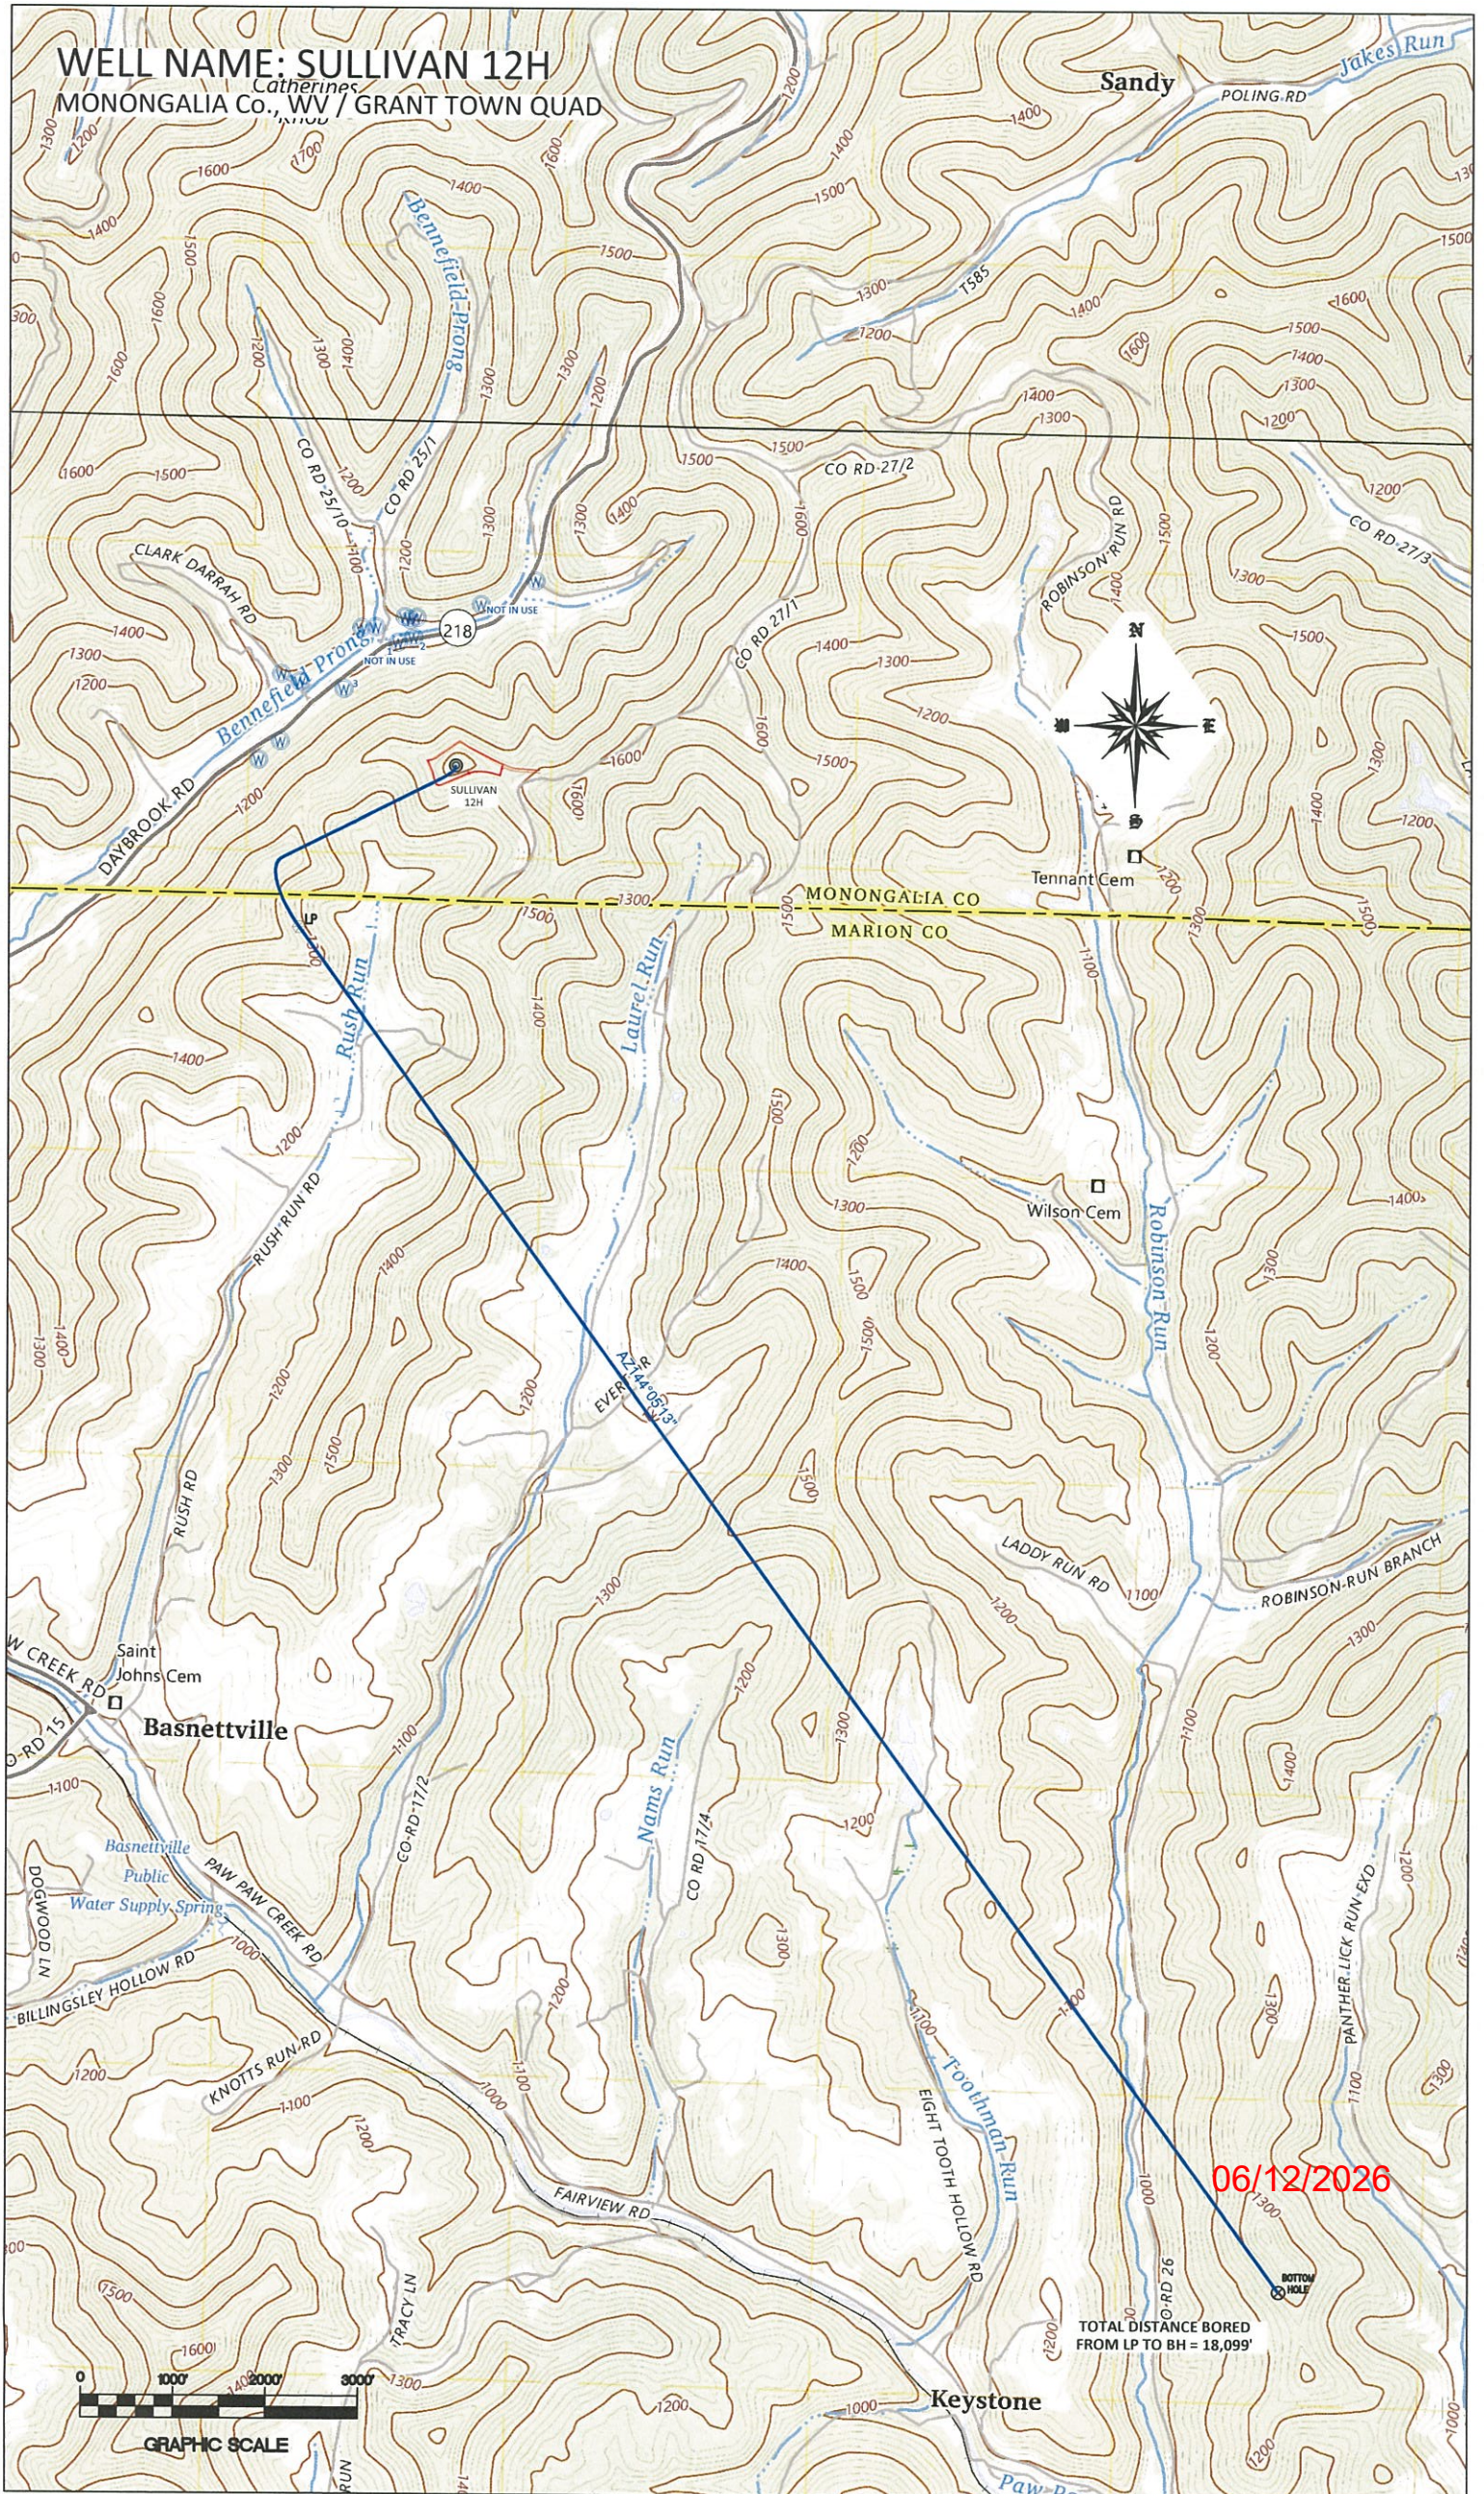

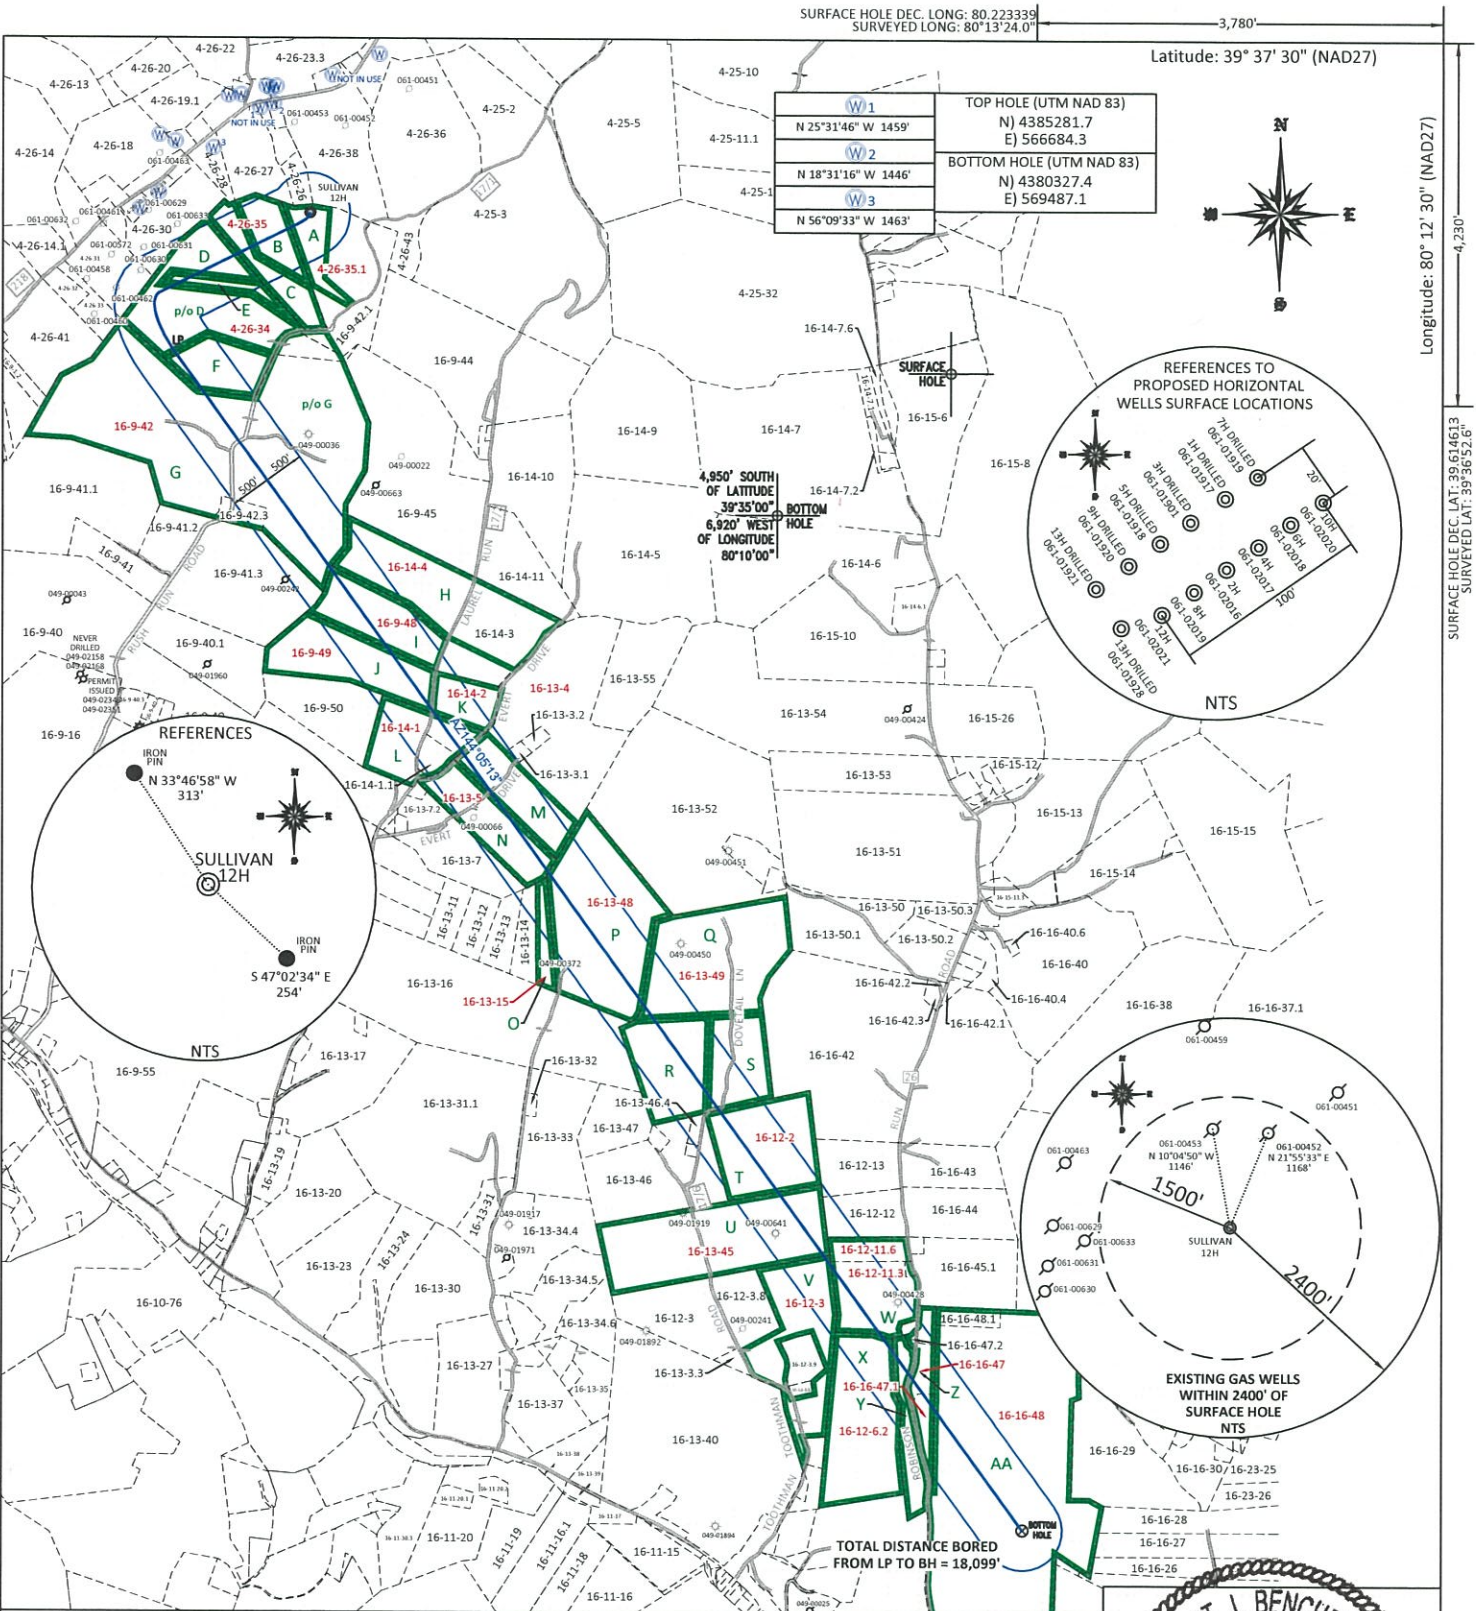

FILE #: NNE25
DRAWING #: 4137
SCALE: PLAT: 1" = 2400'
TICK MARK: 1" = 2000'
MINIMUM DEGREE OF ACCURACY: 1/200
PROVEN SOURCE SUBMETER MAPPING OF ELEVATION: GRADE GPS

I, THE UNDERSIGNED, HEREBY CERTIFY THAT THIS PLAT IS CORRECT TO THE BEST OF MY KNOWLEDGE AND BELIEF AND SHOWS ALL THE INFORMATION REQUIRED BY LAW AND THE REGULATIONS ISSUED AND PRESCRIBED BY THE DEPARTMENT OF ENVIRONMENTAL PROTECTION.

Signed:

L.L.S. #2124 : Ernest J. Benchek III



(+) DENOTES LOCATION OF WELL ON UNITED STATES TOPOGRAPHIC MAPS
WVDEP
OFFICE OF OIL & GAS
601 57TH STREET
CHARLESTON, WV 25304

Well Type: ☐ Oil ☐ Waste Diposal ☐ Production ☐ Deep
☒ Gas ☐ Liquid Injection ☐ Storage ☒ Shallow

WATERSHED: UPPER MONONGAHELA RIVER

COUNTY/DISTRICT: MONONGALIA / CLAY

SURFACE OWNER: ALAN SULLIVAN

OIL & GAS ROYALTY OWNER: James T. McClimans, et al

LEASE NUMBERS:

DATE: JUNE 10, 2026

OPERATOR'S WELL #: SULLIVAN 12H

API WELL #: 47 61 02021
STATE COUNTY PERMIT

AS-BUILT ELEVATION: 1,476.7'

QUADRANGLE: GRANT TOWN

ACREAGE: 1014.479 +/-

ACREAGE: 25.870 +/-

06/12/2026

DRILL ☒ CONVERT ☐ DRILL DEEPER ☐ REDRILL ☐ FRACTURE OR STIMULATE ☒
PLUG OFF FORMATION ☐ PERFORATE NEW FORMATION ☐ PLUG & ABANDON ☐
CLEAN OUT & REPLUG ☐ OTHER CHANGE ☐ (SPECIFY):

TARGET FORMATION: MARCELLUS

WELL OPERATOR: NORTHEAST NATURAL ENERGY LLC

ADDRESS: 707 VIRGINIA STREET EAST, SUITE 1200

CITY: CHARLESTON STATE: WV ZIP CODE: 25301

ESTIMATED DEPTH: TVD: 8,082' TMD: 27,043'

DESIGNATED AGENT: John Adams

ADDRESS: 707 VIRGINIA STREET EAST, SUITE 1200

CITY: CHARLESTON STATE: WV ZIP CODE: 25301

	PROPERTY OWNER INDEX
4-26-35.1	ALAN SULLIVAN
4-26-35	JAMES LOUIS DOUKAS
4-26-34	SHIRLEY J NEELY, DEANNA M FRAZIER, DONNA J WALDEN & DARRIN NEELY
16-9-42	JAMES P & URSULA A MCDONALD
16-14-4	WILLIAM J & SARAH E EDDY
16-9-48	WILLIAM J & SARAH E EDDY
16-9-49	LOIS I & WASHINGTON L LOUGH
16-14-2	LOIS I & WASHINGTON L LOUGH (LIFE 1179-678)
16-14-1	LOIS I & WASHINGTON L LOUGH (LIFE 1179-678)
16-13-4	BRAD N SOMMER (LEASE 1298-554 KID NATION)
16-13-5	MICHAEL D & TAMI E SHAW
16-13-48	ELECTIC LODGE # 67 I O O F OF FARMINGTON
16-13-15	MYRTLE MOORE
16-13-49	DAVID L PRICE JR & ANDREA L PRICE
16-12-2	BRENDA HOLGUIN ARGANO
16-13-45	EDYTHE D TENNANT (3/5 INT) & CARL W MCCUE (LIFE
16-12-11.6	TAMMI A BLAKE
16-12-3	DONALD G HAUGHT JR TRS OF ALDEAN HAUGHT IRREVOCABLE
16-12-11.3	RUSSELL L CRAIG & KRISTEN L NUZUM-CRAIG
16-12-6.2	CHARLES E & GLENDA V CRAIG
16-16-47.1	MICHAEL C & CAROL L PHILLIPS
16-16-47	ROBERT G OR CARMEN L HIGGINS
16-16-48	JAMES S ICE

	LEASE INDEX		
A	WV-061-006979-002	O	WV-049-107328-001
B	WV-061-006176-001	P	WV-049-107328-001
C	WV-061-006172-001	Q	WV-049-107186-001
D	WV-061-006172-001	R	WV-049-106812-002
E	WV-061-006413-040	S	WV-049-105431-003
F	WV-061-006238-001	T	WV-049-106859-003
G	WV-061-00219-001	U	WV-061-00219-001
H	WV-049-106904-001	V	WV-049-106791-001
I	WV-049-106926-009	W	WV-061-00219-001
J	WV-049-106926-009	X	WV-049-106533-002
K	WV-049-107012-001	Y	WV-049-107362-001
L	WV-049-107012-001	Z	WV-049-106950-001
M	WV-061-00219-001	AA	WV-049-007441-001
N	WV-049-104884-002		

06/12/2026

FILE #: <u>NNE20</u>	DATE: <u>JUNE 10, 2026</u>
DRAWING #: <u>4137</u>	OPERATOR'S WELL #: <u>SULLIVAN 12H</u>
SCALE: <u>N/A</u>	API WELL #: <u>47</u> <u>61</u> <u>02021</u> STATE COUNTY PERMIT