


WELL NAME: GREEN LAKES 3H
MONONGALIA CO., WV / GRANT TOWN QUAD



Behler

Eddy
Chapel Cem

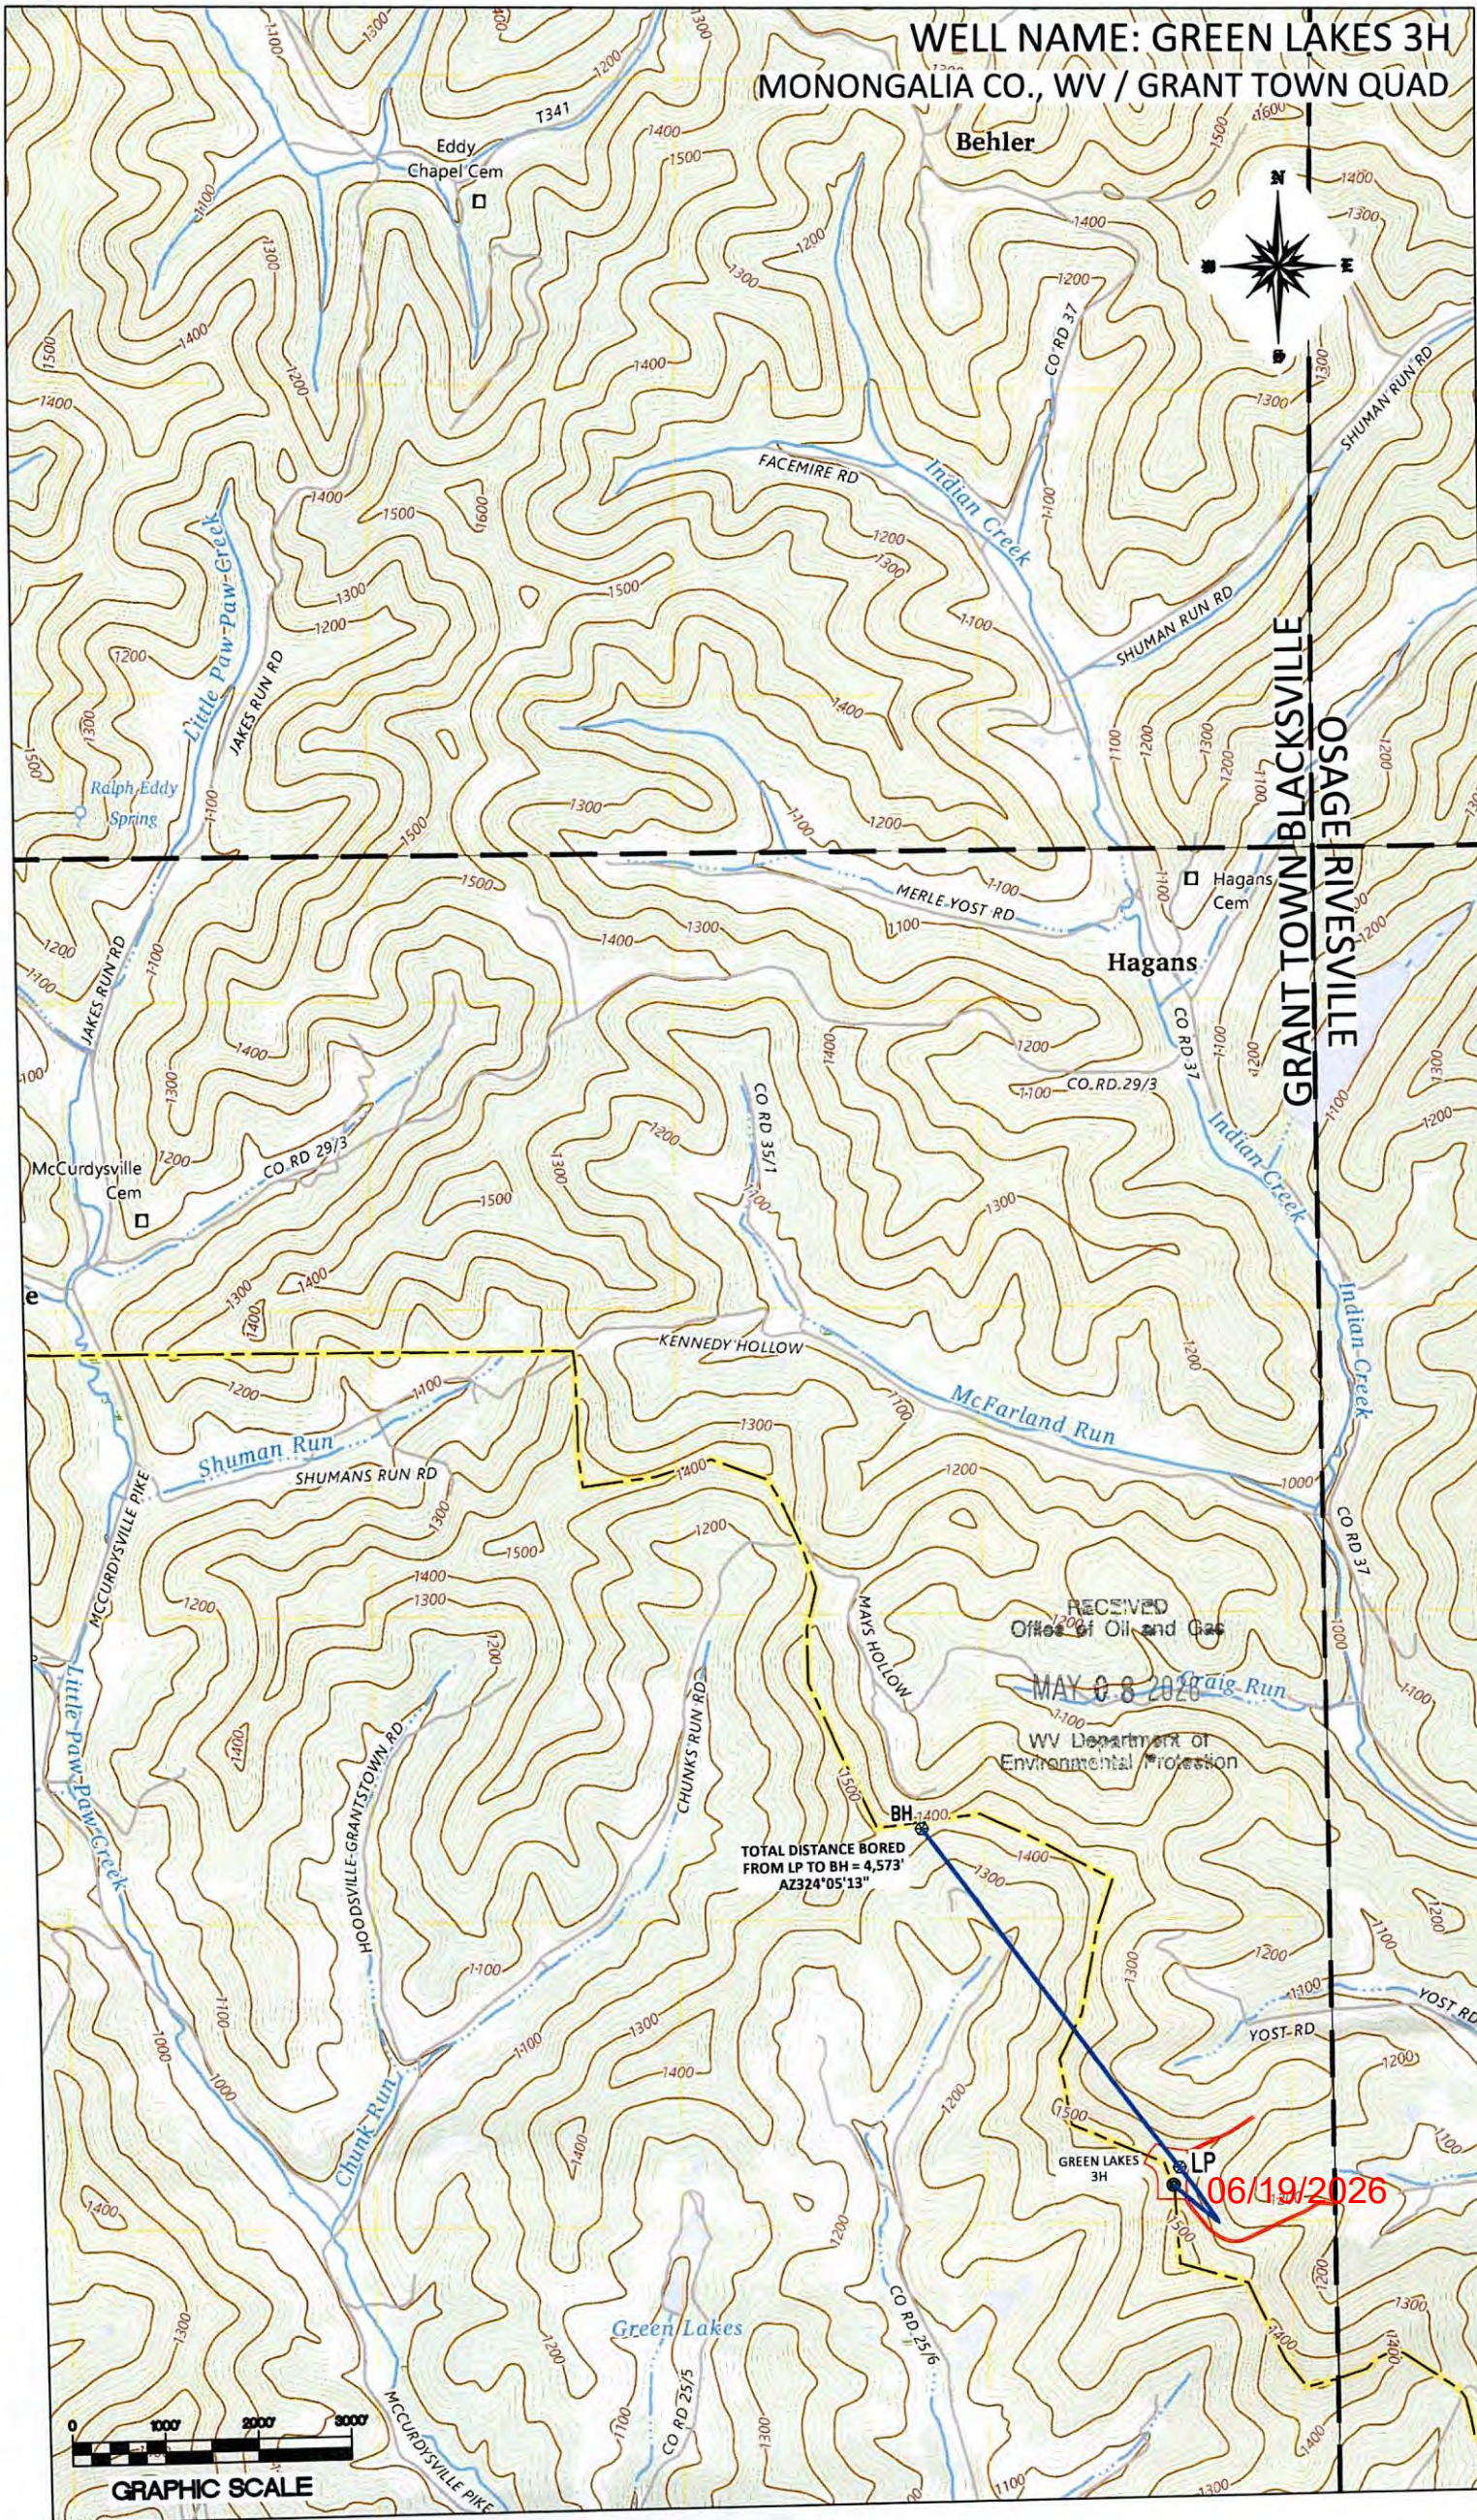

GRANT TOWN
BLACKSVILLE
OSAGE RIVERVILLE

Hagans


McCurdyville
Cem

RECEIVED
Office of Oil and Gas
MAY 08 2026
WV Department of
Environmental Protection


TOTAL DISTANCE BORED
FROM LP TO BH = 4,573'
AZ324°05'13"

GREEN LAKES
3H

06/19/2026

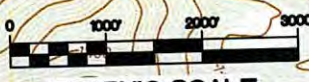


GRAPHIC SCALE

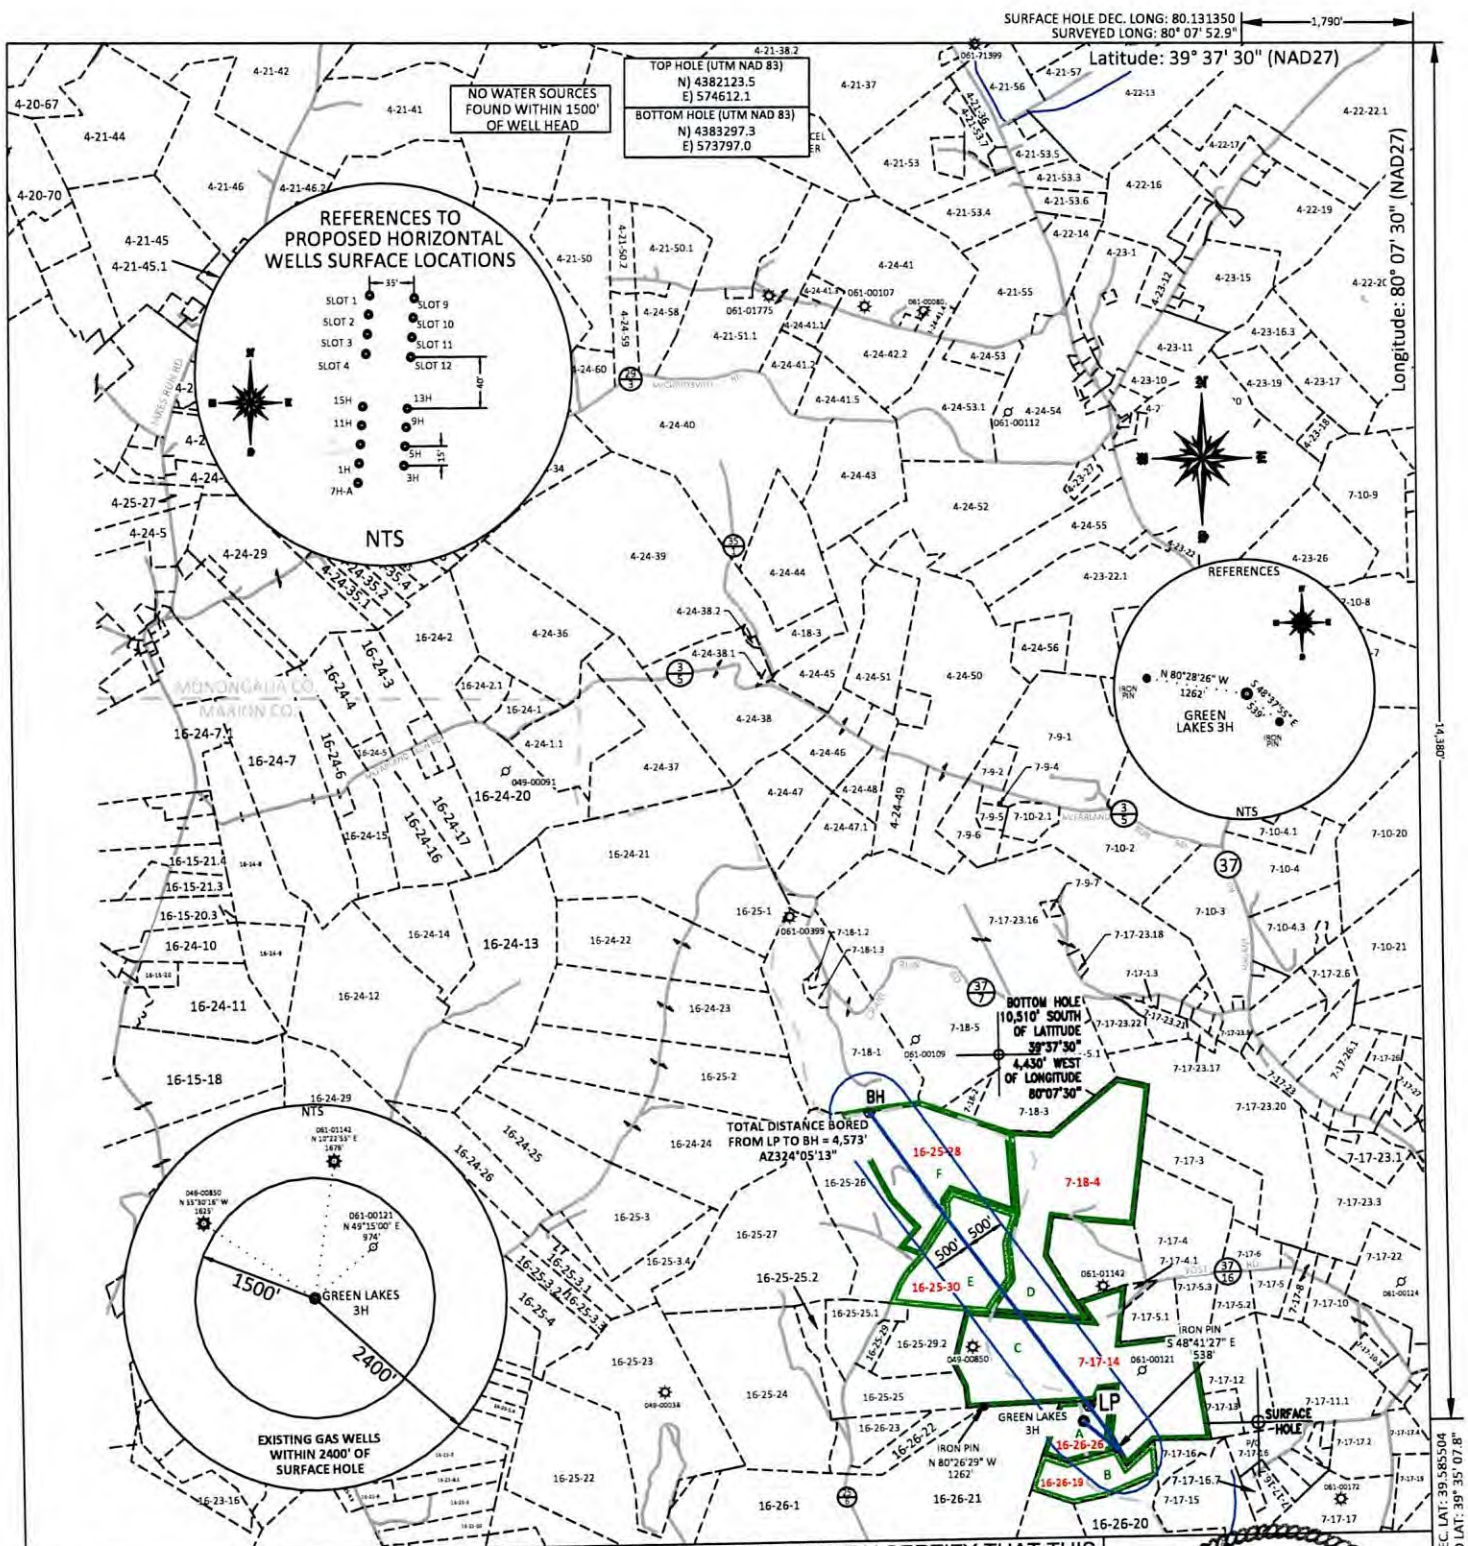

FILE #: NNE20
DRAWING #: 4189
SCALE: PLAT: 1" = 2400'
TICK: 1" = 2000'
MINIMUM DEGREE OF ACCURACY: 1/200
PROVEN SOURCE OF ELEVATION: SUBMETER MAPPING GRADE GPS

I, THE UNDERSIGNED, HEREBY CERTIFY THAT THIS PLAT IS CORRECT TO THE BEST OF MY KNOWLEDGE AND BELIEF AND SHOWS ALL THE INFORMATION REQUIRED BY LAW AND THE REGULATIONS ISSUED AND PRESCRIBED BY THE DEPARTMENT OF ENVIRONMENTAL PROTECTION.

Signed:
L.L.S. #2124 : Ernest J. Benckek III

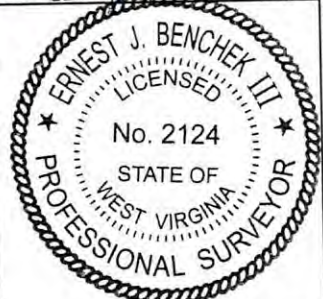

(+) DENOTES LOCATION OF WELL ON UNITED STATES TOPOGRAPHIC MAPS WVDEP
OFFICE OF OIL & GAS
601 57TH STREET
CHARLESTON, WV 25304

Well Type: ☐ Oil ☐ Waste Disposal ☐ Production ☐ Deep
☒ Gas ☐ Liquid Injection ☐ Storage ☒ Shallow

WATERSHED: Upper Monongahela River
COUNTY/DISTRICT: MONONGALIA CO., GRANT DISTRICT / MARION CO., PAW PAW DISTRICT
SURFACE OWNER: MINISTERS RUN PROPERTY MANAGEMENT LLC
OIL & GAS ROYALTY OWNER:
LEASE NUMBERS:

DATE: APRIL 29, 2026
OPERATOR'S WELL #: GREEN LAKES 3H
API WELL #: 47 D61 D2040
STATE COUNTY PERMIT
AS-BUILT ELEVATION: 1,448.7'
QUADRANGLE: GRANT TOWN
ACREAGE: 273.68 +/-
ACREAGE: 13.56

DRILL ☒ CONVERT ☐ DRILL DEEPER ☐ REDRILL ☐ FRACTURE OR STIMULATE ☒
PLUG OFF FORMATION ☐ PERFORATE NEW FORMATION ☐ PLUG & ABANDON ☐
CLEAN OUT & REPLUG ☐ OTHER CHANGE ☐ (SPECIFY):
TARGET FORMATION: MARCELLUS
WELL OPERATOR: NORTHEAST NATURAL ENERGY LLC
ADDRESS: 707 VIRGINIA STREET EAST, SUITE 1200
CITY: CHARLESTON STATE: WV ZIP CODE: 25301
ESTIMATED DEPTH: TVD: 8050' TMD: 13,075'
DESIGNATED AGENT: John Adams
ADDRESS: 707 VIRGINIA STREET EAST, SUITE 1200
CITY: CHARLESTON STATE: WV ZIP CODE: 25301

	PROPERTY INDEX
16-26-26	MINISTERS RUN PROPERTY MANAGEMENT LLC
16-26-19	GARY W DAYTON
7-17-14	MINISTERS RUN PROPERTY MANAGEMENT LLC
16-25-30	CALVIN F PLYMALE
7-18-4	THOMAS G CROFTCHECK
16-25-18	GEORGE J & ALICE M LEMLEY

	LEASE INDEX
A	WV-049-106675-001
B	WV-049-106358-001
C	WV-049-106675-001
D	WV-061-107144-001
E	WV-049-106637-005
F	WV-049-106637-001

RECEIVED
Office of Oil and Gas

MAY 08 2026

WV Department of
Environmental Protection

06/19/2026

FILE #: NEE20	DATE: APRIL 29, 2026
DRAWING #: 4189	OPERATOR'S WELL #: GREEN LAKES 3H
SCALE: N/A	API WELL #: 47 0601 02040 STATE COUNTY PERMIT