


WELL NAME: GREEN LAKES 13H
MONONGALIA CO., WV / GRANT TOWN QUAD

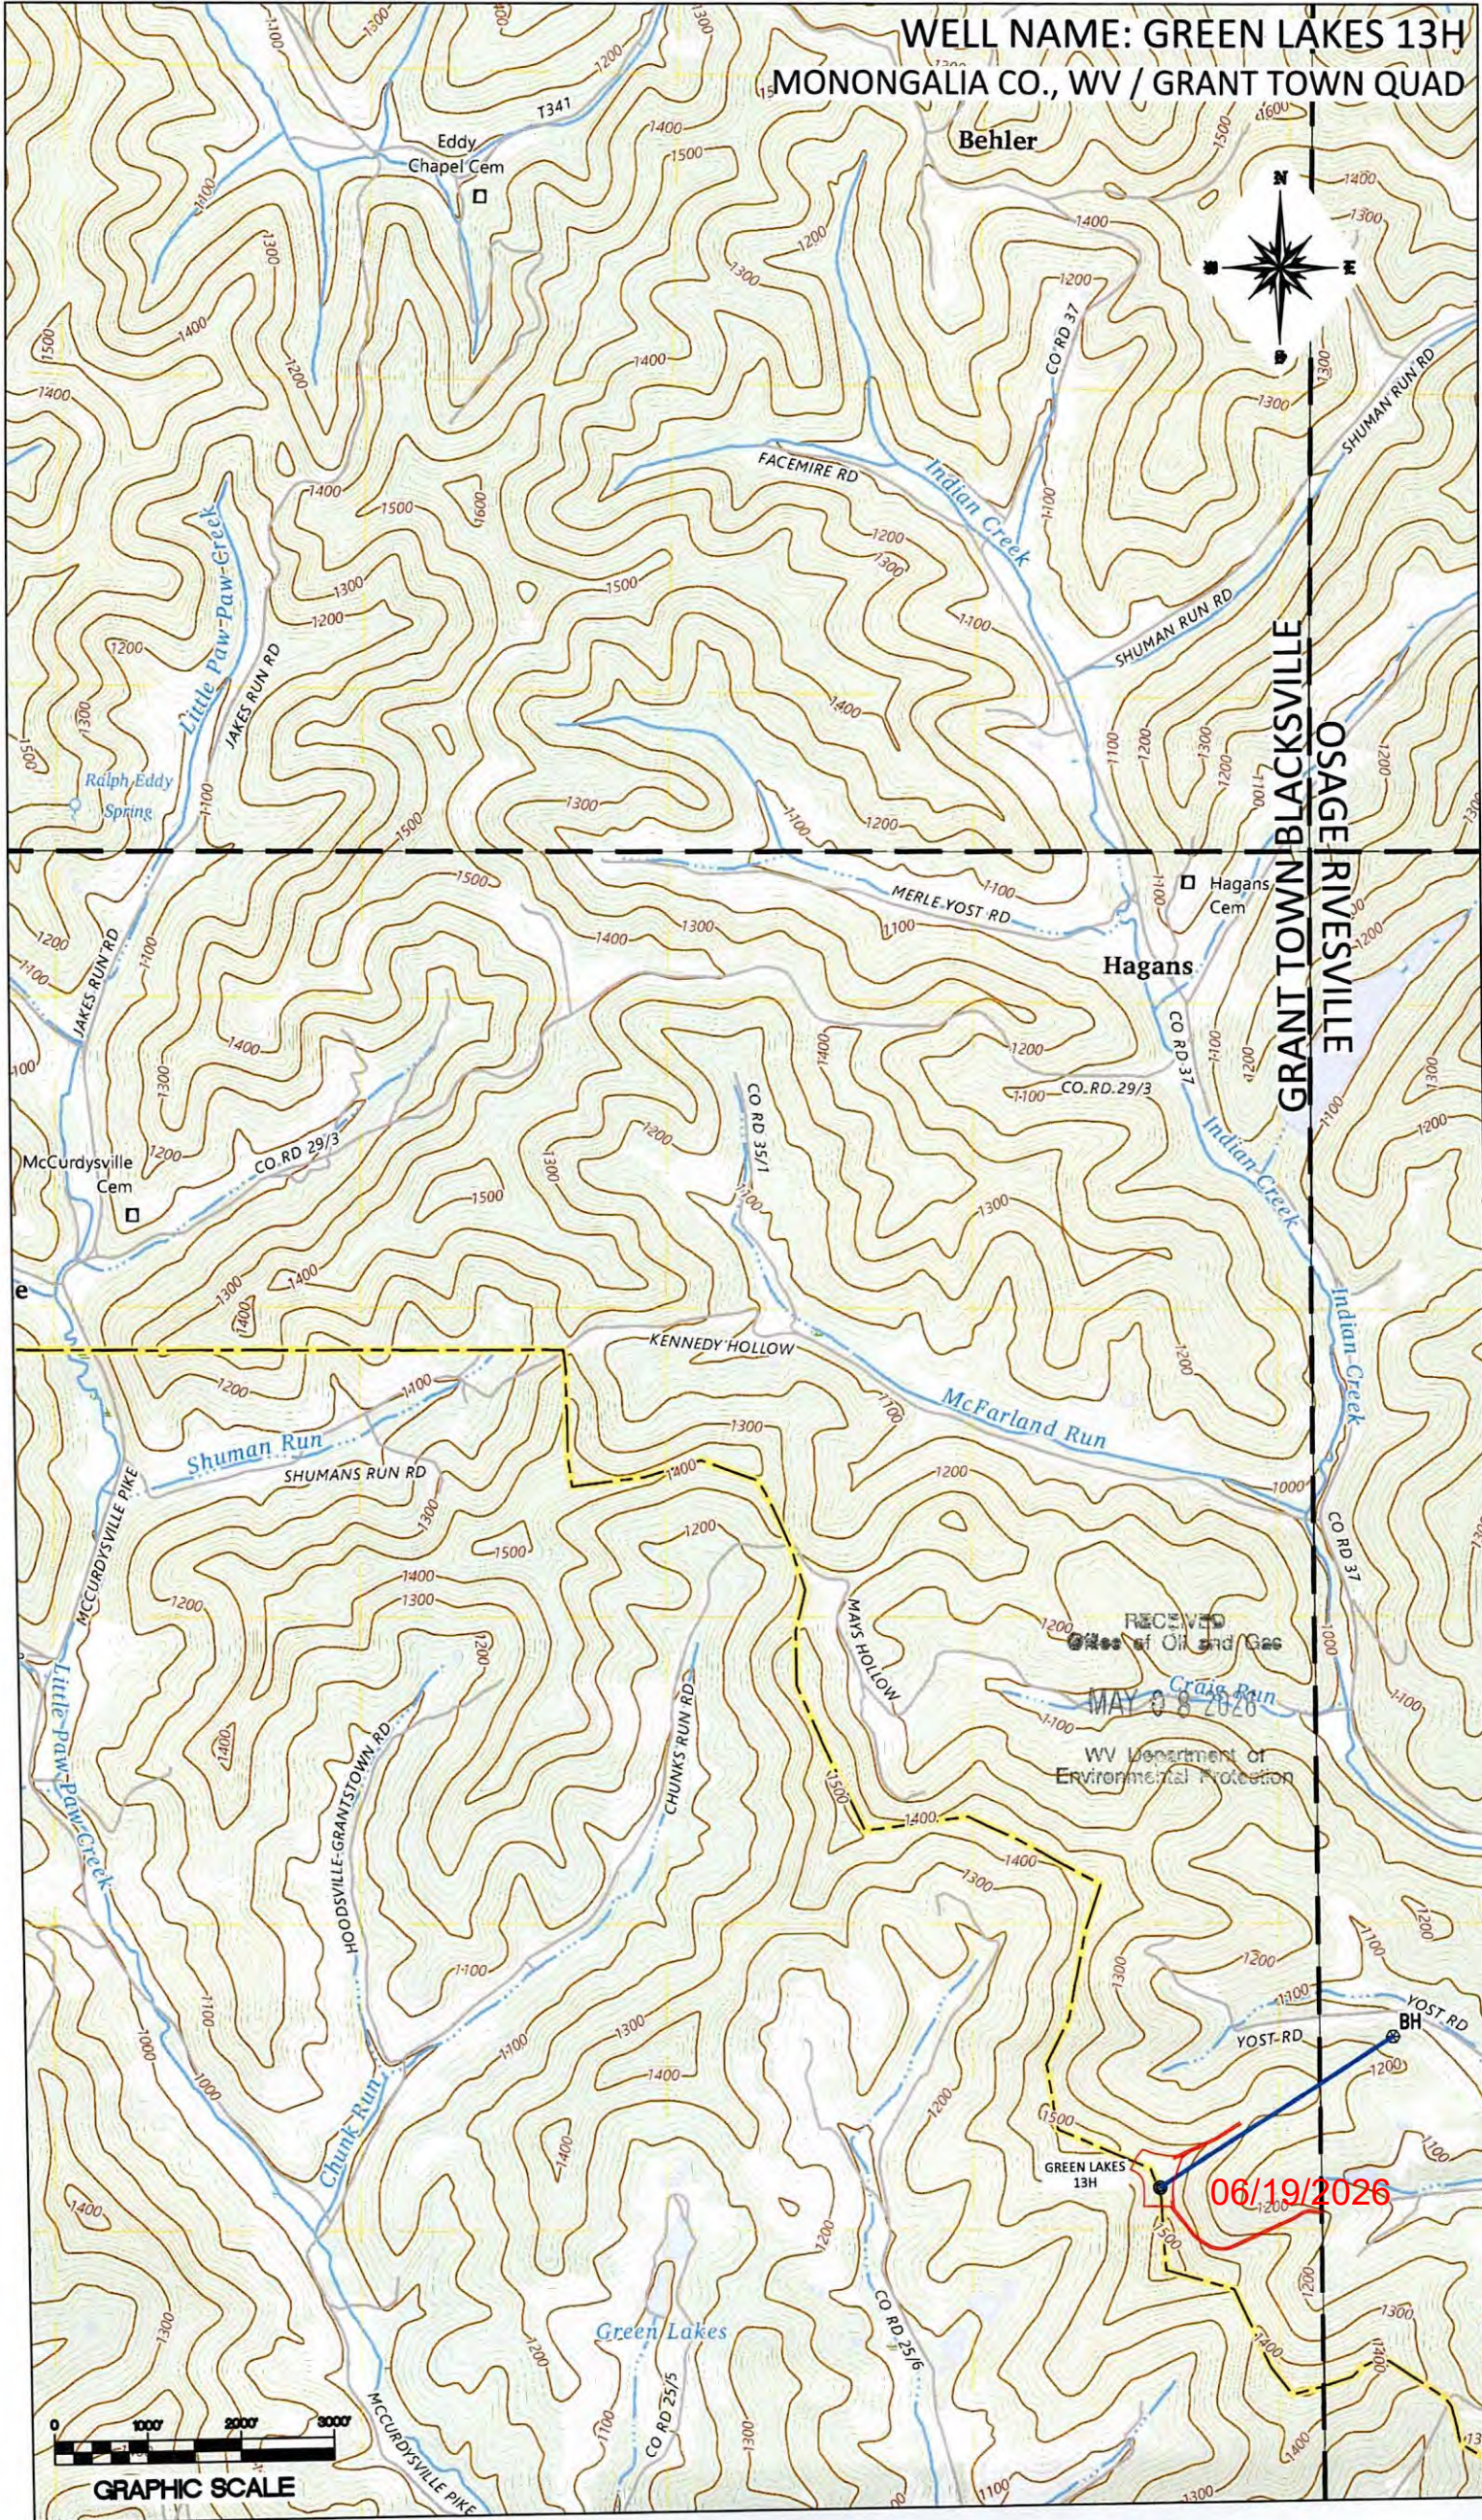


OSAGE RIVERVILLE
GRANT TOWN QUAD

RECEIVED
Office of Oil and Gas
MAY 08 2020
WV Department of
Environmental Protection

06/19/2026



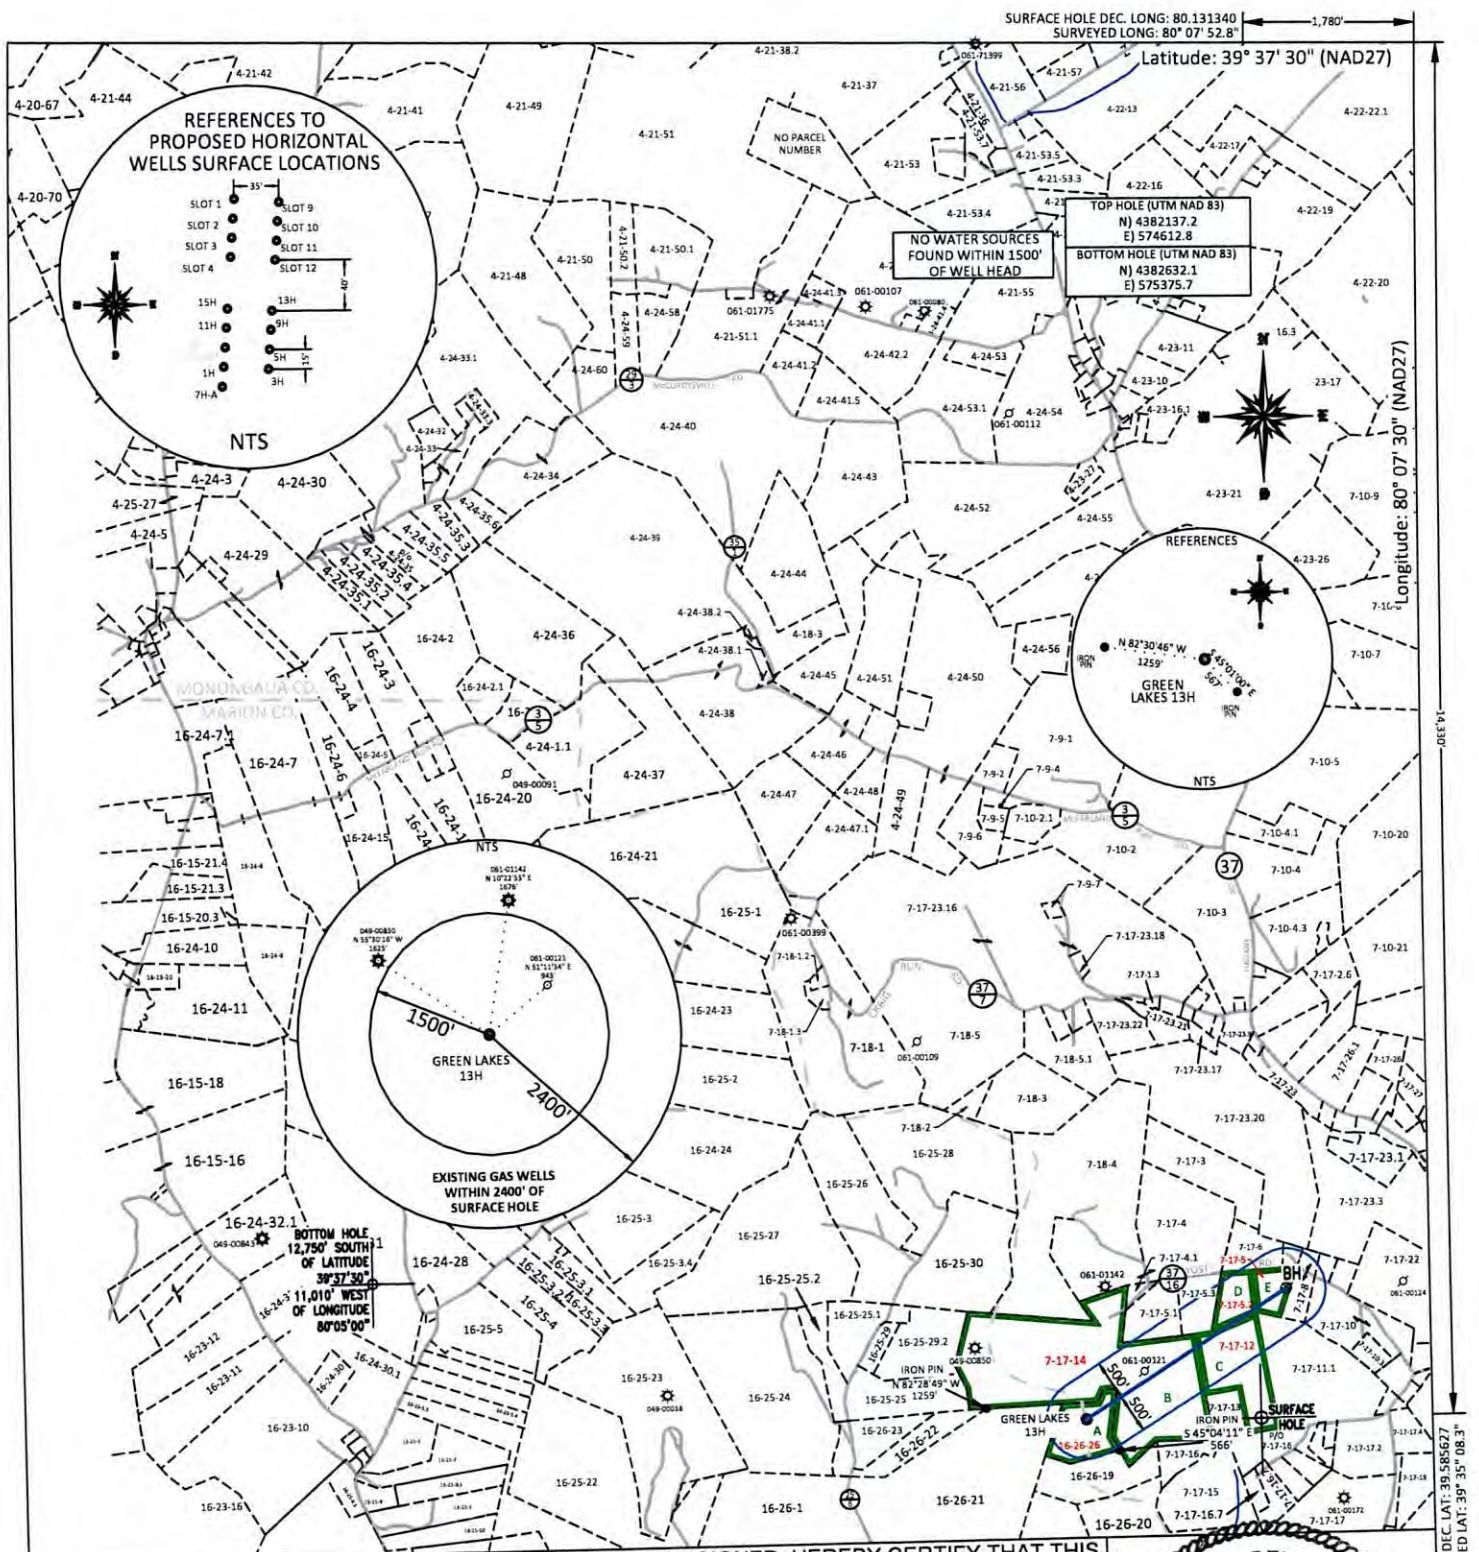

FILE #: NNE20
DRAWING #: 4192
SCALE: PLAT: 1" = 2400'
TICK: 1" = 2000'
MINIMUM DEGREE OF ACCURACY: 1/200
PROVEN SOURCE OF ELEVATION: SUBMETER MAPPING GRADE GPS

I, THE UNDERSIGNED, HEREBY CERTIFY THAT THIS PLAT IS CORRECT TO THE BEST OF MY KNOWLEDGE AND BELIEF AND SHOWS ALL THE INFORMATION REQUIRED BY LAW AND THE REGULATIONS ISSUED AND PRESCRIBED BY THE DEPARTMENT OF ENVIRONMENTAL PROTECTION.

Signed: [Signature]
L.L.S. #2124 : Ernest J. Benchek III



(+) DENOTES LOCATION OF WELL ON UNITED STATES TOPOGRAPHIC MAPS WVDEP

OFFICE OF OIL & GAS
601 57TH STREET
CHARLESTON, WV 25304

Well Type: ☐ Oil ☐ Waste Disposal ☐ Production ☐ Deep
☒ Gas ☐ Liquid Injection ☐ Storage ☒ Shallow

WATERSHED: Upper Monongahela River

COUNTY/DISTRICT: MONONGALIA CO., GRANT DISTRICT / MARION CO., PAW PAW DISTRICT

SURFACE OWNER: MINISTERS RUN PROPERTY MANAGEMENT LLC

OIL & GAS ROYALTY OWNER:

LEASE NUMBERS:

DRILL ☒ CONVERT ☐ DRILL DEEPER ☐ REDRILL ☐ FRACTURE OR STIMULATE ☒
PLUG OFF FORMATION ☐ PERFORATE NEW FORMATION ☐ PLUG & ABANDON ☐
CLEAN OUT & REPLUG ☐ OTHER CHANGE ☐ (SPECIFY):

TARGET FORMATION: MARCELLUS

WELL OPERATOR: NORTHEAST NATURAL ENERGY LLC

ADDRESS: 707 VIRGINIA STREET EAST, SUITE 1200

CITY: CHARLESTON STATE: WV ZIP CODE: 25301

DATE: APRIL 29, 2026

OPERATOR'S WELL #: GREEN LAKES 13H

API WELL #: 47 061-02043

STATE COUNTY PERMIT

AS-BUILT ELEVATION: 1,448.7'

QUADRANGLE: GRANT TOWN

ACREAGE: 134.179 +/-

ACREAGE: 13.55 +/-

ESTIMATED DEPTH: TVD: 8050' TMD: 8902'

DESIGNATED AGENT: John Adams

ADDRESS: 707 VIRGINIA STREET EAST, SUITE 1200

CITY: CHARLESTON STATE: WV ZIP CODE: 25301

SURFACE HOLE DEC. LONG: 80.131340
SURVEYED LONG: 80° 07' 52.8"

PROPERTY INDEX	
16-26-26	MINISTERS RUN PROPERTY MANAGEMENT LLC
7-17-14	MINISTERS RUN PROPERTY MANAGEMENT LLC
7-17-12	NICK & JUNE BUTLER
7-17-5.2	WILLIAM J MICHAEL
7-17-5	AFONDA LYNN ADKINS

LEASE INDEX	
A	WV-049-106675-001
B	WV-049-106675-001
C	WV-061-007470-001
D	WV-061-107140-001
E	WV-061-106923-001

RECEIVED
Office of Oil and Gas

MAY 08 2026

WV Department of
Environmental Protection

06/19/2026

FILE #: NEE20	DATE: APRIL 29, 2026
DRAWING #: 4192	OPERATOR'S WELL #: GREEN LAKES 13H
SCALE: N/A	API WELL #: 47 061-02043
	STATE COUNTY PERMIT