

Company Carnegie Natl. Gas Co.
 Address 1014 Frick Bldg., Pgh, Pa.
 Farm J.D. Michael - now - Radcliff & Ridgway
 Tract Acres 180 Lease No. 6734-58
 Well (Farm) No. 1 Serial No. 1-E 299
 Elevation (Spirit Level) 1275
 Quadrangle Blacksville S.E. 4
 County Monongalia District Grant
 Engineer S. A. Shuffleworth
 Engineer's Registration No. 90
 File No. _____ Drawing No. _____
 Date 1-7-37 Scale 1" = 400'

STATE OF WEST VIRGINIA
 Department of Mines
 OIL AND GAS DIVISION
 Charleston
 W E L L L O C A T I O N M A P
 File No. MON-150A
 + Denotes location of well on U. S. Topographic Maps, scale 1 to 62,500 latitude and longitude lines being represented by border lines as shown
 — Denotes one inch spaces on border line of original tracing.

WEST VIRGINIA DEPARTMENT OF MINES
OIL AND GAS DIVISION

240

Lease No E 6734-58

WELL RECORD

Permit No. M ON-150-A

WELL TO BE ABANDONED


Oil or Gas Well Gas
(Kind)

Company Carnegie Natural Gas Co
Address 1014 Frick Bldg Pittsburgh Pa
Farm J D Michael Acres 180
Location (waters) Snider Run
Well No. 1-299 Elev. 1275
District Grant County Monongalia
The surface of tract is owned in fee by Russel P and Edith Ridgway, and address R Smith and Gail Radcliff Morgantown Va
Mineral rights are owned by Same
consult. coal Co Address _____
Drilling commenced July 30 1913
Drilling completed Oct 13 1913
Date shot Dec 31 1936 Depth of shot 2338-2348
Open Flow /10ths Water in _____ Inch
/10ths Merc. in _____ Inch
Volume _____ Cu. Ft.
Rock Pressure _____ lbs. _____ hrs.
Oil _____ bbls., 1st 24 hrs.
Fresh water _____ feet _____ feet
Salt water _____ feet _____ feet

Casing and Tubing	Used in Drilling	Left in Well	Packers
Size			Kind of Packer
16			
18			<u>Hook Wall</u>
10		<u>526</u>	Size of
8 1/4			<u>6 5/8 x 3</u>
6 5/8		<u>1790</u>	Depth set <u>3042</u>
5 3/16			
3			Perf. top
2		<u>2360</u>	Perf. bottom
Liners Used			Perf. top
			Perf. bottom

When Drilling, CASING CEMENTED Aug 18 SIZE 10" No. FT. 526 Date _____
COAL WAS ENCOUNTERED AT 408 FEET _____ INCHES
484 FEET _____ INCHES _____ FEET _____ INCHES
_____ FEET _____ INCHES _____ FEET _____ INCHES

Formation	Color	Hard or Soft	Top	Bottom	Oil Gas or Water	Depth Found	Remarks
Mapleton Coal			408	412			
Pittsburgh Coal			484	490			
Murphy Sand			590	640	<u>580 Gas</u>	<u>595</u>	
Little Dunkard			870	890			
Big Dunkard			1030	1050			
Gas Sand			1100	1260			
1st Salt Sand			1300	1335			
2nd Salt Sand			1350	1385			
Maxton Sand			1420	1480			
Big Lime			1755	1836			
Big Injun			1836	1920			
Gantz			2335	2382	<u>Gas</u>	<u>2340</u>	
Fifty Foot			2390	2427			
Thirty Foot			2444	2530			
Gordon Stray			2605	2617			
Fourth			2766	2792			
Fifth			2855	2895			
Total Depth				2900			

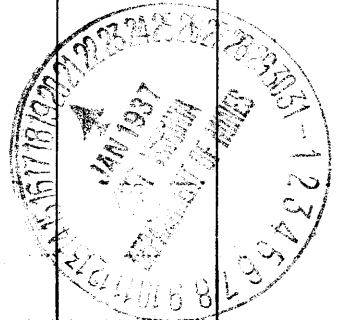

Formation	Color	Hard or Soft	Top	Bottom	Oil, Gas or Water	Depth Found	Remarks

Date Jan 15 1937, 19.....

APPROVED Carnegie Natural Gas Co, Owner

By B. Harker
(Title) Land Agt.

Grant District, Monongalia County, W. Va.
 By Carnegie Natural Gas Co., 1014 Frick Bldg., Pittsburgh, Pa.
 On 180 acres, on Snider Run; surface owned by Russel P. and Edith
 Ridgway, R. Smith, and Gail Radcliff, Morgantown, W. Va., and
 minerals by same and Consolidation Coal Co.
 Elevation, 1275' L. Lease No. E-6734-58.
 Drilling commenced July 30, 1913; completed, Oct. 13, 1913.
 Shot Dec. 31, 1936, at 2338-2348'.
 10" casing, 526'; 6 $\frac{5}{8}$ "⁵, 1700'; 2" tubing, 2360'; all left in.
 10" casing cemented when drilling (Aug. 1913), 526'.
 Coal was encountered at 408-412 and 484-490'.
 Hook wall packer, 6 $\frac{5}{8}$ x 3, set at 2042'.
 Gas well. Abandonment reported to Dept. of Mines Jan. 15, 1937.
 Record to RCT from D. G. Courtney (Dept. of Mines) 5-5-37.

	Top.	Bottom.
Mapletown (Sewickley) Coal	408	- 412
Pittsburgh Coal	484	- 490
Murphy Sand (gas, 595')	590	- 640
Little Dunkard Sand	870	- 890
Big Dunkard Sand	1030	- 1050
Gas Sand	1100	- 1260
1st Salt Sand	1300	- 1335
2nd Salt Sand	1350	- 1385
Maxton Sand	1420	- 1480
Big Lime	1755	- 1836
Big Injun Sand	1836	- 1920
Gantz Sand (gas, 2340')	2335	- 2382
50-Ft. Sand	2390	- 2427
30-Ft. Sand	2444	- 2530
Gordon Stray Sand	2605	- 2617
Fourth Sand	2766	- 2792
Fifth Sand	2855	- 2895
Total depth		2900