


LATITUDE 39° 42' 30"

LONGITUDE 79° 56'

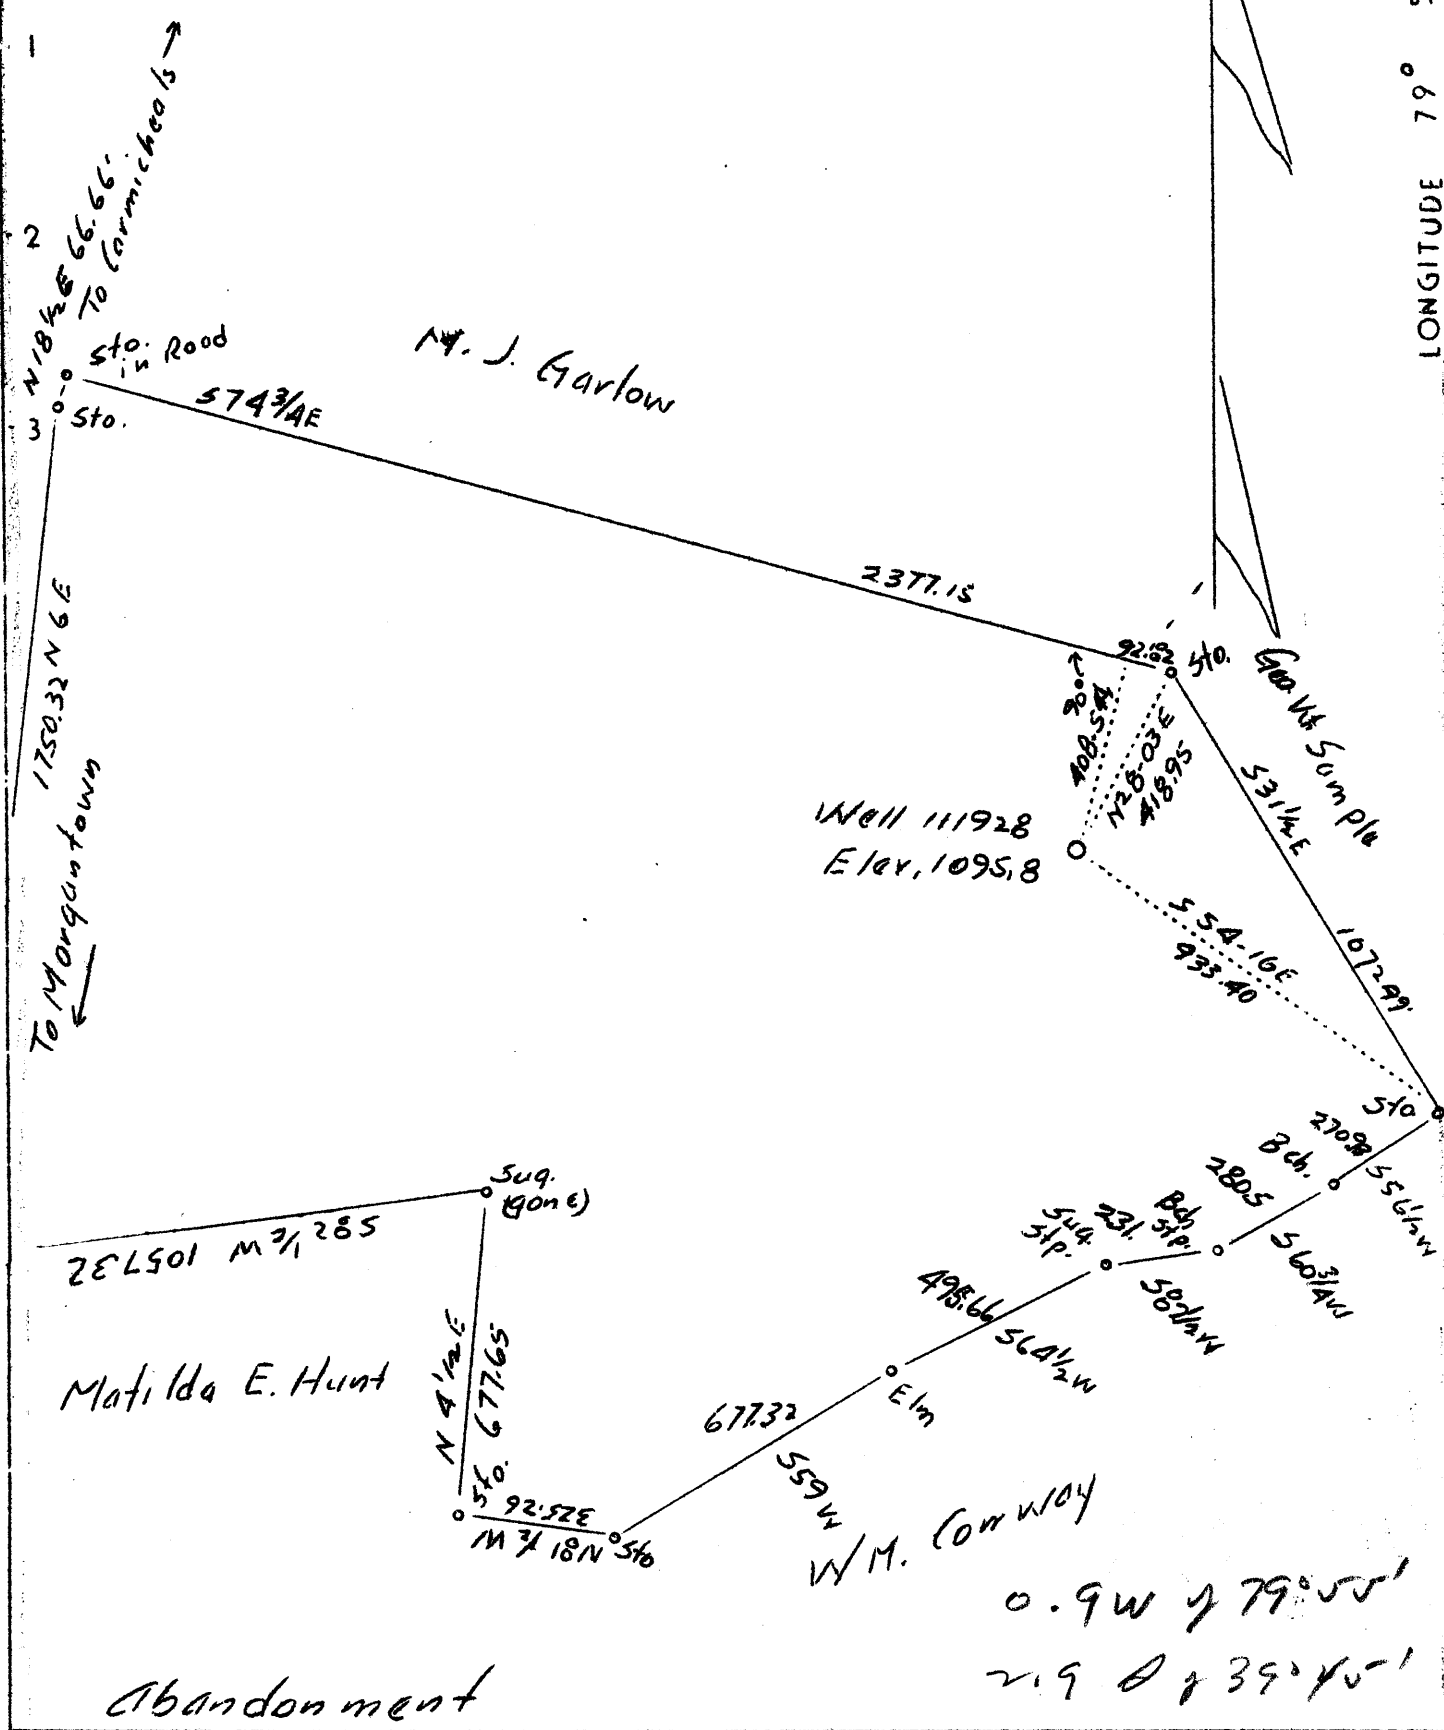

Company	L. J. Houze Convex Glass Co
Address	Point Marion, Pa
Farm	Matilda E. Hunt
Tract	1 Acres 93 plus Lease No
Well(Farm) No.	3 Serial No. 111928
Elevation (Spirit Level)	1095.8
Quadrangle	Morgantown NW
County	Monongalia District Cass
Engineer	James M. Cabbage
Engineer's Registration No.	3153 Pa
File No.	Drawing No. 158
Date	4-23-37 Scale 1" - 400'

STATE OF WEST VIRGINIA
 Department of Mines
 OIL AND GAS DIVISION
 Charleston

WELL LOCATION MAP
 File No. MOIV-156A

+ Denotes location of well on U. S. Topographic Maps, scale 1 to 62,800 latitude and longitude lines being represented by border lines as shown.

— Denotes one inch spaces on border line of original tracing.

Latitude 30 40 0'



M. L. Hunt 3

Company L. L. Hunt Energy Services Co.
 Address 10001 Highway 101
 From Highway 101
 Turn R onto SS 2 Lane No. _____
 Well (Farm) No. 2 Date No. 2/1982
 Elevator (Dip Level) 1000.0
 Gaugeleg 1000.0

STATE OF MISSISSIPPI
 DEPARTMENT OF REVENUE
 OIL AND GAS DIVISION
 COMMISSION
WELL LOCATION MAP
 FILE NO. 10001/101.2

© Register location of well on U.S.G.S. Grid.

10001-322

WEST VIRGINIA DEPARTMENT OF MINES
OIL AND GAS DIVISION

WELL RECORD

Permit No. _____

Oil or Gas Well Gas
(Kind)

Company L. S. Mines Service Company
Address 1114 Van Vorhis, P.O. Dept.,
Charlotte, N.C.

From Madison E. Hunt Acres 20

Location (waters)
Well No. 111808 Elev. 1028.6

District Gas County Wetzel

The surface of tract is owned in fee by Madison E. Hunt
Madisonville, Address Wheat, Virginia

Mineral rights are owned by _____
Address _____

Drilling commenced _____
Drilling completed Nov. 19, 1928

Date shot _____ Depth of shot _____

Open Flow 0 1/8 Water in _____ Inch
1/16 Merc. in _____ Inch

Volume _____ Cu. Ft.
Rock Pressure _____ lbs. per sq. in.
Oil _____ Mils. per 24 hrs.

Fresh water _____ feet
Salt water _____ feet

Casing and Tubing	Used in Drilling	Left in Well	Feet
Size			
14			Kind of Packer
12			
10			Size of
8 1/2			
6 1/2		<u>1178</u>	Depth set
5			
3			Perf. top
2			Perf. bottom
Line	Used		Perf. top
			Perf. bottom

CASING ORIENTED _____ SIZE _____ No. FT. _____ Date _____

COAL WAS ENCOUNTERED AT _____ FEET INCHES
_____ FEET INCHES FEET INCHES
_____ FEET INCHES FEET INCHES

Formation	Color	Hard or Soft	Top	Bottom	Oil Gas or Water	Depth Found	Remarks
Conductor			0	14			
Little Dunbar sand		red	206	207			
Slate			207	480			
Big Dunbar			480	470			
Frequent Coal			470	474			
Gas sand			545	686			
Salt sand			745	924			
Big Lime			1111	1171			
Big In. job			1171	1211			
Total Depth				1211			

STATE OF WEST VIRGINIA
DEPARTMENT OF MINES
OIL AND GAS DIVISION

AFFIDAVIT OF PLUGGING AND FILLING WELL

Page No. _____

Well _____
 No. _____
 Loc. _____
 In _____
 County _____
 State of _____

By _____
 No. _____
 Loc. _____
 In _____
 County _____
 State of _____

Witness _____
 No. _____
 Loc. _____
 In _____
 County _____
 State of _____

I, the undersigned, being duly sworn, depose and say that the well described above is a well for the purpose of _____ and that the same is being plugged and filled with _____ in accordance with the provisions of the laws of the State of West Virginia.

AFFIDAVIT

STATE OF WEST VIRGINIA

County of _____

I, _____

do hereby certify that the well described above is being plugged and filled with _____ in accordance with the provisions of the laws of the State of West Virginia.

I, _____, being duly sworn, depose and say that the well described above is being plugged and filled with _____ in accordance with the provisions of the laws of the State of West Virginia.

This affidavit was taken on this _____ day of _____, 19____, at _____, West Virginia.

Description of mineral

and that the work of plugging and filling well was completed on the _____ day of _____, 19____.



[Handwritten Signature]

STATE OF WEST VIRGINIA
DEPARTMENT OF MINES
OIL AND GAS DIVISION

AFFIDAVIT OF PLUGGING AND FILLING WELL

Form No. _____

Name _____
Address _____
City _____
State _____
Post Office _____
County _____
Phone _____

AFFIDAVIT

STATE OF WEST VIRGINIA

County of _____

I, _____

do hereby certify that the well described in the foregoing affidavit is the well of _____
 located in _____
 and that the same has been plugged and filled in accordance with the provisions of the
 Act of _____

and that the same has been plugged and filled in accordance with the provisions of the
 Act of _____

and that the same has been plugged and filled in accordance with the provisions of the
 Act of _____

Description of well:

and that the work of plugging and filling said well was completed on the _____ day of _____



[Handwritten Signature]