


Latitude

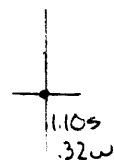

Longitude

Topo Location

7.5' Loc. _____ 15' Loc. _____
 _____ (calc.) _____

Company Hope Nat Gas

Farm A I Temmant # 4007


15' Quad _____
(sec.)

7.5' Quad Blacksville

District Clay

WELL LOCATION PLAT

County Obi Permit 30230

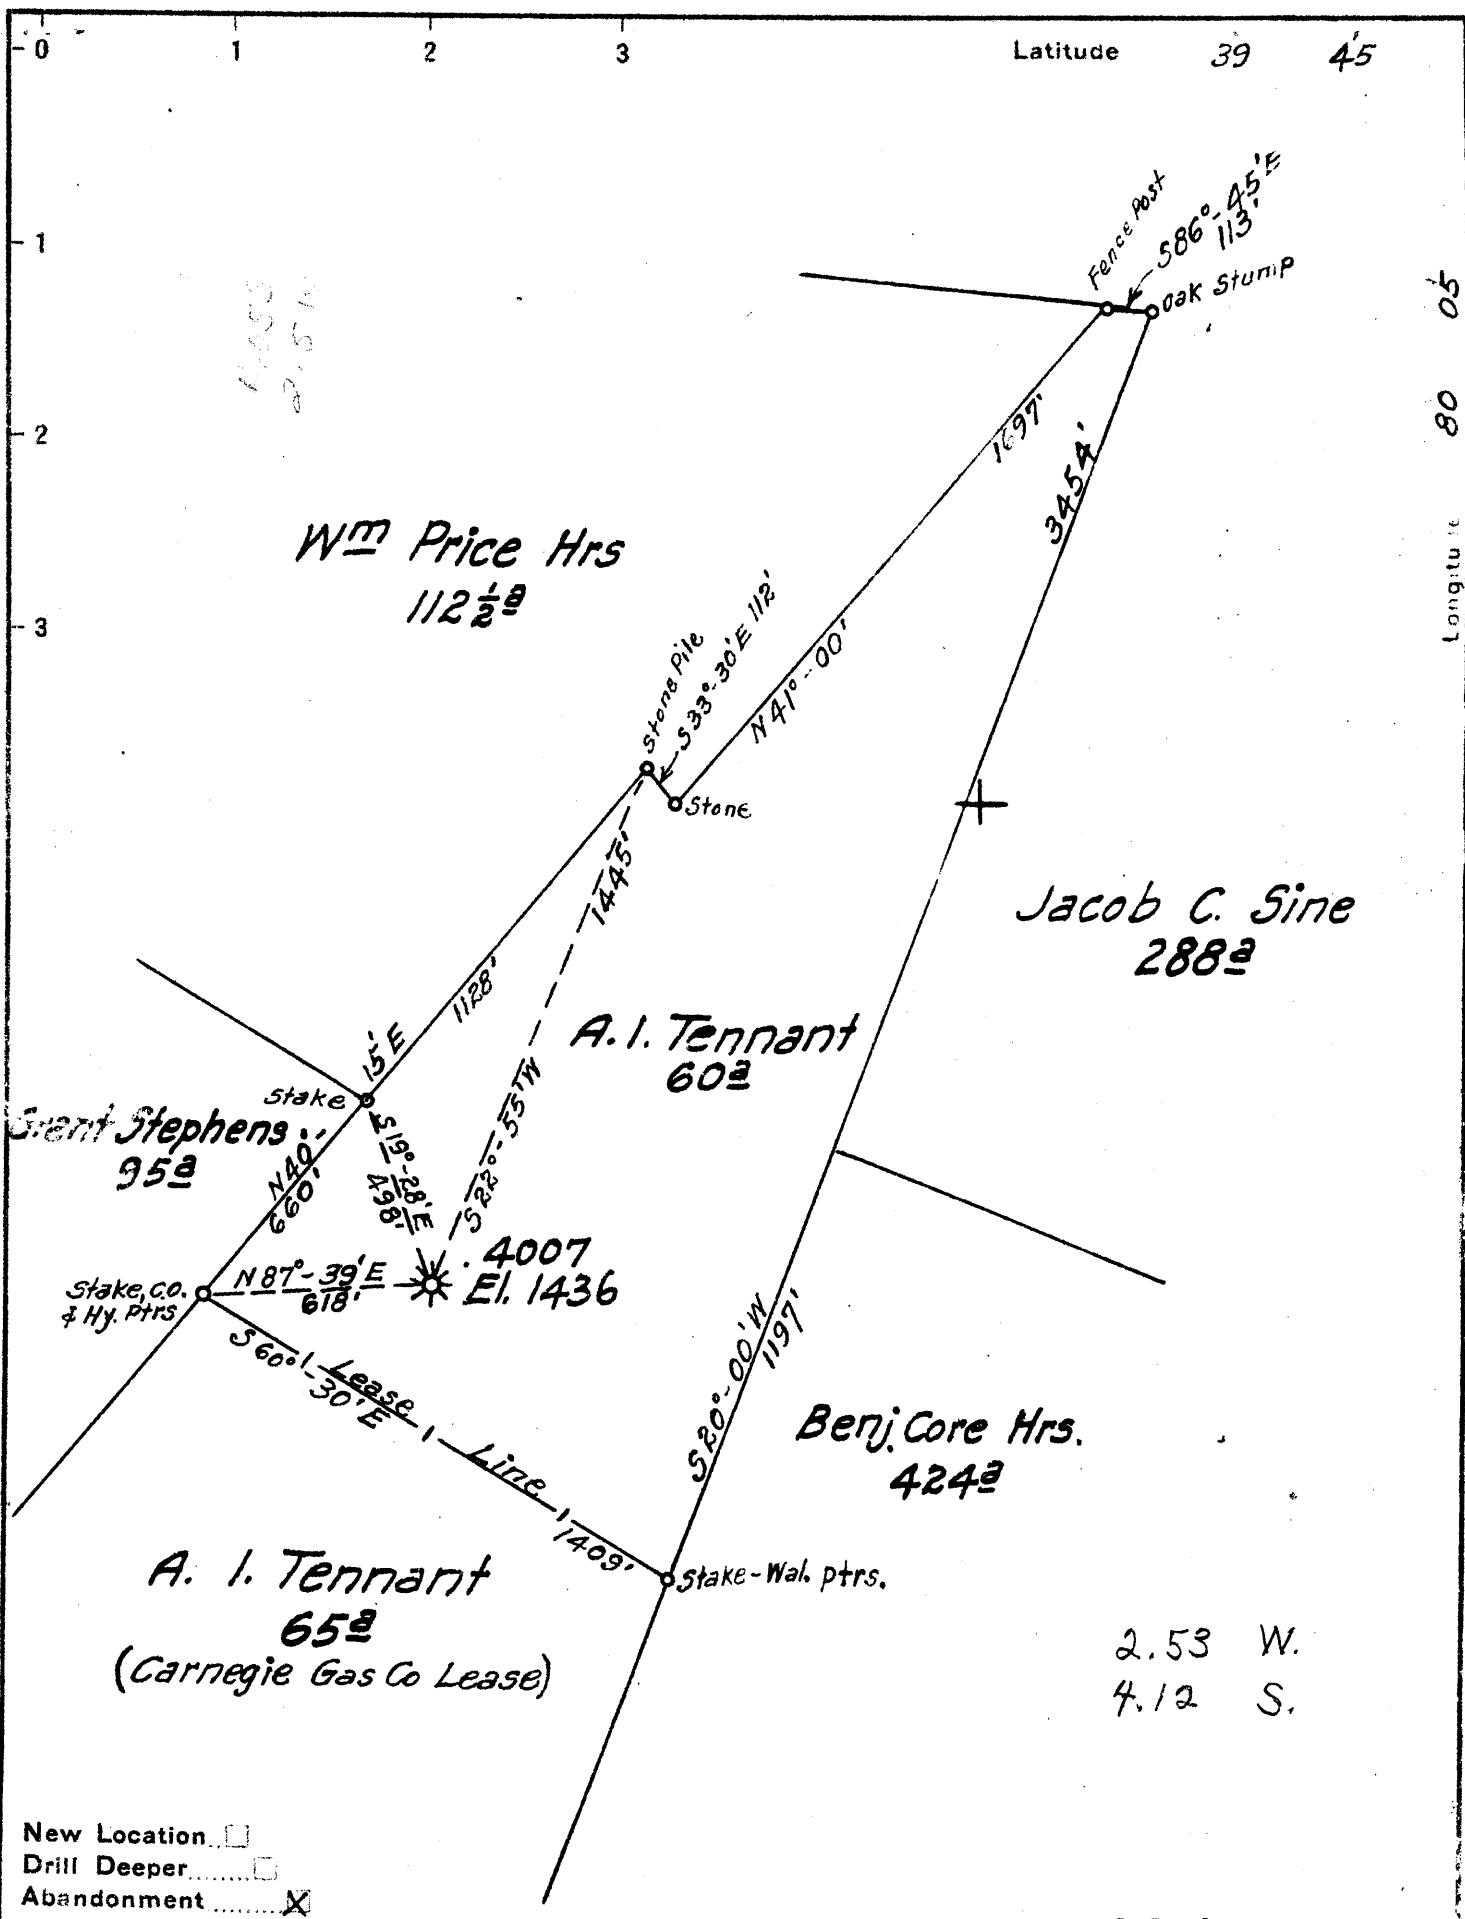

FB. 683 P. 39

Company Hope Natural Gas Co.
 Address Clarksburg, W. Va.
 Farm A. I. Tennant
 Tract _____ Acres 60 Lease No. 28230
 Well (Farm) No. _____ Serial No. 4007
 Elevation (Spirit Level) 1436
 Quadrangle Blacksville
 County Monongalia District Clay
 Engineer Wm Bowers
 Engineer's Registration No. 900
 File No. _____ Drawing No. _____
 Date June 10, 1940 Scale 1" = 30'

STATE OF WEST VIRGINIA
 DEPARTMENT OF MINES
 OIL AND GAS DIVISION
 CHARLESTON

WELL LOCATION MAP
 FILE NO. MON-230A

+ Denotes location of well on United States Topographic Maps, scale 1 to 62,500, latitude and longitude lines being represented by border lines as shown.

- Denotes one inch spaces on border line of original tracing.