

Surface: Jess Yost
Fairview, W. Va.

Coal: The Union Trust Co. of Pittsburgh, Trustee
Pittsburgh, Pa.

New Location
Drill Deeper
Abandonment

FEB 18 1941

4.0 W
3.16
N12 E 21 Map N61E

Company	South Penn Natural Gas Co.
Address	Parkersburg, W. Va.
Farm	W. R. Shuman
Tract	Acres 181 Lease No. 8470
Well (Farm) No.	6 Serial No.
Elevation (Spirit Level)	1460.90
Quadrangle	Blacksville
County	Monongalia District Clay
Engineer	E. C. Tabler
Engineer's Registration No.	
File No.	Drawing No.
Date Feb 25 1940 Scale 1" = 400'	

STATE OF WEST VIRGINIA
DEPARTMENT OF MINES
OIL AND GAS DIVISION
CHARLESTON

WELL LOCATION MAP
FILE NO. Mon-249A

+ Denotes location of well on United States Topographic Maps, scale 1 to 62,500, latitude and longitude lines being represented by border lines as shown.

- Denotes one inch spaces on border line of original tracing.

STATE OF WEST VIRGINIA
DEPARTMENT OF MINES
OIL AND GAS DIVISION

308

WELL RECORD

Ab 249-A
Permit No. _____

Oil or Gas Well _____
(KIND)


Company SOUTH PENN. NATURAL GAS COMPANY
Address Union Trust Bldg., Parkersburg, W. Va.
Farm W. R. Shuman Acres 181
Location (waters) Bonnefield Fork
Well No. 6 Elev. 1460.90
District Clay County Monongalia
The surface of tract is owned in fee by Jess Yost
Address Fairview, W. Va.
Mineral rights are owned by W. Hunter Atha, et al.
Address Zanesville, Ohio
Drilling commenced June 23, 1904
Drilling completed September 12, 1904
Date shot _____ Depth of shot _____
Open Flow _____ /10ths Water in _____ Inch
_____ /10ths Merc. in _____ Inch
Volume _____ Cu. Ft.
Rock Pressure _____ lbs _____ hrs.
Oil _____ bbls., 1st 24 hrs.
Fresh water _____ feet _____ feet
Salt water 1938 feet 2420 feet

Casing and Tubing	Used in Drilling	Left in Well	Packers
Size			
10"	1067	1067	Kind of Packer
8 1/2"	1515	506'4"	
			Size of
6 5/8"	2060	2060	Depth set
5 3/16"	2477	2477	
3"			Perf. top
2"			Perf. bottom
Liners Used			Perf. top
4 1/2"	464'1"	464'1"	Perf. bottom

CASING CEMENTED _____ SIZE _____ No. Ft. _____ Date _____

COAL WAS ENCOUNTERED AT 905 FEET 72 INCHES
1010 FEET 96 INCHES FEET INCHES
FEET INCHES FEET INCHES

Formation	Color	Hard or Soft	Top	Bottom	Oil, Gas or Water	Depth Found	Remarks
Mapletown Coal			905	911			
Pittsburgh Coal			1010	1018			
Big Dunkard			1512	1560			
Gas Sand			1812	1870			
Salt Sand			1900	2040			
					Water	1938	
Pencil Cave			2240	2245			
Big Lime			2245	2305			
Big Injun			2305	2510			
					Oil	2415	
					Water	2420	
Thirty Foot			2810	2835			
Fifty Foot			2895	2995			
Stray			3175	3195			
Gordon			3212	3237			
Fourth			3270	3300			
Fifth			3441				
					Gas	3420	
					Oil	3444	
TOTAL DEPTH				3464			

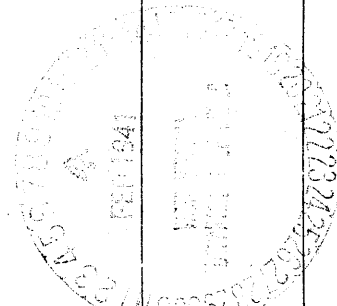

Formation	Color	Hard or Soft	Top	Bottom	Oil, Gas or Water	Depth Found	Remarks

Date..... **February 7th,** 194**1**

APPROVED..... **SOUTH PENN NATURAL GAS COMPANY**....., Owner

By..... *Edton Young*....., **LAND AGENT**
(Title)