

Company The Interstate Pipe & Supply Co.
 Address Box 611 Marietta Ohio
 Farm Nancy A. Johnson Heirs
 Tract _____ Acres 263 1/2 Lease No. _____
 Co Nos. 575-576-577-578
 Well (Farm) No. 1, 3, 4, 2, 5 Serial No. _____
 Elevations (Spirit Level) 1112.0-1139.0-1196.0-1182.0
 Quadrangle Mannington
 County Monongalia District Battelle
 Engineer C.O. Newwig
 Engineer's Registration No. 811
 File No. _____ Drawing No. _____
 Date Dec. 7 1940 Scale 1" = 600'

STATE OF WEST VIRGINIA
 DEPARTMENT OF MINES
 OIL AND GAS DIVISION
 CHARLESTON

WELL LOCATION MAP
 FILE NO. MON-250A
 WELL 576
 No. 576

+ Denotes location of well on United States Topographic Maps, scale 1 to 62,500, latitude and longitude lines being represented by border lines as shown.

- Denotes one inch spaces on border line of original tracing.

NANCY A, JOHNSON HRS, No. 3 (576) - THE INTERSTATE PIPE & SUPPLY CO. MON-25

STATE OF WEST VIRGINIA
DEPARTMENT OF MINES
OIL AND GAS DIVISION

305

WELL RECORD

Permit No. **Ab 250-A**


Oil or Gas Well **Oil**
(KIND)

Company **The Interstate Pipe & Supply Company**
 Address **Marietta, Ohio**
 Farm **Nancy A. Johnson Heirs** Acres **263½**
 Location (waters) _____
 Well No. **576** (3) Elev. **1139**
 District **Battelle** County **Monongalia**
 The surface of tract is owned in fee by **Nancy A. Johnson Heirs**
 Address **Hundred, W. Va.**
 Mineral rights are owned by **Nancy A. Johnson Heirs**
 Address **Hundred, W. Va.**
 Drilling commenced **June 22, 1909**
 Drilling completed **August 18, 1909**
 Date shot _____ Depth of shot _____
 Open Flow /10ths Water in _____ Inch
 /10ths Merc. in _____ Inch
 Volume _____ Cu. Ft.
 Rock Pressure _____ lbs. _____ hrs.
 Oil _____ bbls., 1st 24 hrs.
 Fresh water _____ feet _____ feet
 Salt water _____ feet _____ feet

Casing and Tubing	Used in Drilling	Left in Well	Packers
Size			
Conductor	16	16	Kind of Packer
13			
10	442	219	Size of
8¼	1461	---	
6½	2201	2201	Depth set
5 3/16	2391	2391	
3			Perf. top
2			Perf. bottom
Liners Used			Perf. top
			Perf. bottom

CASING CEMENTED _____ SIZE _____ No. Ft. _____ Date _____
 COAL WAS ENCOUNTERED AT **565** FEET **36** INCHES
800 FEET **72** INCHES **910** FEET **96** INCHES
 _____ FEET _____ INCHES _____ FEET _____ INCHES

Formation	Color	Hard or Soft	Top	Bottom	Oil, Gas or Water	Depth Found	Remarks
Bluff Sand			490	561			
Native Coal			565	568			
Mapletown Coal			820	826			
Pittsburgh Coal			910	918			
Little Dunkard			1250	1275			
Big Dunkard			1450	1510			
Gas Sand			1620	1655			
Salt Sand			1818	1883			
Second Salt Sand			1896	1916			
Little Lime			2100	2110			
Big Lime			2128	2198			
Big Injun			2198	2362			
Squaw			2372	2397			
Red Ash Grit			2700	2715			
Fifty Feet			2815	2859			
Thirty Feet			2880	2909			
Campbell Run Sand			3052	3069			
Stray Sand			3094	3102			
Gordon Sand			3114	3138			
Oil at			3134	3138			
Total Depth			3138				
							Shot in Gordon 3134 - 3138

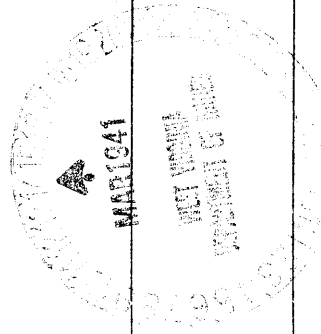

Formation	Color	Hard or Soft	Top	Bottom	Oil, Gas or Water	Depth Found	Remarks

Date **March 15**, 194**1**

APPROVED **THE INTERSTATE PIPE & SUPPLY CO.**, Owner

By *[Signature]* (Title)