

Company CARNEGIE NATURAL GAS
 Address PITTSBURGH, PENNA.
 Farm ASA TENNANT
 Tract ONE Acres 80 Lease No. E-546056
 Well (Farm) No. 2 Serial No. 92
 Elevation (Spirit Level) 12.60'
 Quadrangle BLACKSVILLE S.W. 1/4
 County MONONGALIA District CLAY
 Engineer D.T. BRITTON
 Engineer's Registration No. _____
 File No. _____ Drawing No. _____
 Date 3-29-1945 Scale 1" = 400'

STATE OF WEST VIRGINIA
 DEPARTMENT OF MINES
 OIL AND GAS DIVISION
 CHARLESTON

WELL LOCATION MAP
 FILE NO. MON-314-A

+ Denotes location of well on United States Topographic Maps, scale 1 to 62,500, latitude and longitude lines being represented by border lines as shown.

- Denotes one inch spaces on border line (original tracing)

ASA TENNANT No. 2 (92) - CARNEGIE N.G. Co. - MON-314-A



357

STATE OF WEST VIRGINIA
DEPARTMENT OF MINES
OIL AND GAS DIVISION

WELL RECORD
WELL TO BE ABANDONED

Permit No. **314-A**

Oil or Gas Well **GAS**
(KIND)

Company **CARNEGIE NATURAL GAS COMPANY**
Address **1035 FRICK BLDG., PITTSBURGH, PA.**
Farm **ASA TENNANT** Acres **80**
Location (waters) _____
Well No. **92** Elev. **1260**
District **CLAY** County **MONONGALIA**
The surface of tract is owned in fee by **SEE BELOW**
Address _____
Mineral rights are owned by **SEE BELOW**
Address _____
Drilling commenced **9-20-07**
Drilling completed **1-18-08**
Date Shot From **3067** To **3070**
With **30 Qts.**
Open Flow /10ths Water in _____ Inch
/10ths Merc. in _____ Inch
Volume _____ Cu. Ft.
Rock Pressure _____ lbs. _____ hrs.
Oil _____ bbls., 1st 24 hrs.
Fresh water _____ feet
Salt water **1590** feet **1625** feet

Casing and Tubing	Used in Drilling	Left in Well	Packers
Size			
16			Kind of Packer
18			
10	675'	None	Size of
8 1/4	1550	None	
6 3/4	1675	1675'	Depth set
5 3/16	2124	2124	
3			Perf. top
2	3103	3103	Perf. bottom
Liners Used			Perf. top
			Perf. bottom


CASING CEMENTED _____ SIZE _____ No. Ft. _____ Date _____
COAL WAS ENCOUNTERED AT **660** FEET _____ INCHES
_____ FEET _____ INCHES _____ FEET _____ INCHES
_____ FEET _____ INCHES _____ FEET _____ INCHES

Formation	Color	Hard or Soft	Top	Bottom	Oil, Gas or Water	Depth Found	Remarks
Pittsburgh Coal			660'		10"		
Big Dunkard			1175'				
1st Salt Sand			1560'		2" Water	1590'	
Pencil Cave			1875'	1885'	Water	1625'	
Big Lime			1885'	1945'			
Big Injun			1945'	2090'	5" Gas	1955' & 2065'	
50-Foot Sand			2580'	2620'			
5th Sand			3064'	3090'	Gas	3065' & 3070'	
TOTAL DEPTH				3103'	2"		

Tools Lost 1830'

SURFACE and MINERAL OWNERS:

Mrs. R. G. Barr, Virginia Beach, Va.
Miss Flo Tennant, Rt. #1, Riverville, W.Va.
Miss Hattie Tennant, Rt. #1, Riverville, W.Va.
Byron Tennant, Riverville, W.Va.
Cecil Tennant, 515 E. 15th St., Los Angeles, Calif.

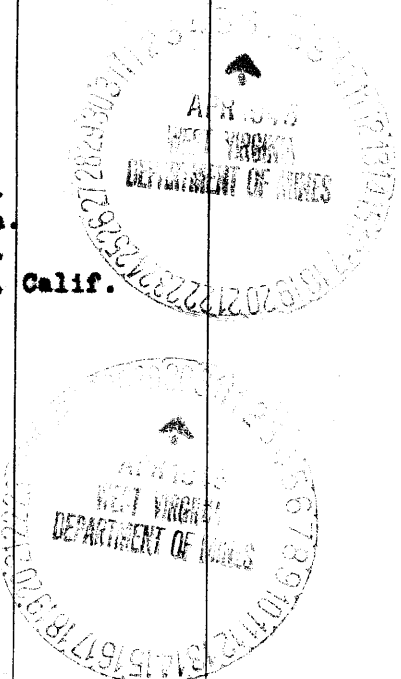

Formation	Color	Hard or Soft	Top	Bottom	Oil, Gas or Water	Depth Found	Remarks

Date APRIL 5, 194 5

APPROVED CARNEGIE NATURAL GAS COMPANY, Owner

By B. N. Archer
 (Title) Land Agent.