


Latitude 39 40

Elevations:

- Elishu Eddy - Floor - 1263.43; Ground - 1260.93
- Elishu Eddy - " 1239.45; " - 1237.45
- Elishu Eddy - " 1166.24; " - 1164.24

Ino L. Calvert

Charlotte Ban

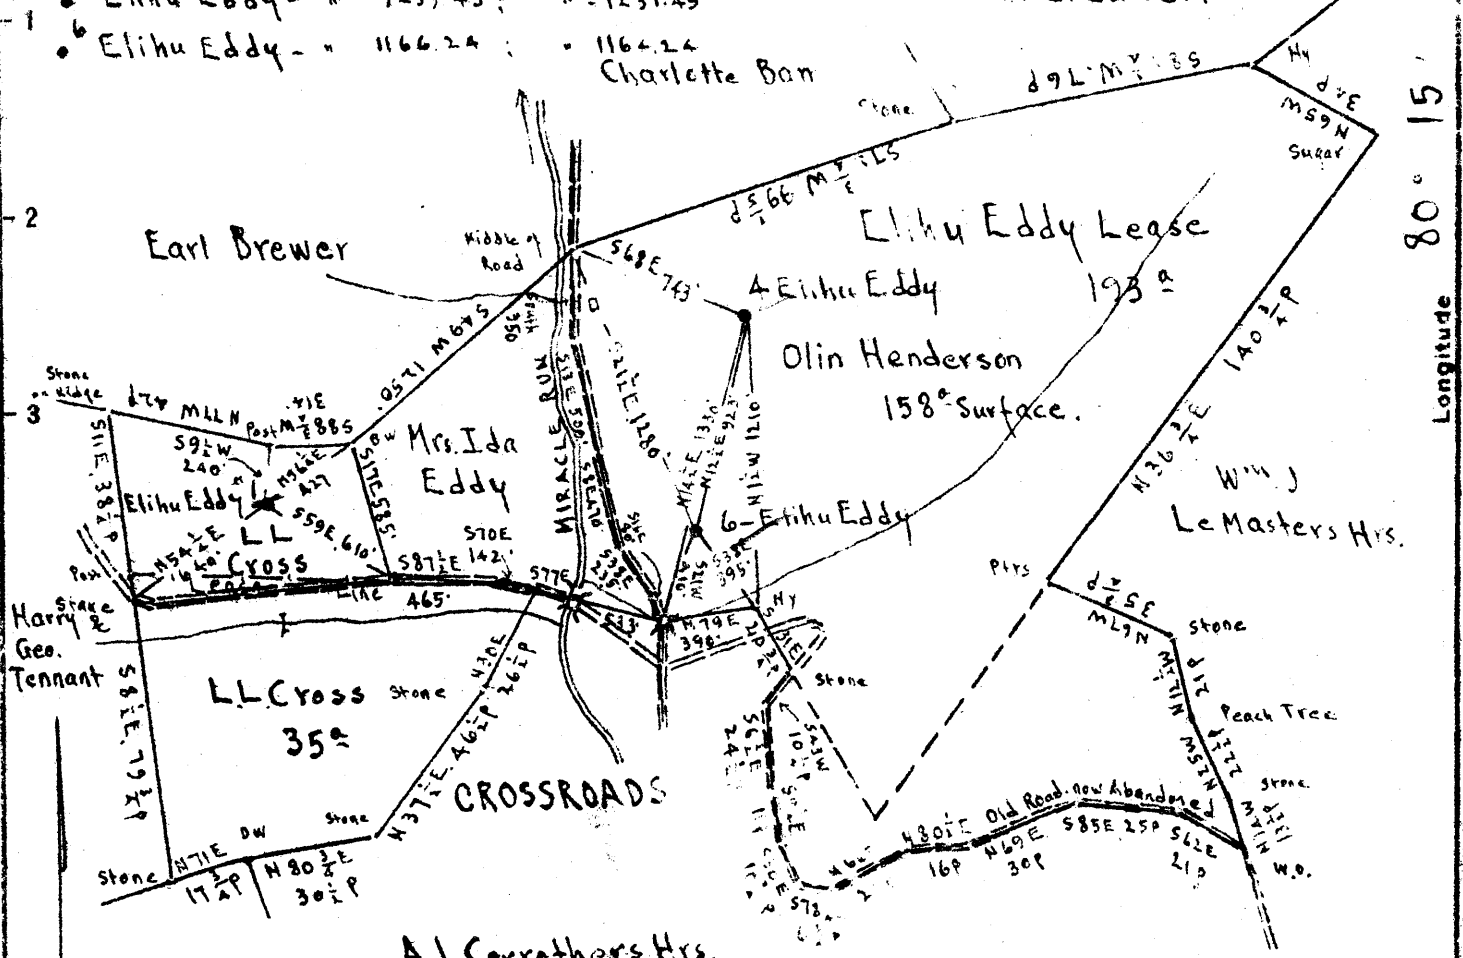

Longitude 80 15

Scale 1" = 800 Feet

LL Cross
 Surface: • Elishu Eddy; RFD #1, Wadestown, Monongalia Co., W.Va.
 Surface: • 4 & 6 Elishu Eddy; RFD #1, Wadestown, Monongalia Co., W.Va.

Pittsburgh Coal: Wheeling Dollar Savings & Trust Co., Wheeling, W.Va.

0.42S
 2.78W
 0.20S
 2.72W
 0.40S
 3.11W

New Location
 Drill Deeper
 Abandonment

On 400' Map #2359

N 14-15 E 18

Company Evaluation & Sales Service
 Address Mount Pleasant Michigan
 Farm Elishu Eddy
 Tract _____ Acres 193 Lease No. _____
 Well (Farm) No. 1, 4 & 6 Serial No. _____
 Elevation (Spirit Level) See at top of sheet
 Quadrangle MANNINGTON
 County Monongalia District Battelle
 Engineer E.C. Tabler
 Engineer's Registration No. _____
 File No. _____ Drawing No. _____
 Date Feb 3^d 1948 Scale 1" = 800 Feet

STATE OF WEST VIRGINIA
 DEPARTMENT OF MINES
 OIL AND GAS DIVISION
 CHARLESTON

WELL LOCATION MAP
 MON-346-A-#6
 FILE NO. MON-347-A-#4
 MON-348-A-#1

+ Denotes location of well on United States Topographic Maps, scale 1 to 62,500, latitude and longitude lines being represented by border lines as shown.

- Denotes one inch spaces on border line of original tracing.



STATE OF WEST VIRGINIA
DEPARTMENT OF MINES
OIL AND GAS DIVISION

WELL RECORD

Permit No.

Oil or Gas Well 011
(KIND)

Company South Penn Oil Co.
Address Parkersburg, W. Va.
Farm Eliba Eddy Acres 193
Location (waters)
Well No. 4 Elev. 1164.24
District Puttelle County Monongalia
The surface of tract is owned in fee by Eliba Eddy & Olin Henderson
Address RD-1 Madestown W. Va.
Mineral rights are owned by
Address

Drilling commenced 5-18-05
Drilling completed 5-19-1899
Date Shot 7-18-05 From To
With 30 qts 40 qts


Open Flow /10ths Water in Inch
 /10ths Merc. in Inch
Volume Cu. Ft.
Rock Pressure lbs. hrs.
Oil bbls., 1st 24 hrs.
Fresh water feet feet
Salt water feet feet

Casing and Tubing	Used in Drilling	Left in Well	Packers
Size			<i>No Record</i>
16			Kind of Packer
13			
10	<u>205</u>	<u>R11</u>	Size of
8 1/4	<u>1496</u>	"	
6 5/8	<u>2200</u>	"	Depth set
5 3/16	<u>2500</u>	"	
3			Perf. top
2			Perf. bottom
Liners Used			Perf. top
<u>4" X 1 1/2"</u>	<u>632' 6"</u>	"	Perf. bottom

CASING CEMENTED SIZE No. Ft. Date

COAL WAS ENCOUNTERED AT FEET INCHES
 FEET INCHES FEET INCHES
 FEET INCHES FEET INCHES

Formation	Color	Hard or Soft	Top	Bottom	Oil, Gas or Water	Depth Found	Remarks
Pittsburgh Coal			970	977			
Big Injan			2240	2398			
Fifty Foot			2670	2925			
G.R. Sand			3115	3135			
Stray Sand			3170	3190			
Gordon Sand			3195				
1st Pay			3208				
Total Depth			3210				
							Drilled Deeper in Dec 1905 and cleaned out. Total depth now <u>3235</u>

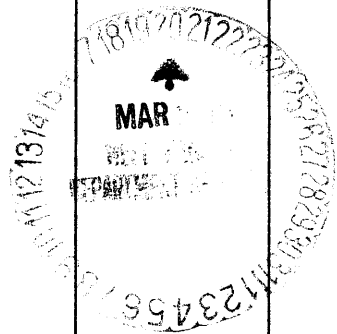

Formation	Color	Hard or Soft	Top	Bottom	Oil, Gas or Water	Depth Found	Remarks

Date 3/13/48, 19

APPROVED *[Signature]*, Owner

By _____ (Title)