

New Location
 Drill Deeper
 Abandonment

Company W. R. GOREY
 Address UMONTOWN PA.
 Farm JOSEPH DEVINE
 Tract One Acres 93+ Lease No. NE
 Well (Farm) No. 1 Serial No. NE
 Elevation (Spirit Level) 1210 Feet
 Quadrangle MANNINGTON
 County Monongalia District Battelle
 Engineer J. M. Cochran
 Engineer's Registration No. Co. Surveyor
 File No. _____ Drawing No. _____
 Date 7-17-1948 Scale 1 inch = 30 Rods

STATE OF WEST VIRGINIA
 DEPARTMENT OF MINES
 OIL AND GAS DIVISION
 CHARLESTON

WELL LOCATION MAP
 FILE NO. MON-412-A

+ Denotes location of well on United States Topographic Maps, scale 1 to 62,500, latitude and longitude lines being represented by border lines as shown.

- Denotes one inch spaces on border line of original tracing.



STATE OF WEST VIRGINIA
DEPARTMENT OF MINES
OIL AND GAS DIVISION

433

WELL RECORD

per annual report.
Oil or Gas Well Oil
(KIND)

Permit No. 412-A

Company W. R. Corey
Address Uniontown, Pa.
Farm Joseph Devins Acres 93
Location (waters) Mahogany Run
Well No. 1 Elev. 1210'
District Battelle County Monongalia
The surface of tract is owned in fee by _____
Address _____
Mineral rights are owned by _____
Address _____

Drilling commenced _____
Drilling completed Year 1908
Date Shot From _____ To _____
With _____


Open Flow /10ths Water in _____ Inch
/10ths Merc. in _____ Inch
Volume _____ Cu. Ft.
Rock Pressure _____ lbs. _____ hrs.
Oil _____ bbls., 1st 24 hrs.
Fresh water _____ feet _____ feet
Salt water _____ feet _____ feet

Casing and Tubing	Used in Drilling	Left in Well	Packers
Size			Kind of Packer
16			
13			
10		<u>1305'</u>	Size of
8 1/4		<u>1998'</u>	
6 5/8		<u>2377'</u>	Depth set
5 3/16		<u>3138'</u>	
3			Perf. top
2		<u>3426'</u>	Perf. bottom
Liners Used			Perf. top
			Perf. bottom

CASING CEMENTED _____ SIZE _____ No. Ft. _____ Date _____

COAL WAS ENCOUNTERED AT 96 1/2 FEET _____ INCHES
_____ FEET _____ INCHES FEET _____ INCHES
_____ FEET _____ INCHES FEET _____ INCHES

Formation	Color	Hard or Soft	Top	Bottom	Oil, Gas or Water	Depth Found	Remarks
Pgh. Coal			96 1/2'	973'			
Dunkard Sand			1340'	1505'			
Salt Sand			1765'	1960'			
Big Injun			2246'	2427'			
Fifty Foot			2855'	2914'			
Gordon Sand			3186'	3212'			
Fourth Sand			3219'	3260'			
Total Depth			3426'				

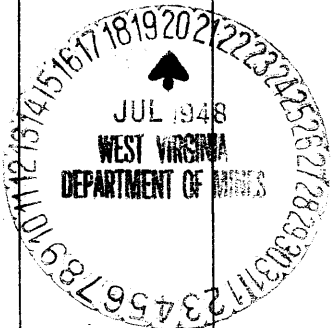

DEVINE

JOSEPH DEVINE NO. 1 WELL.

412A

Nuttalls District, Monongalia County, W. Va.

By W. H. Corey, Uniontown, Pa.

Abandoned under permit Mon-.....-17

On 93 acres, on Mahogany Run.

Elevation, 1210' L.

Drilling completed in 1908.

10" casing, 1305'; 8", 1998'; 6", 2377'; 5", 3138'; 2" tubing, 3426'; all left in.

Coal was encountered at 964-973'.

Record to Dept. of Mines stamped July 20, 1948.

Record to 207 from Mrs. Griffith Oct. 11, 1948. Old file No. 433.

oil well per annual report

	Top.	Bottom.
Pittsburgh Coal	964	973
Indiana Sand	1740	1505
Salt Sand	1765	1960
Big Injun Sand	2346	2427
Fifty-foot Sand	2855	2914
Gordon Sand	3106	3212
Fourth Sand	3219	3260
Total depth		3426