


Latitude 39° 40'

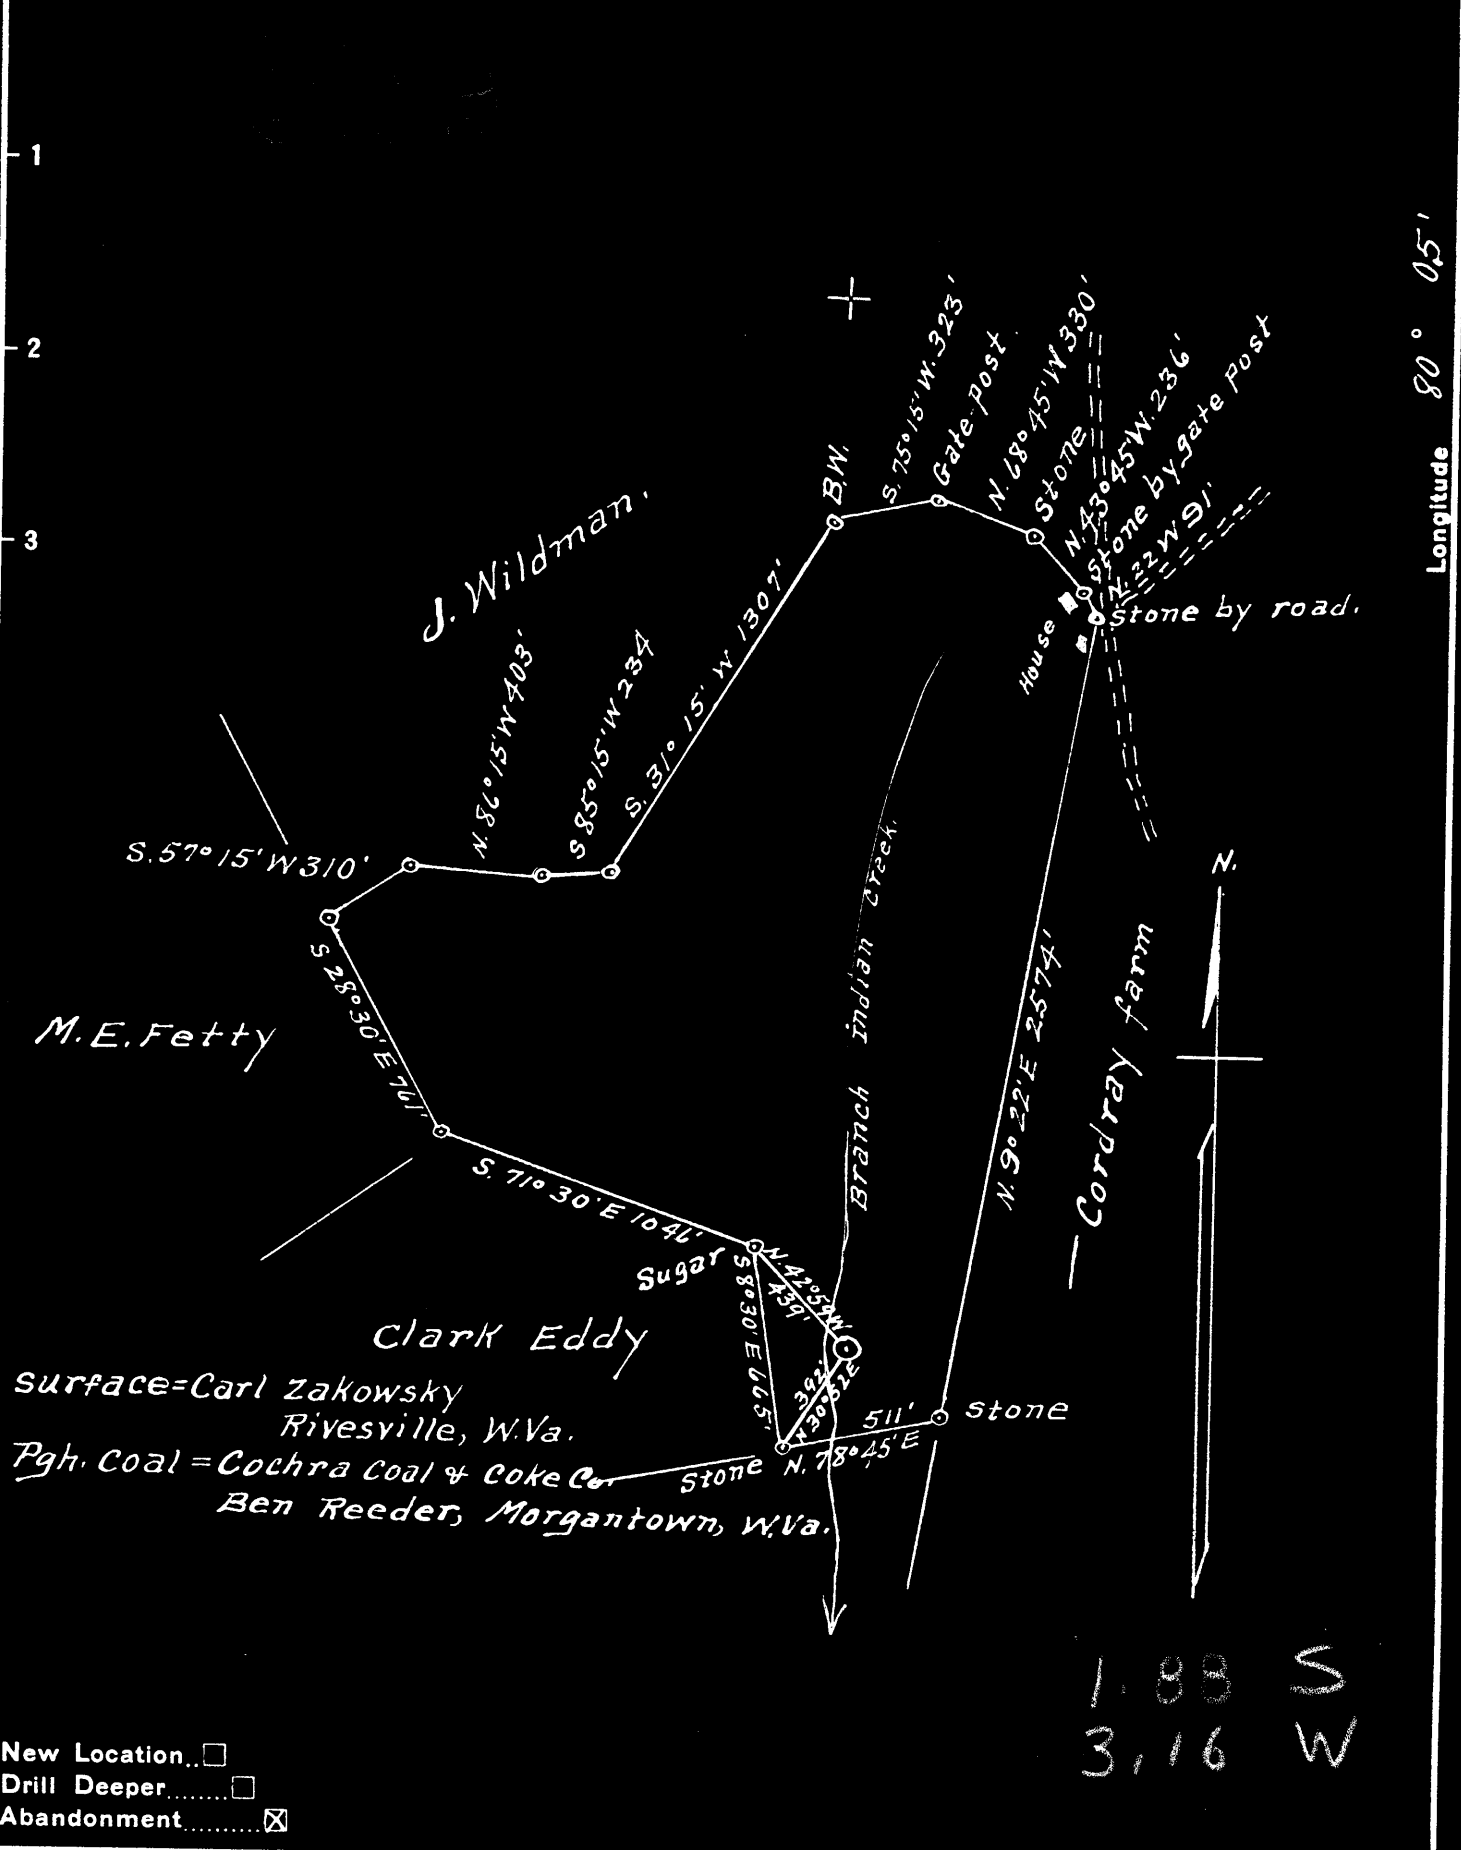

New Location
 Drill Deeper
 Abandonment

1.88 S
 3.16 W

Company A. M. Snider
 Address Hundred, W.Va.
 Farm J. Wildman
 Tract 1 Acres 83+ Lease No. 8390
 Well (Farm) No. 31 Serial No. _____
 Elevation (Spirit Level) 1169'
 Quadrangle Blacksville C
 County Monongalia District Clay
 Engineer A. L. Headley
 Engineer's Registration No. _____
 File No. _____ Drawing No. _____
 Date 9-20-1948 Scale 1" = 600'

STATE OF WEST VIRGINIA
 DEPARTMENT OF MINES
 OIL AND GAS DIVISION
 CHARLESTON

WELL LOCATION MAP
 FILE NO. MON-431-A

+ Denotes location of well on United States Topographic Maps, scale 1 to 62,500, latitude and longitude lines being represented by border lines as shown.
 - Denotes one inch spaces on border line of original tracing.

