

Surface owned by Mrs. Hazel J. Price, R.F.D. No. 1. Metz, Marion Co. W. Va.
 Coal, 1/3 undivided interest owned by C.F. Crane, 1014. Locust Ave. Fairmont, W. Va.

Coal, 2/3 undivided interest was owned by W.J. Eddy & L.C. Minor.

New Location Sold to State of West Virginia for taxes, year 1929.
 Drill Deeper Not redeemed.
 Abandonment On 400' Map Sheet No. 2457. Sqs. N 12 E 15.

Company Road Supply Co.
 Address Salem, W. Va.
 Farm William Kinney
 Tract _____ Acres 64 5/16 Lease No. _____
 Well (Farm) No. 1 Serial No. _____
 Elevation (Spirit Level) Floor --- 1150.68
 Ground --- 1149.68
 Quadrangle Mannington
 County Monongalia District Battelle
 Engineer A. L. Headley
 Engineer's Registration No. 2021
 File No. _____ Drawing No. _____
 Date May 13th, 1949. Scale 1" = 400 Feet.

STATE OF WEST VIRGINIA
 DEPARTMENT OF MINES
 OIL AND GAS DIVISION
 CHARLESTON

WELL LOCATION MAP
 FILE NO. MON-463-A

+ Denotes location of well on United States Topographic Maps, scale 1 to 62,500, latitude and longitude lines being represented by border lines as shown.

- Denotes one inch spaces on border line of original tracing.



511

STATE OF WEST VIRGINIA
DEPARTMENT OF MINES
OIL AND GAS DIVISION

463-A

WELL RECORD

Permit No. _____

Oil or Gas Well _____ (KIND)

Company Raad Supply Company	Casing and Tubing	Used in Drilling	Left in Well	Packers
Address 184 East Main St., Salem, W. Va.				
Farm William Kinney Acres 64 5/16	Size			
Location (waters) S. Fork of W. Va Rk. of Dunkard Creek	16			Kind of Packer
Well No. 1 Elev. 1149.68	13			
District Battelle County Monongalia	10	122'	122'	Size of
The surface of tract is owned in fee by Mrs. Hazel Price	8 1/4	1354'	1314'	
R. F. D. #1 Address Metz, W. Va.	6%	2215'	2215'	Depth set
Mineral rights are owned by 1/3 - C.F. Crane	5 3/16	2489'	2489'	
1014 Locust Ave. - Fairmont, W. Va.	3			Perf. top
2/3 - STATE OF WEST VIRGINIA.	2	3153'	3153'	Perf. bottom
Drilling completed January 20, 1898	Liners Used			Perf. top
Date Shot _____ From _____ To _____				Perf. bottom
With _____				

Open Flow _____ /10ths Water in _____ Inch

_____ /10ths Merc. in _____ Inch

Volume _____ Cu. Ft.

Rock Pressure _____ lbs. _____ hrs.

Oil _____ bbls., 1st 24 hrs.

Fresh water _____ feet _____ feet


Salt water _____ feet _____ feet

CASING CEMENTED **No** SIZE _____ No. Ft. _____ Date _____

961
COAL WAS ENCOUNTERED AT **968** FEET **84** INCHES

FEET INCHES FEET INCHES
FEET INCHES FEET INCHES

Formation	Color	Hard or Soft	Top	Bottom	Oil, Gas or Water	Depth Found	Remarks
Pittsburgh Coal			961'	968'			
Big Dunkard Sand			1461	1500			
Salt Sand			1866	1961			
Big Injun			2248	2428			
Gordon Stray Sand			3089				
Gordon Sand			3120				
Pay				3120			
Total Depth				3153			

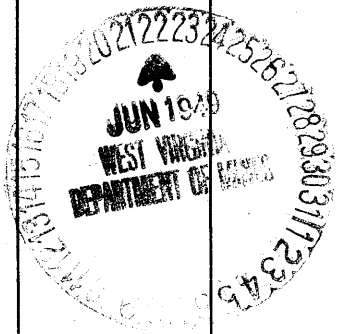

Formation	Color	Hard or Soft	Top	Bottom	Oil, Gas or Water	Depth Found	Remarks

Date June 20, 1979

APPROVED Road Supply Co., Owner

By Jm. Road, Mgr. Owner
w (Title)