

True Location  
 Old Survey  
 Abandonment

APPROXIMATE BEARING AND DISTANCE TO CORNER

Company WONG NATURAL GAS CO  
 Address CHARLESTON, W.V.  
 Firm WONG & MOORE  
 Town WONG Loc. No. W-1010  
 Well (Farm) No. \_\_\_\_\_ Serial No. 2650  
 Elevation (Spot Level) 1045'  
 County BRANDYwine  
 County Seat CHARLESTON  
 Engineer W. H. MOORE  
 Engineer's Registration No. 70  
 File No. \_\_\_\_\_ Drawing No. \_\_\_\_\_  
 Date 2-7-21 Scale 1" = 500'

STATE OF WEST VIRGINIA  
 DEPARTMENT OF MINES  
 OIL AND GAS DIVISION  
 CHARLESTON

**WELL LOCATION MAP**  
 FILE NO. 2650-NFT-2

\* Denotes location of well on United States  
 Topographic Maps, scale 1 to 62,500, latitude  
 and longitude lines being represented by  
 border lines as shown.

- Denotes one inch square on border line  
 of original tracing.

LATITUDE 39°40'00"

75'  
+

01.01.08

LONGITUDE

7'5 OGIS topo location

7.5' loc	<u>0.485</u>	15' loc	<u>0.485</u>
	<u>0.19 W</u>	(calc.)	<u>0.19 W</u>

Company \_\_\_\_\_

Farm \_\_\_\_\_

Quad OSAGE (Bulle W)

County Monongahela

District Clay

WELL LOCATION MAP

File No. 061-489A

Clay District, Monongalia County, W. Va.  
 By Hope Natural Gas Co., 445 W. Main St., Clarksburg, W. Va.  
 Abandoned under permit Mon-----A7  
 On 10 acres.  
 Elevation, 1015' L.  
 Drilling commenced July 2, 1923; completed Sept. 29, 1923.  
 Salt water at 1365'.  
 10" casing, 508' (pulled); 8 1/2", 1224' (pulled); 6 3/4", 1748'; 5 1/2", 2879'.  
 Casing not cemented.  
 Coal was encountered at 406-412 and 492-498'.  
 Gas well. Record to Dept. of Mines dated May 18, 1951.  
 Record to RGT from Mrs. Griffith June 28, 1951. Old File No. 536.

	Top.	Bottom.
Hopetown (Sevierclay) Coal	406	412
Pittsburgh Coal	492	498
Gas Sand (gas, 1198')	1190	1205
First Salt Sand	1300	1320
Second Salt Sand (hole full water, 1365')	1355	1495
Little Line	1715	1729
Pencil Core	1723	1728
Big Line	1728	1808
Big Injun Sand (gas, 1885-1890')	1808	1960
Gentle Sand	2353	2390
Fifty-foot Sand	2415	2465
Thirty-foot Sand	2470	2500
Fifth Sand (gas, 2882')	2882	2899
Bayard Sand	2906	2921
Total depth		2904 + (2921)



536

STATE OF WEST VIRGINIA  
DEPARTMENT OF MINES  
OIL AND GAS DIVISION

WELL RECORD

Permit No. MON-489-A


Oil or Gas Well (KIND)

Company Hope Natural Gas Company.  
 Address 445 West Main St. Clarksburg, W. Va.  
 Farm P. W. Moore Acres 10  
 Location (waters) \_\_\_\_\_  
 Well No. 9620 Elev. 1015  
 District Clay County Monongalia  
 The surface of tract is owned in fee by \_\_\_\_\_  
 Address \_\_\_\_\_  
 Mineral rights are owned by \_\_\_\_\_  
 Address \_\_\_\_\_  
 Drilling commenced July 2, 1923  
 Drilling completed Sept. 29, 1923  
 Date Shot \_\_\_\_\_ From \_\_\_\_\_ To \_\_\_\_\_  
 With \_\_\_\_\_  
 Open Flow \_\_\_\_\_ /10ths Water in \_\_\_\_\_ Inch  
 \_\_\_\_\_ /10ths Merc. in \_\_\_\_\_ Inch  
 Volume \_\_\_\_\_ Cu. Ft.  
 Rock Pressure \_\_\_\_\_ lbs. \_\_\_\_\_ hrs.  
 Oil \_\_\_\_\_ bbls., 1st 24 hrs.  
 Fresh water \_\_\_\_\_ feet \_\_\_\_\_ feet  
 Salt water 1365 feet \_\_\_\_\_ feet

Casing and Tubing	Used in Drilling	Left in Well	Packers
Size			Kind of Packer
16			
13			
10	<b>508</b>	<b>Pulled</b>	Size of
8 1/4	<b>1224</b>	<b>Pulled</b>	
6 3/4	<b>1748</b>	<b>1748</b>	Depth set
5 3/16	<b>2879</b>	<b>2879</b>	
3			Perf. top
2			Perf. bottom
Liners Used			Perf. top
			Perf. bottom

CASING CEMENTED **NOT** SIZE No. Ft. \_\_\_\_\_  
 COAL WAS ENCOUNTERED AT 406 FEET 72 INCHES  
492 FEET 72 INCHES FEET INCHES  
 FEET INCHES FEET INCHES

Formation	Color	Hard or Soft	Top	Bottom	Oil, Gas or Water	Depth Found	Remarks
Mapletown coal			406	412			
Pittsburgh Coal			492	498			
Gas sand			1190	1205	gas	1198	
First Salt			1300	1320			
Second Salt			1355	1495	hole full water	1365	
Little Lims			1715	1723			
Pencil cave			1823	1728			
Big Lims			1728	1808			
Big Injun			1808	1960	gas	1885 1890	
Gants			2353	2390			
Fifty foot			2415	2465			
Thirty foot			2470	2500			
Fifth Bayard			2882	2899	gas	2882	
			2906	2921			
Total depth				2904			

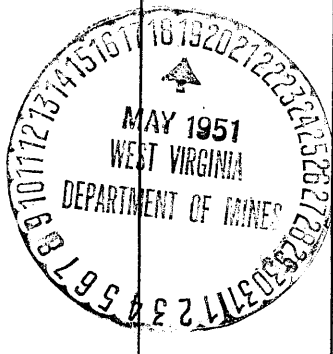

(Over) JUN 28 1951

Formation	Color	Hard or Soft	Top	Bottom	Oil, Gas or Water	Depth Found	Remarks

Date **May 18, 1951**, 19

APPROVED **Hope Natural Gas Company**, Owner

By \_\_\_\_\_

(Title) *ON*

