



New location  
 Old location  
 Abandoned

MAR 21 1922

Company WVA Natural Gas Co  
 Address Glenhurst WVa  
 Name CC LOUGH  
 Town Acers Lease No. 61201  
 Well (Pore) No.          Serial No. 200  
 Elevator (Bench Level) MSL  
 County Putnam  
 Township Putnam  
 Range 11th E

STATE OF WEST VIRGINIA  
 DEPARTMENT OF MINES  
 OIL AND GAS DIVISION  
 CHARLESTON  
**WELL LOCATION MAP**  
 FILE NO. MAN-492-9  
 \* Denotes location of well on United States  
 Topographic Maps, scale 1 to 62,500, latitude  
 and longitude lines being represented by  
 border lines on shown.

LATITUDE 39°42'30"

75'

800,0008

LONGITUDE

7'5 OGIS topo location

7.5' loc	<u>0.025</u>	15' loc	<u>0.025</u>
	<u>0.050</u>	(calc.)	<u>0.050</u>

Company \_\_\_\_\_

Farm \_\_\_\_\_

Quad Osage (Bille NE)

County Monongahela

District Cass

WELL LOCATION MAP

File No. 061-497A

#281 - 142 G.P.

061 - 70361

Cross District, Monongalia County, W. Va.  
 By Hope Natural Gas Co., 445 W. Main St., Clarksburg, W. Va.  
 Abandoned under permit Mon-  
 On 270 acres.  
 Elevation, 1057' L.  
 Drilling commenced May 22, 1912; completed June 1912.  
 No record of fresh water. Salt water in Salt Sand, no depth given).  
 10" casing, 314' (pulled); 8", 1249' (pulled); 6", 1524'; 2" tubing,  
 1681'.  
 Casing not cemented.  
 Coal was encountered at 95-100 and 216-225'.  
 Gas well. Record to Dept. of Mines dated June 4, 1951.  
 Record to ROT from Mrs. Griffith Aug. 17, 1951. Old File No. 945.

	Top.	Bottom.
Coal, Lewisley	95	- 100
Pittsburgh Coal	216	- 225
Salt Sand (water, 10 barrels per hour, depth.....?)	1062	- 1250
Rig Line	1470	- 1524
Rig Injan Sand (g.s. 1526, 1616, 1644')	1524	- 1681
Total depth		1681



STATE OF WEST VIRGINIA  
DEPARTMENT OF MINES  
OIL AND GAS DIVISION

*JH*

WELL RECORD

Permit No. MON 497-A


~~Oil~~ Gas Well \_\_\_\_\_  
(KIND)

Company Hope Natural Gas Company.  
Address 445 West Main St. Clarksburg, W. Va.  
Farm C.C. Laselle Hrs. Acres 220  
Location (waters) \_\_\_\_\_  
Well No. 9601 M.P. 309 Elev. 1057  
District Cass County Monongalia,  
The surface of tract is owned in fee by \_\_\_\_\_  
Address \_\_\_\_\_  
Mineral rights are owned by \_\_\_\_\_  
Address \_\_\_\_\_  
Drilling commenced May 22, 1912  
Drilling completed June 1912  
Date Shot \_\_\_\_\_ From \_\_\_\_\_ To \_\_\_\_\_  
With \_\_\_\_\_  
Open Flow \_\_\_\_\_ /10ths Water in \_\_\_\_\_ Inch  
\_\_\_\_\_ /10ths Merc. in \_\_\_\_\_ Inch  
Volume \_\_\_\_\_ Cu. Ft.  
Rock Pressure \_\_\_\_\_ lbs. \_\_\_\_\_ hrs.  
Oil \_\_\_\_\_ bbls., 1st 24 hrs.  
Fresh water no record feet \_\_\_\_\_ feet  
Salt water Salt sand no depth feet \_\_\_\_\_ feet

Casing and Tubing	Used in Drilling	Left in Well	Packers
Size			Kind of Packer
16			
13			
10	<u>314</u>	<u>Pulled</u>	Size of _____
8 1/4	<u>1249</u>	<u>Pulled</u>	
6 1/2	<u>1524</u>	<u>1524</u>	Depth set _____
5 3/16			
3			Perf. top _____
2	<u>1681</u>	<u>1681</u>	Perf. bottom _____
Liners Used			Perf. top _____
			Perf. bottom _____

CASING CEMENTED \_\_\_\_\_ SIZE \_\_\_\_\_ No. Ft. \_\_\_\_\_ Dat \_\_\_\_\_  
COAL WAS ENCOUNTERED AT 95 FEET 60 INCHES  
216 FEET 108 INCHES FEET INCHES  
FEET INCHES FEET INCHES

Formation	Color	Hard or Soft	Top	Bottom	Oil, Gas or Water	Depth Found	Remarks
<u>Cpal</u>	<u>Dark</u>		<u>95</u>	<u>100</u>			
<u>Pittsburgh Coal</u>			<u>216</u>	<u>225</u>			
<u>Salt sand</u>			<u>1062</u>	<u>1250</u>	<u>water 10 ballers per hr</u>		<u>depth ?</u>
<u>Big Lime</u>			<u>1440</u>	<u>1524</u>			
<u>Big Injun</u>			<u>1524</u>	<u>1681</u>	<u>Gas</u>	<u>1526 1616 1644</u>	
<u>Total depth</u>				<u>1681</u>			

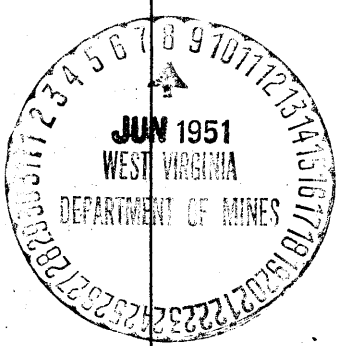

Formation	Color	Hard or Soft	Top	Bottom	Oil, Gas or Water	Depth Found	Remarks

Date June 4, 1951., 19

APPROVED Hope Natural Gas Company., Own

By

**E. H. Tollefson**  
(General Superintendent)

BY 

DEPARTMENT OF MINES  
OIL AND GAS DIVISION

AFFIDAVIT OF PLUGGING AND FILLING WELL

AFFIDAVIT SHOULD BE MADE IN TRIPLICATE, ONE COPY MAILED TO THE DEPARTMENT, ONE COPY TO BE RETURNED BY THE WELL OPERATOR AND THE THIRD COPY (AND OTHER COPIES IF REQUIRED) SHOULD BE MAILED TO EACH LOCAL OFFICE AT THEIR RESPECTIVE ADDRESSES.

<u>McCartney Coal Company,</u> COAL OPERATOR OR OWNER	<u>Hoge Natural Gas Company,</u> NAME OF WELL OPERATOR
<u>Morgantown, W. Va.</u> ADDRESS	<u>145 West Main St., Clarksburg, W. Va.</u> COMPLETE ADDRESS
LEGAL OFFICER OR OWNER	<u>6-22-51</u> 10 WELL AND LOCATION
<u>DURBIN,</u> ADDRESS	<u>Coal,</u> District
<u>C. Leslie Hrs.,</u> NAME OF PROPERTY OWNER	<u>Monongalia,</u> County
<u>Morgantown, W. Va.</u> ADDRESS	<u>Well No. 3002</u>
	<u>C. C. Leslie Hrs.,</u> Firm

STATE INSPECTOR SUPERVISING PLUGGING

AFFIDAVIT

STATE OF WEST VIRGINIA,

County of Monongalia

Charles A. Shivers and John J. Murphy  
being first duly sworn according to law do hereby depose and say that they are experienced in the work of plugging and filling oil and gas wells and were employed by Hoge Natural Gas Company well operator, and participated in the work of plugging and filling the above well, that said work was completed on the 16th day of June, 1951, and that the well was plugged and filled in the following manner:

DATE ON WHICH REQUIRED	FILLING MATERIAL		PLUGGED USED	REMARKS
	QUANTITY	DEPTH TO WHICH USED		
<u>Sept 22- 1951</u>	<u>cement</u>	<u>1000</u>	<u>1000</u>	
<u>Sept. 22- 1951</u>	<u>cement</u>	<u>1000</u>	<u>1000</u>	
<u>Oct. 22- 1951</u>	<u>cement</u>			
<u>Nov. 22- 1951</u>	<u>oil left over in surface,</u>			<u>left over</u>
<u>Dec. 22- 1951</u>	<u>oil left over in well,</u>			<u>left over</u>
<u>Jan. 22- 1952</u>	<u>oil left over in well,</u>			<u>left over</u>
<u>Feb. 22- 1952</u>	<u>oil left over in well,</u>			<u>left over</u>
<u>Mar. 22- 1952</u>	<u>oil left over in well,</u>			<u>left over</u>
<u>Apr. 22- 1952</u>	<u>oil left over in well,</u>			<u>left over</u>
<u>May 22- 1952</u>	<u>oil left over in well,</u>			<u>left over</u>
<u>June 22- 1952</u>	<u>oil left over in well,</u>			<u>left over</u>
<u>July 22- 1952</u>	<u>oil left over in well,</u>			<u>left over</u>
<u>Aug. 22- 1952</u>	<u>oil left over in well,</u>			<u>left over</u>
<u>Sept. 22- 1952</u>	<u>oil left over in well,</u>			<u>left over</u>
<u>Oct. 22- 1952</u>	<u>oil left over in well,</u>			<u>left over</u>
<u>Nov. 22- 1952</u>	<u>oil left over in well,</u>			<u>left over</u>
<u>Dec. 22- 1952</u>	<u>oil left over in well,</u>			<u>left over</u>
<u>Jan. 22- 1953</u>	<u>oil left over in well,</u>			<u>left over</u>
<u>Feb. 22- 1953</u>	<u>oil left over in well,</u>			<u>left over</u>
<u>Mar. 22- 1953</u>	<u>oil left over in well,</u>			<u>left over</u>
<u>Apr. 22- 1953</u>	<u>oil left over in well,</u>			<u>left over</u>
<u>May 22- 1953</u>	<u>oil left over in well,</u>			<u>left over</u>
<u>June 22- 1953</u>	<u>oil left over in well,</u>			<u>left over</u>
<u>July 22- 1953</u>	<u>oil left over in well,</u>			<u>left over</u>
<u>Aug. 22- 1953</u>	<u>oil left over in well,</u>			<u>left over</u>
<u>Sept. 22- 1953</u>	<u>oil left over in well,</u>			<u>left over</u>
<u>Oct. 22- 1953</u>	<u>oil left over in well,</u>			<u>left over</u>
<u>Nov. 22- 1953</u>	<u>oil left over in well,</u>			<u>left over</u>
<u>Dec. 22- 1953</u>	<u>oil left over in well,</u>			<u>left over</u>

and that the work of plugging and filling said well was completed on the 16th day of June, 1951.

And further deposes and says that:

Sworn to and subscribed before me this 21 day of July, 1951.

My commission expires  
July 23, 1956

*John J. Murphy*  
*Charles A. Shivers*  
John J. Murphy  
Charles A. Shivers

Form No. 111-1-51