



New Location  
 Gas Trap  
 Abandonment

Map No. 10 20 40 60 80 100 120 140

Company WOLF AIRWAYS GAS CO  
 Address CHARLESTON W.V.  
 From ALPHUS MORRIS TRACT  
 Year Area 2 Lease No. 61970  
 Well (Farm) No. \_\_\_\_\_ Serial No. 2000  
 Elevation (Spot Level) 1700'  
 Gridrange BEAVERSVILLE  
 County WHEELING  
 Engineer W.B. BARRACKMAN

STATE OF WEST VIRGINIA  
 DEPARTMENT OF MINES  
 OIL AND GAS DIVISION  
 CHARLESTON

**WELL LOCATION MAP**  
 FILE NO. WAM-504-2

† Denotes location of well on United States  
 Topographic Maps, scale 1 to 62,500, latitude  
 and longitude lines being represented by  
 border lines as shown.

75 +

LATITUDE 39°40'00"

88°02'30"

LONGITUDE

7'5 OGIS topo location

7.5' loc  $\frac{0.075}{1.73W}$

15' loc  $\frac{0.075}{3.45W}$   
(calc.)

Company \_\_\_\_\_

Farm \_\_\_\_\_

Quad Bunge (Bv/ke EC)

County Monongahela

District Cass

WELL LOCATION MAP

File No. 061-504A

A. MORRIS HEINS NO. 9579 WELL.

Cass District, Monongalia County, W. Va.  
By Hope Natural Gas Co., 445 W. Main St., Clarksburg, W. Va.  
Abandoned under permit Mon-.....-A?  
On 146 acres.  
Elevation, 1142' L.  
Drilling completed about 1902.  
No record of water.  
10", 8", and 6" casing, pulled; 5", 1650'; 2" tubing, 2386'.  
Casing not cemented.  
No record of coal.  
Gas well. Record to Dept. of Mines dated June 14, 1951.  
Record to RCT from Mrs. Griffith Aug. 27, 1951. Old File No. 555.

	Top.	Bottom.
NO LOG OF WELL.		
Big Injun Sand (light gas, 1850')	....	....
Fifty-foot Sand (gas, 2270 and 2323')	....	....
Total depth		2386



STATE OF WEST VIRGINIA  
DEPARTMENT OF MINES  
OIL AND GAS DIVISION

504

WELL RECORD

Permit No. MON-504-A

~~Oil~~ Oil or Gas Well  
(KIND)


Company Hope Natural Gas Company.  
 Address 445 West Main St. Clarksburg, W. Va.  
 Farm A. Morris Hrs. Acres 146  
 Location (waters) \_\_\_\_\_  
 Well No. 9579 Elev. 1142  
 District Cass County Monongalia.  
 The surface of tract is owned in fee by \_\_\_\_\_  
 Address \_\_\_\_\_  
 Mineral rights are owned by \_\_\_\_\_  
 Address \_\_\_\_\_  
 Drilling commenced \_\_\_\_\_  
 Drilling completed about 1902  
 Date Shot \_\_\_\_\_ From \_\_\_\_\_ To \_\_\_\_\_  
 With \_\_\_\_\_  
 Open Flow \_\_\_\_\_ /10ths Water in \_\_\_\_\_ Inch  
 \_\_\_\_\_ /10ths Merc. in \_\_\_\_\_ Inch  
 Volume \_\_\_\_\_ Cu. Ft.  
 Rock Pressure \_\_\_\_\_ lbs. \_\_\_\_\_ hrs.  
 Oil \_\_\_\_\_ bbls., 1st 24 hrs.  
 Fresh water no record feet \_\_\_\_\_ feet  
 Salt water no record feet \_\_\_\_\_ feet

Casing and Tubing	Used in Drilling	Left in Well	Packers
Size			
16			Kind of Packer _____
13			
10		<b>Pulled</b>	Size of _____
8 1/4		<b>Pulled</b>	
6 5/8		<b>Pulled</b>	Depth set _____
5 3/16	<b>1650</b>	<b>1650</b>	
3			Perf. top _____
2	<b>2386</b>	<b>2386</b>	Perf. bottom _____
Liners Used			Perf. top _____
			Perf. bottom _____

**NOT**  
CASING CEMENTED \_\_\_\_\_ SIZE \_\_\_\_\_ No. Ft. \_\_\_\_\_ Date \_\_\_\_\_

**no records**  
COAL WAS ENCOUNTERED AT \_\_\_\_\_ FEET \_\_\_\_\_ INCHES  
 \_\_\_\_\_ FEET \_\_\_\_\_ INCHES FEET \_\_\_\_\_ INCHES  
 \_\_\_\_\_ FEET \_\_\_\_\_ INCHES FEET \_\_\_\_\_ INCHES

Formation	Color	Hard or Soft	Top	Bottom	Oil, Gas or Water	Depth Found	Remarks
No log of well							
Big Injun					light gas	1850	
Fifty foot					gas	2270	2323
Total depth				2386			

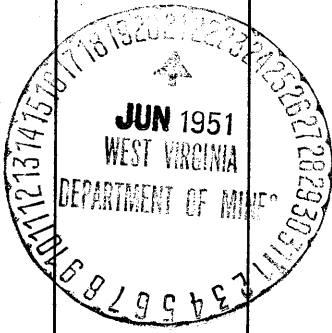

(Over)

AUG 27 1951



