

Map Sh 13 N 19631 PB 1011 P-36-36

Company Haps Natural Gas Co  
 Address Clarksburg W.Va.  
 Farm John Lough  
 Tract \_\_\_\_\_ Area 2.5 Lease No. 61866  
 Well (Farm) No. \_\_\_\_\_ Serial No. 2563  
 Elevation (Bench Level) 1272  
 Quadrange Blacksville  
 County Morganella District Grant


STATE OF WEST VIRGINIA  
 DEPARTMENT OF MINES  
 OIL AND GAS DIVISION  
 CHARLESTON

**WELL LOCATION MAP**  
 FILE NO. MAN-506-2

+ Denotes location of well on United States  
 Tennessee 11 zone, scale 1 to 62,500, lat.

LATITUDE 39°40'00"

LONGITUDE 80°02'30"

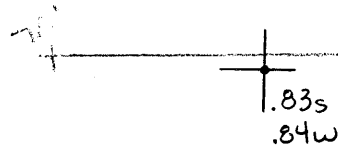

7'5 OGIS topo location

7.5' loc	<del>0.815</del>	15' loc	0.815
	<del>1.264</del>	(calc.)	3.486

Company \_\_\_\_\_

Farm \_\_\_\_\_

Quad OSAGE (Bulle EC)

County Monongahela

District Cass

WELL LOCATION MAP

File No. 061-506A

JOHN LOUGH NO. 9563 (MD-263) WELL.

Cass District, Monongalia County, W. Va.  
 By Hope Natural Gas Co., 445 W. Main St., Clarksburg, W. Va.  
 Abandoned under permit Mon-..... -A?

On 25 acres.

Elevation, 1272' L.

Drilling commenced June 19, 1916; completed Aug. 30, 1916.

Salt water at 1530'.

10" casing, 534' (pulled); 8", 1350' (pulled); 6", 1759'; 2" tubing, 1786'

Casing not cemented.

Coal was encountered at 430-435 and 515-525'.

One well. Record to Dept. of Mines dated July 7, 1951.

Record to RCT from Mrs. Griffith Aug. 27, 1951. Old File No. 554.

	Top.	Bottom.
Mapletown (Sewickley) Coal	430	435
Pittsburgh Coal	515	525
Gas Sand (show gas, 1210')	1207	1325
First Salt Sand	1349	1411
Second Salt Sand (water, 1530')	1440	1500
Little Lime	1715	1730
Pencil Cove	1730	1754
Big Lime	1754	1835
Big Injan Sand (gas, 1921 and 1965')	1850	1970
Total depth		2018



504

STATE OF WEST VIRGINIA  
DEPARTMENT OF MINES  
OIL AND GAS DIVISION

WELL RECORD

Permit No. MOW-506-A


Oil Gas Well (KIND)

Company Hope Natural Gas Company.  
 Address 445 West Main St. Clarksburg, W. Va.  
 Farm John Lough. Acres 25  
 Location (waters) \_\_\_\_\_  
 Well No. 9563. M.P. 263 Elev. 1272  
 District Cass, County Monongalia.  
 The surface of tract is owned in fee by \_\_\_\_\_  
 Address \_\_\_\_\_  
 Mineral rights are owned by \_\_\_\_\_  
 Address \_\_\_\_\_  
 Drilling commenced June 19, 1916  
 Drilling completed August 30, 1916  
 Date Shot \_\_\_\_\_ From \_\_\_\_\_ To \_\_\_\_\_  
 With \_\_\_\_\_  
 Open Flow \_\_\_\_\_ /10ths Water in \_\_\_\_\_ Inch  
 \_\_\_\_\_ /10ths Merc. in \_\_\_\_\_ Inch  
 Volume \_\_\_\_\_ Cu. Ft.  
 Rock Pressure \_\_\_\_\_ lbs. \_\_\_\_\_ hrs.  
 Oil \_\_\_\_\_ bbls., 1st 24 hrs.  
 Fresh water \_\_\_\_\_ feet \_\_\_\_\_ feet  
 Salt water 1530 feet \_\_\_\_\_ feet

Casing and Tubing	Used in Drilling	Left in Well	Packers
Size			
16			Kind of Packer
13			
10	<u>534</u>	<u>Pulled</u>	Size of
8 1/4	<u>1390</u>	<u>Pulled</u>	
6 5/8	<u>1759</u>	<u>1759</u>	Depth set
5 3/16			
3			Perf. top
2	<u>1786</u>	<u>1786</u>	Perf. bottom
Liners Used			Perf. top
			Perf. bottom

CASING CEMENTED NOT SIZE \_\_\_\_\_ No. Ft. \_\_\_\_\_ Date \_\_\_\_\_  
 COAL WAS ENCOUNTERED AT 430 FEET 60 INCHES  
515 FEET 120 INCHES FEET INCHES  
 FEET INCHES FEET INCHES

Formation	Color	Hard or Soft	Top	Bottom	Oil, Gas or Water	Depth Found	Remarks
Mapleton Coal			430	435			
Pittsburgh Coal			515	525			
Gas sand			1207	1325	show gas	1210	
First Salt			1349	1411			
Second Salt			1440	1500	water	1530	
Little Lime			1715	1730			
Pencil cave			1730	1754			
Big Lime			1754	1835			
Big Injun			1850	1970	gas	1921 1965	
Total depth				2018			

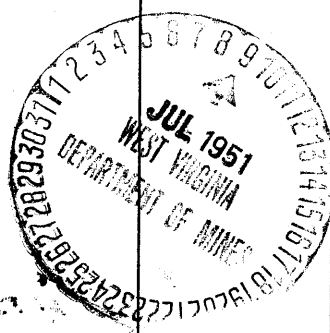

(Over)

AUG 27 1951

Formation	Color	Hard or Soft	Top	Bottom	Oil, Gas or Water	Depth Found	Remarks

Date **July 7, 1951.**

\_\_\_\_\_, 19\_\_\_\_

**Hope Natural Gas Company.**

APPROVED \_\_\_\_\_, Owner

By \_\_\_\_\_

(Title) *[Signature]*

STATE OF WEST VIRGINIA  
DEPARTMENT OF MINES  
OIL AND GAS DIVISION

## AFFIDAVIT OF PLUGGING AND FILLING WELL

AFFIDAVIT SHOULD BE MADE IN TRIPPLICATE, ONE COPY MAILED TO THE COMMISSIONER, ONE COPY TO BE RETURNED BY THE WELL OPERATOR AND THE THIRD COPY (AND SEVERAL COPIES IF REQUIRED) SHOULD BE MAILED TO EACH STATE OPERATOR AT THEIR RESPECTIVE OFFICES.

No coal operations \_\_\_\_\_ Hope Natural Gas Company,  
WELL OPERATOR OR OWNER  
ADDRESS \_\_\_\_\_ NAME OF WELL OPERATOR

\_\_\_\_\_ 116 West Main St., Clarksburg, W. Va.,  
COMPLETE ADDRESS

\_\_\_\_\_ WELL AND LOCATION IS \_\_\_\_\_

Christopher Cook Co. \_\_\_\_\_ Case, \_\_\_\_\_ District  
ADDRESS \_\_\_\_\_

Pennsylv. N. Co. \_\_\_\_\_ Monacaia, \_\_\_\_\_ County  
NAME OF COMPANY OWNER

\_\_\_\_\_ Well No. 9563 \_\_\_\_\_

\_\_\_\_\_ John Lough, \_\_\_\_\_ Firm  
ADDRESS \_\_\_\_\_

STATE ENGINEER SUPERVISING PLUGGING

## AFFIDAVIT

STATE OF WEST VIRGINIA

County of MonacaiaStephen A. Tootmanand John J. Murphy

being first duly sworn according to law depose and say that they are experienced in the work of plugging and filling oil and gas wells and were employed by Hope Natural Gas Company well operator, and participated in the work of plugging and filling the above well, that said work was completed on the 27th day of July, 1956, and that the well was plugged and filled in the following manner:

WELL OR WELL NUMBER	FILLED MATERIAL				PLUGGED DEPTH	GASING	
	AMOUNT	WEIGHT	MEAS.	NO.		WELL NO.	WELL NO.
2841's Prod. 150-455	Ammon	2675	1000				
Pop. Prod. 215-502	Ammon	1000	1000				
Old Prod. 1200-1500	Ammon	1000	1000	Surface			1500
1st. Well 1240-1411							
2nd. Well 1440-1500							1500
14441's Prod. 1210-1500	4 1/2" casing laid in well at top						1500
Pennsylv. Prod. 1220-1500	1000' cemented at 1500'						
Old Prod. 1220-1500	1000' and 1000'						
2nd Prod. 1440-1500							
Case 2272-455							
Total Ammon		2675					



and that the work of plugging and filling said well was completed on the 27th day of July, 1956

And further depose and say that

Sworn to and subscribed before me this 11

My Commission expires

July 28, 1956

Stephen A. Tootman  
John J. Murphy  
John Lough  
Firm