

Surface = N. Stevens, Cassville W.Va.
 Coal = Consol. Coal Co. Osage, W.Va.

New Location
 Drill Seeper
 Abandoned

Company Valley Steel Products Co
 Address St. Louis, Missouri
 Farm J. Postlewaite
 Tract 222 Acres 130 + Less or No.
 Well (Farm) No. 5 Serial No.
 Elevation (Split Level) 122'
 Quadrangle Blacksville
 County Monongalia District CRS
 Engineer A. L. Hendley
 Engineer's Registration No. 2021


STATE OF WEST VIRGINIA
 DEPARTMENT OF MINES
 OIL AND GAS DIVISION
 CHARLESTON

WELL LOCATION MAP
 FILE NO. MAN-534-B

✦ Denotes location of well on United States
 Topographic Maps, scale 1 to 62,500, lat-
 itude and longitude lines being represented
 by border lines as shown.

- Denotes one inch space on border line

Latitude

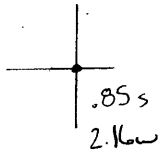

Longitude

Topo Location

7.5' Loc. _____ 15' Loc. _____
 _____ (calc.) _____

Company Washington

Farm J Postlewaite #S

15' Quad _____
(sec.)

7.5' Quad Osage

District Cass

WELL LOCATION PLAT

County 061 Permit 30534

J. POSTLEWAITE NO. 5 WELL.

Cass District, Monongalia County, W. Va.

By Washington Oil Co., Crothers, Pa.

Abandoned under permit Non-.....-A7

On 130 acres.

Elevation, 1284' L.

Date of completion not given.

6" casing, 1822'; 5" x 4-7/8", mixed, 1017'; 2" tubing, 38 jts.

Oil well. Record to Dept. of Mines stamped Nov. 12, 1951.

Record to RCT from Mrs. Griffith loc. 2, 1952. O.F.No.538.

	Top.	Bottom.
Pittsburgh Coal	765	- ...
Top of Big Injun Sand (gas at 2031'; oil pay, 2135')	2025	-
Total depth		2176



STATE OF WEST VIRGINIA
DEPARTMENT OF MINES
OIL AND GAS DIVISION

588

Permit No. MON-594-A **WELL RECORD**

Oil or Gas Well _____
(KIND)


Company Washington Oil Company
Address Crothers, Pa.
Farm J. Postlewaite Acres 130
Location (waters) _____
Well No. 5 Elev. 1284'
District Cass County Monongalia
The surface of tract is owned in fee by _____
Address _____
Mineral rights are owned by _____
Address _____
Drilling commenced _____
Drilling completed _____
Date Shot _____ From _____ To _____
With _____
Open Flow _____ /10ths Water in _____ Inch
_____ /10ths Merc. in _____ Inch
Volume _____ Cu. Ft.
Rock Pressure _____ lbs. _____ hrs.
Oil _____ bbls., 1st 24 hrs.
Fresh water _____ feet _____ feet
Salt water _____ feet _____ feet

Casing and Tubing	Used in Drilling	Left in Well	Packers
Size			
16			Kind of Packer
13			
10			Size of
8 1/4			
6 1/2	<u>1822'</u>	<u>1822'</u>	Depth set
5 3/16 & 4-7/8" mixed		<u>1017'</u>	
3			Perf. top
2	<u>38 jts.</u>		Perf. bottom
Liners Used			Perf. top
			Perf. bottom

CASING CEMENTED _____ SIZE _____ No. Ft. _____ Date _____

COAL WAS ENCOUNTERED AT _____ FEET _____ INCHES
_____ FEET _____ INCHES FEET _____ INCHES
_____ FEET _____ INCHES FEET _____ INCHES

Formation	Color	Hard or Soft	Top	Bottom	Oil, Gas or Water	Depth Found	Remarks
Pittsburgh Coal			765				
Top of Big Injun			2025	2025			
Gas at			2031				
Oil Pay			2135				
Total Depth			2176	2176			

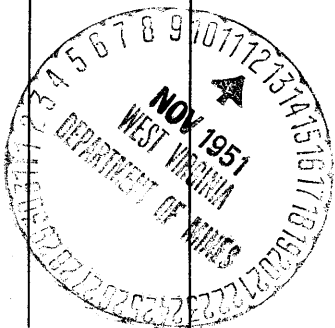

NOV 2 1952

AFFIDAVIT OF PLUGGING AND FILLING WELL

AFFIDAVIT SHOULD BE MADE IN TRIPPLICATE. ONE COPY MAILED TO THE DEPARTMENT, ONE COPY TO BE RETURNED BY THE WELL OPERATOR AND THE THIRD COPY (AND SEVERAL COPIES IF REQUIRED) SHOULD BE MAILED TO EACH LOCAL OPERATOR AT THEIR RESPECTIVE ADDRESSES.

Christopher Seal Co. Valley Steel Products Co.
WELL OPERATOR OR OWNER c/o Tappan-Dr-Connor
c/o George E. Floral Chief Engineer South Charleston, W. Va.
ADDRESS COMPLETE ADDRESS

P. O. Box 117, Parkersburg, W. Va. 19
WELL OPERATOR OR OWNER WELL AND LOCATION

Clay District
ADDRESS

Monongalia County
LEASER OR PROPERTY OWNER

Well No. 5
J. Postelwitz Farm
ADDRESS

D. F. Dozier, Fairview, W. Va.
STATE INSPECTOR SUPERVISING PLUGGING

AFFIDAVIT

STATE OF WEST VIRGINIA,
 County of Monongalia)
 vs:)

Homer G. Groves and Daten Davis
 being first duly sworn according to law depose and say that they are experienced in the art of
 plugging and filling oil and gas wells and were employed by Valley Steel Products Co.
 well operator, and participated in the work of plugging and filling the above well, that said
 work was commenced on the 31 day of March, 1952, and that the well was plugged
 and filled in the following manner:



DASH OR SHOT RECORD	FILLING MATERIAL		SIZE & KIND	GASING	
	DEPTH	FEET		SOO FEET	SOO LBS
	Clay	2005	1990	Tree top	
	Stone	1990	1980	2" tubing	2191
	Clay	1980	1850	5 1/8 pipe	1087
	Cement	1850	1835	4 7/8	780
	Stone	1835	1830	7" 80 pipe	862
	Clay	1830	1390		
	Cement	1390	1380		
	Stone	1380	1330		
	Clay	1330	1100		
	Cement	1100	1090		
	Stone	1090	1085		
	Clay	1085	800		
	Cement	800	600		
	Clay	600	000		
SOAL BEARS				DESCRIPTION OF INSTRUMENT	
INSTR.				Valley Steel Products Co.	
INSTR.				J. Postelwitz #5	
INSTR.				1/31 ss 4/10/52	

and that the work of plugging and filling said well was completed on the 10 day of April, 1952.

And further deponents saith not.

Sworn to and subscribed before me this 17 day of April, 1952.

My commission expires:

Dec 16, 1952

Homer G. Groves
Daten Davis
Richard C. ...
 Notary Public

Permit No. 1121-534