


Latitude 39° 45'

5.68 S
3.61 W

Longitude 80° 20'

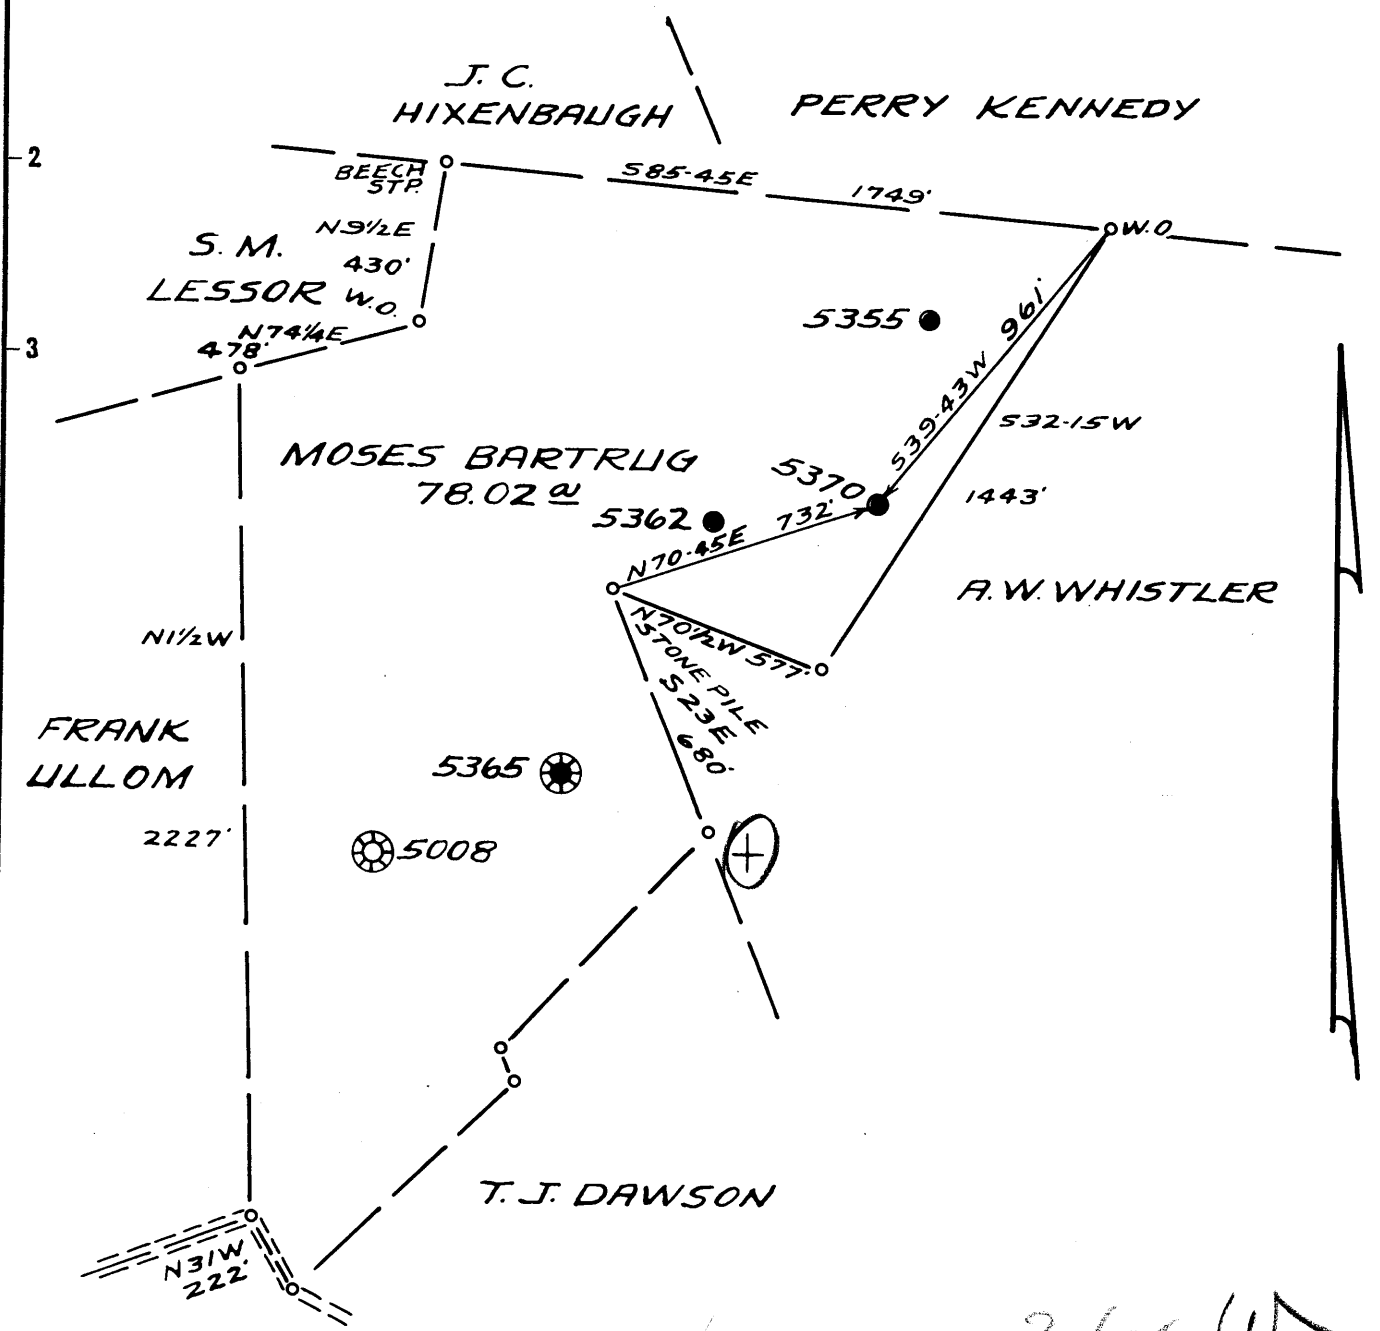

3.62 W
5.77 S

COAL-WHEELING DOLLAR SAVING & TRUST CO.
% BERNARD G. SAMPSON
BOX 368, FAIRMONT, W.VA.

NOV 22 1954

New Location...
Drill Deeper...
Abandonment...

Company WILLIAM MOSES
 Address SALEM, W.VA.
 Farm MOSES BARTRUG
 Tract _____ Acres 78.02 Lease No. _____
 Well (Farm) No. 6 Serial No. 5370
 Elevation (Spirit Level) 1470' L.
 Quadrangle MANNINGTON, N.W. 42
 County MONONGALIA District BATTELLE
 Engineer JAMES D. EFFNER
 Engineer's Registration No. 1084
 File No. _____ Drawing No. _____
 Date OCT. 20, 1954 Scale 1" = 500'

STATE OF WEST VIRGINIA
 DEPARTMENT OF MINES
 OIL AND GAS DIVISION
 CHARLESTON

WELL LOCATION MAP
 FILE NO. MON-583-A

+ Denotes location of well on United States Topographic Maps, scale 1 to 62,500, latitude and longitude lines being represented by border lines as shown.

- Denotes one inch spaces on border line of original tracing.



STATE OF WEST VIRGINIA
DEPARTMENT OF MINES
OIL AND GAS DIVISION

691

Permit No. 5824

WELL RECORD

Oil or Gas Well OIL
(KIND)

Company William Moses
Address Salers, W. Va.
Farm Moses Bartrug Acres 78.02
Location (waters) _____
Well No. 5370 Elev. 1470
District Battelle County Monongalia
The surface of tract is owned in fee by _____


Casing and Tubing	Used in Drilling	Left in Well	Packers
Size			
16			Kind of Packer
13			
10		265	Size of
		1768	
		2521	Depth set
			Perf. top
			Perf. bottom
			Perf. top
			Perf. bottom

Mineral rights are owned by Wheeling Savings Fund Co
C/O Mr. Bernard N. Hampton, Address Fairmont, W. Va. P.O. Box 368

Drilling commenced _____
Drilling completed _____
Date Shot _____ From _____ To _____
With _____
Open Flow _____ /10ths Water in _____ Inch
_____ /10ths Merc. in _____ Inch
Volume _____ Cu. Ft.
Rock Pressure _____ lbs. _____ hrs.
Oil _____ bbls., 1st 24 hrs.
Fresh water _____ feet _____ feet
Salt water _____ feet _____ feet

CASING CEMENTED _____ SIZE _____ No. Ft. _____ Dat _____
COAL WAS ENCOUNTERED AT _____ FEET _____ INCHES
_____ FEET _____ INCHES FEET _____ INCHES
_____ FEET _____ INCHES FEET _____ INCHES

Formation	Color	Hard or Soft	Top	Bottom	Oil, Gas or Water	Depth Found	Remarks
Pittsburg Coal			1280	1288			
Little Dunkard			1655	1685			
Big Dunkard			1755	1870			
1st SAKT			2115	2175			
2nd "			2240	2317			
L. Lime			2465	2480			
B. Lime			2485	2565			
B. Injun			2565	2780			
Fifty Foot			3215	3290			
Thirty Foot			3311	3350			
Total depth			3352				

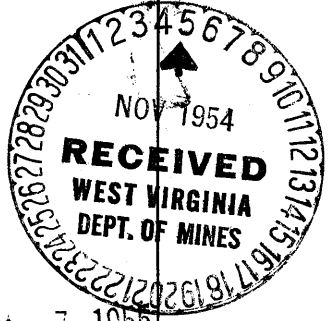

JAN 7 1955