


Latitude 39° 40'

Longitude 80° 05'

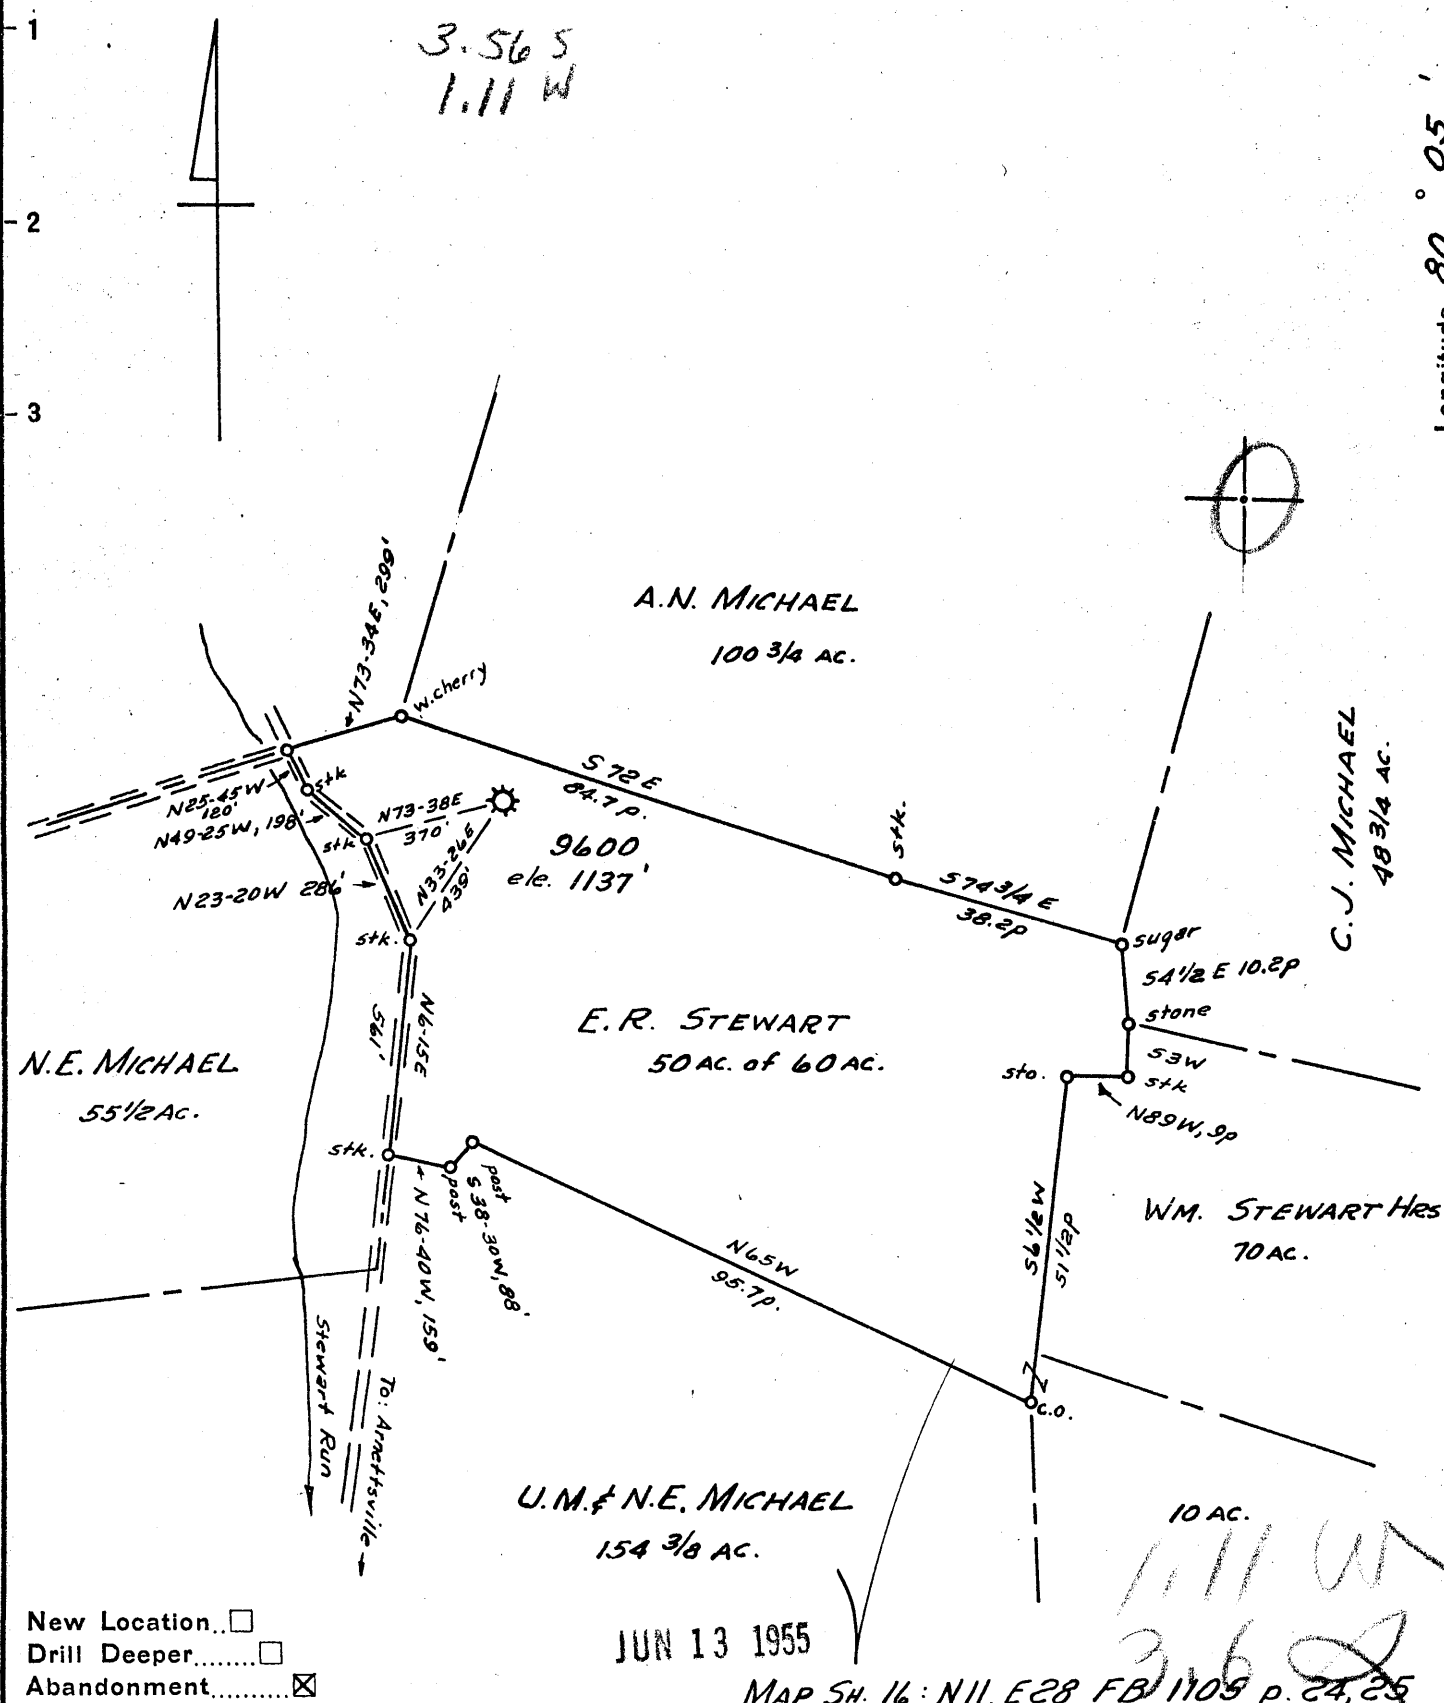

- New Location...
- Drill Deeper.....
- Abandonment.....

JUN 13 1955

MAP SH. 16: N11, E28 FB 1109 p. 24, 25

Company HOPE NATURAL GAS CO.
 Address CLARKSBURG, W. VA.
 Farm E. R. STEWART
 Tract _____ Acres 60 Lease No. 61900
 Well (Farm) No. _____ Serial No. 9600
 Elevation (Spirit Level) 1137'
 Quadrangle BLACKSVILLE
 County MONONGALIA District GRANT
 Engineer Guy A. Bradley
 Engineer's Registration No. 2425
 File No. _____ Drawing No. _____
 Date MAY 20, 1955 Scale 1" = 30p.

STATE OF WEST VIRGINIA
 DEPARTMENT OF MINES
 OIL AND GAS DIVISION
 CHARLESTON

WELL LOCATION MAP
 FILE NO. MON-589-A

+ Denotes location of well on United States Topographic Maps, scale 1 to 62,500, latitude and longitude lines being represented by border lines as shown.

- Denotes one inch spaces on border line of original tracing.

Plugged 6/9/55



637

STATE OF WEST VIRGINIA
DEPARTMENT OF MINES
OIL AND GAS DIVISION

WELL RECORD

Quadrangle Blacksville

Permit No. 589-A

Oil or Gas Well Gas

(KIND)

Company Hope Natural Gas Company
 Address 445 West Main St., Clarksburg, W. Va.
 Farm E. R. Stewatt Acres 60
 Location (waters) _____
 Well No. 9600 Elev. 1137'
 District Grant County Monongalia
 The surface of tract is owned in fee by _____
 Address _____
 Mineral rights are owned by _____
 Address _____
 Drilling commenced 12/13
 Drilling completed 4-14
 Date Shot No Record From _____ To _____
 With _____
 Open Flow _____ /10ths Water in _____ Inch
 _____ /10ths Merc. in _____ Inch
 Volume exhausted Cu. Ft.
 Rock Pressure _____ lbs. _____ hrs.
 Oil None bbls., 1st 24 hrs.
 Fresh water None recorded feet _____ feet
 Salt water do feet _____ feet


Casing and Tubing	Used in Drilling	Left in Well	Packers
Size			
16			Kind of Packer _____
13			Size of _____
10			Depth set _____
8 3/4	<u>1411</u>	<u>1411</u>	Perf. top _____
6 5/8	<u>1731</u>	<u>1731</u>	Perf. bottom _____
5 3/16			Perf. top _____
3			Perf. bottom _____
2	<u>1922</u>	<u>1922</u>	Perf. top _____
Liners Used			Perf. bottom _____

CASING CEMENTED _____ SIZE _____ No. Ft. _____ Date _____

No Cementing

COAL WAS ENCOUNTERED AT 385 FEET 72 INCHES
465 FEET 132 INCHES FEET INCHES
 FEET INCHES FEET INCHES

Formation	Color	Hard or Soft	Top	Bottom	Oil, Gas or Water	Depth Found	Remarks
Surface			0	15			
Coal			385	391			
Pittsburgh Coal			465	476			
Big Dunkard			1055	1077			
Gas Sand			1100	1148			
1st. Salt			1220	1270	Gas	1257	
2nd Salt			1283	1310			
Big Lime			1692	1788			
Big Injun			1788	1922	Gas	1794 & 1856	
Depth				1922'			

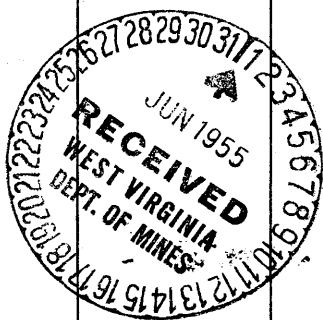

AUG 12 1955

Formation	Color	Hard or Soft	Top	Bottom	Oil, Gas or Water	Depth Found	Remarks

Date May 27, _____, 19 55

APPROVED Hope Natural Gas Company, Owner

By _____ (Title)

Barley