

COAL OWNED BY _____

NEW LOCATION.....

DRILL DEEPER.....

ABANDONMENT.....

FEB. 11. 1957

COMPANY	THE PRESTON OIL COMPANY		
ADDRESS	8 E. LONG ST. COLUMBUS, OHIO		
FARM	W. KINNEY		
TRACT	ACRES	LEASE NO.	
	310	2908	
WELL (FARM) NO.	7	SERIAL NO.	1193
ELEVATION (SPIRIT LEVEL)	1365'		
QUADRANGLE	MANNINGTON		
COUNTY	DISTRICT		
MONONGALIA	BATTELLE		
ENGINEER	Robert McNeill [G.E.A.]		
ENGINEER'S REGISTRATION NO.	361-E		
FILE NO.	DRAWING NO. Y-15-423		
DATE	12 DEC, 1956		
	SCALE 1" = 500'		

STATE OF WEST VIRGINIA
DEPARTMENT OF MINES
OIL AND GAS DIVISION
CHARLESTON

WELL LOCATION MAP

FILE NO. MON-608-A

+ DENOTES LOCATION OF WELL ON UNITED STATES TOPOGRAPHIC MAPS, SCALE 1 TO 62,500, LATITUDE AND LONGITUDE LINES BEING REPRESENTED BY BORDER LINES AS SHOWN.

- DENOTES ONE INCH SPACES ON BORDER LINE OF ORIGINAL TRACING.

W. KINNEY No. 7 (4587 / 1193) - PRESTON OIL Co., - MON-608-A



653

STATE OF WEST VIRGINIA
DEPARTMENT OF MINES
OIL AND GAS DIVISION

WELL RECORD

Quadrangle Mannington
Permit No. 608-A

Oil or Gas Well Gas
(KIND)


Company THE PRESTON OIL COMPANY
Address 8 E. LONG ST., COLUMBUS, OHIO
Farm W. Kinney Acres 310
Location (waters) _____
Well No. U-587 (1193) Elev. 1365'
District Battelle County Monongalia
The surface of tract is owned in fee by _____
Address _____
Mineral rights are owned by _____
Address _____
Drilling commenced April 28, 1909
Drilling completed July 10, 1909
Date Shot _____ From _____ To _____
With _____
Open Flow _____ /10ths Water in _____ Inch
_____ /10ths Merc. in _____ Inch
Volume _____ Cu. Ft.
Rock Pressure _____ lbs. _____ hrs.
Oil _____ bbls., 1st 24 hrs.
Fresh water _____ feet _____ feet
Salt water _____ feet _____ feet

Casing and Tubing	Used in Drilling	Left in Well	Packers
Size			
16			Kind of Packer
13			
10	267		Size of
8 1/4	1596		
6 5/8	2462	2462	Depth set
5 3/16	2608	2608	
3			Perf. top
2			Perf. bottom
Liners Used			Perf. top
			Perf. bottom

CASING CEMENTED _____ SIZE _____ No. Ft. _____ Date _____

COAL WAS ENCOUNTERED AT 850 FEET _____ INCHES
1212 FEET _____ INCHES FEET _____ INCHES
_____ FEET _____ INCHES FEET _____ INCHES

Formation	Color	Hard or Soft	Top	Bottom	Oil, Gas or Water	Depth Found	Remarks	
Waynesburg Coal			850	855				
Pittsburgh Coal			1212	1220				
Big Dunkard			1720	1760				
Gas Sand			1920	1990				
Salt Sand			2090	2185				
Little Lime			2400	2412				
Pencil Cave			2412	2420				
Big Lime			2420	2495				
Big Injun Sand			2495	2675				
50 ft. Sand			3140	3264		show of oil at 3155. 1/2 Bbl per day		
Campbells Run sand			3357	3385		oil at 3454. & filled up 3000' in 18m		
4th Sand			3448	3475 1/2				
Total Depth			3475 1/2					
			DRILLED DEEPER					
Bottom 4th sand				3510		Well cleaned out & shot Aug. 1913 with 30 qts.		
Slate & Shells			3510	3590				
5th Sand			3590	3600	Well shot Mar. 31, with 30 qts. Top 3452 1/2. Bottom 3460 1/2 in creased pro			
Slate & Shells			3600	3765	from 7 Bbls. to 12 Bbls. per week.			
Bottom - DRY HOLE				3765				

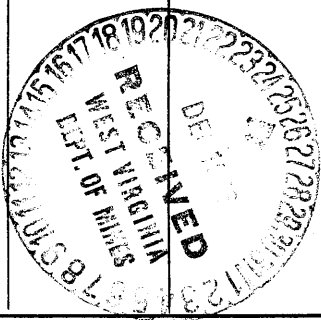

(Over)

JUN 20 1957

Formation	Color	Hard or Soft	Top	Bottom	Oil, Gas or Water	Depth Found	Remarks

Date December 20, 1956

APPROVED THE PRESTON OIL COMPANY, Owner

By Walter A. Preston
 (Title) XXX LAND AGENT