


Latitude 39° 40'

Longitude 80° 15'

R. 23 S
-86 W

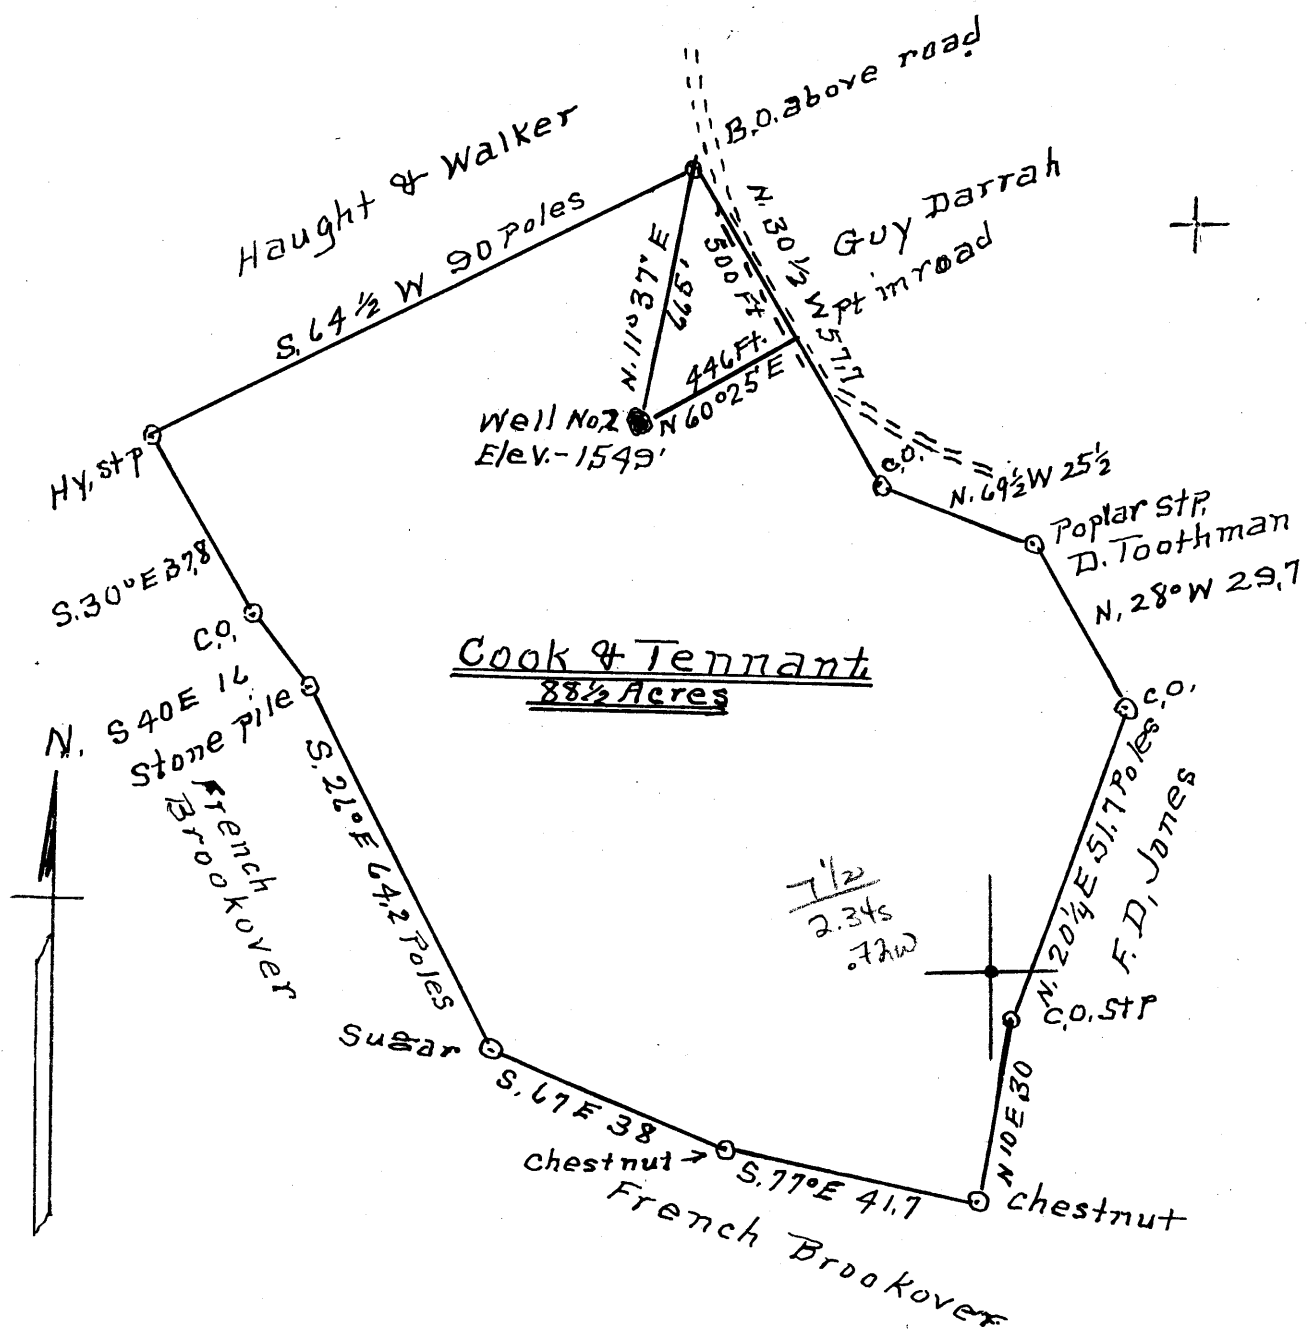

Surface = Furman Cook heirs
 c/o Kelly Cook
 R.F.D. Mt. Victory, Ohio
 Coal = Little Kanawha Synd.
 c/o Bernard G. Sampson
 Box 368 Fairmont, W. Va.

New Location
 Drill Deeper
 Abandonment

Company Cecil Chisler & Son
 Address R #2, Fairview, W. Va.
 Farm Cook & Tennant
 Tract 1 Acres 88 1/2 Lease No. _____
 Well (Farm) No. 2 Serial No. _____
 Elevation (Spirit Level) 1549'
 Quadrangle Mannington
 County Monongalia District Battelle
 Engineer N. L. Headley
 Engineer's Registration No. 2021
 File No. _____ Drawing No. _____
 Date 10-4-61 Scale 1" = 30 Poles

STATE OF WEST VIRGINIA
 DEPARTMENT OF MINES
 OIL AND GAS DIVISION
 CHARLESTON

WELL LOCATION MAP
 FILE NO. MON-650-A

+ Denotes location of well on United States Topographic Maps, scale 1 to 62,500, latitude and longitude lines being represented by border lines as shown.

- Denotes one inch spaces on border line of original tracing.